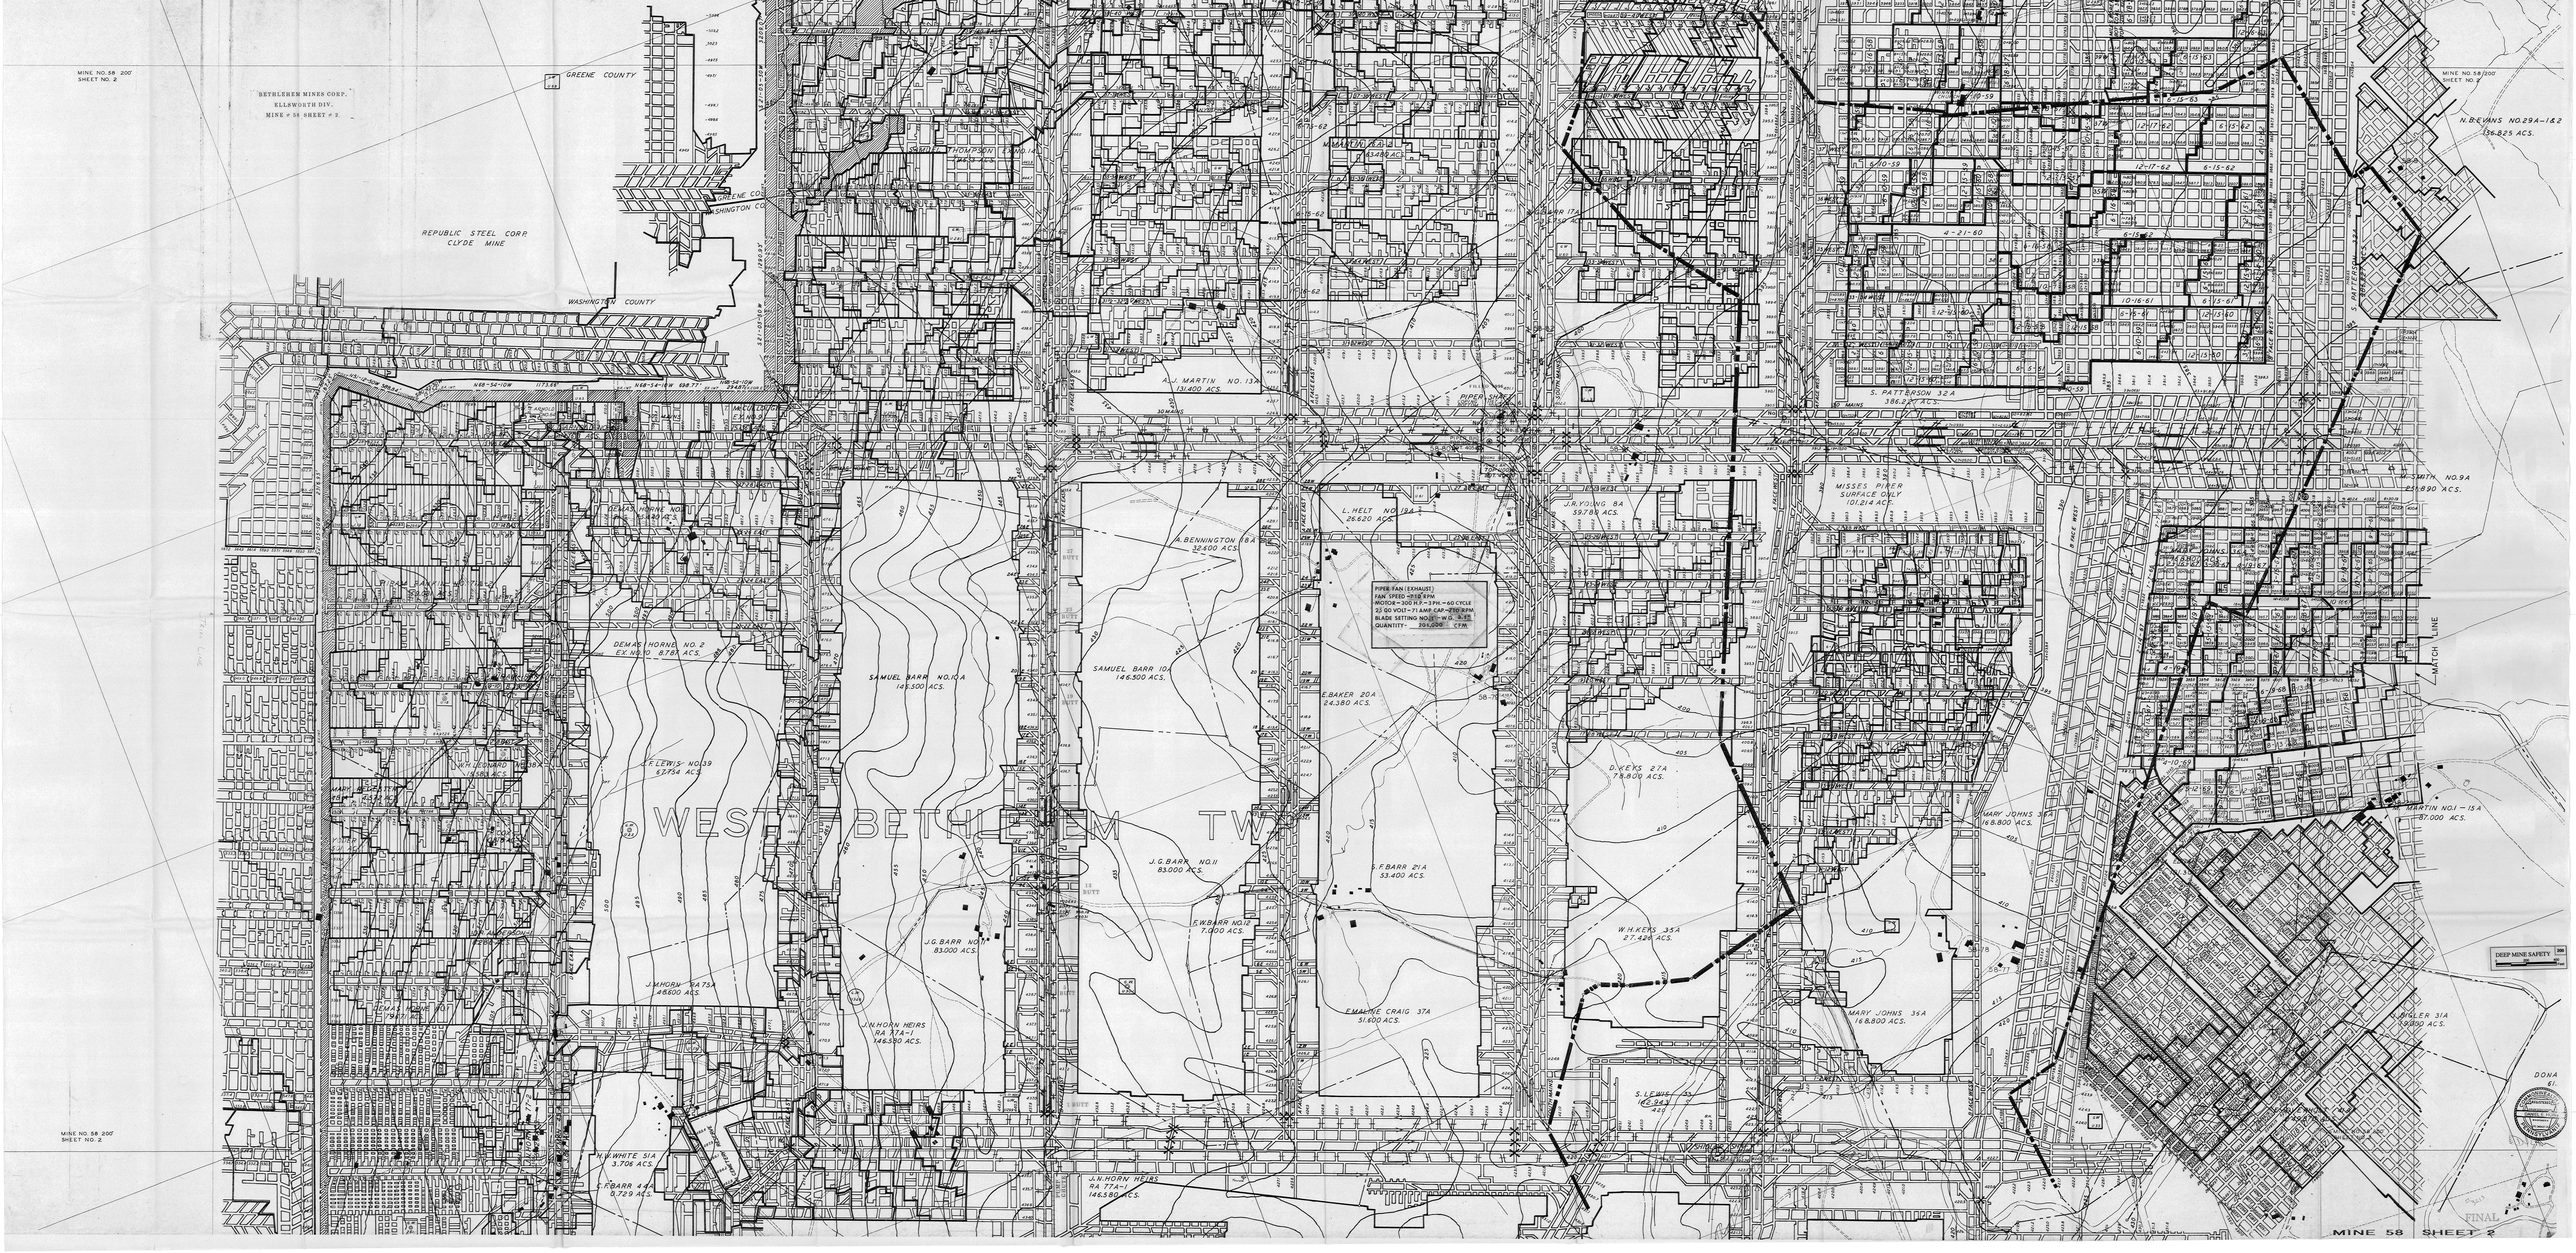
MINE NO. 58 200'
SHEET NO. 2
BETHLEHEM MINES CORP.
ELLSWORTH DIV.
MINE # 58 SHEET # 2
GREENE COUNTY
REPUBLIC STEEL CORP.
CLYDE MINE
WASHINGTON COUNTY
A.J. MARTIN NO. 13A
131.400 ACS.
S. PATTERSON 32A
386.227 ACS.
N.B. EVANS NO. 29A-1&2
136.825 ACS.
MISSES PIPER
SURFACE ONLY
101.214 ACS.
L. HELT NO. 19A
26.620 ACS.
J.R. YOUNG 8A
59.780 ACS.
A. BENNINGTON 18A
32.600 ACS.
PIPER FAN (EXHAUST)
FAN SPEED - 215 RPM
MOTOR - 300 H.P. - 3 PH. - 60 CYCLE
23 000 VOLT - 71 AMP. CAP. - 270 RPM
BLADE SETTING NO. 11 - W.G. 8.25
QUANTITY - 201,000 CFM
DEMAS HORNE NO. 2
EX. NO. 10 8.787 ACS.
SAMUEL BARR NO. 10A
146.500 ACS.
SAMUEL BARR 10A
146.500 ACS.
E. BAKER 20A
24.380 ACS.
C. F. LEWIS NO. 39
67.754 ACS.
WEST BETHLEHEM TWP.
J.G. BARR NO. 11
83.000 ACS.
S.F. BARR 21A
53.400 ACS.
D. KEYS 27A
78.800 ACS.
MARY JOHNS 36A
168.800 ACS.
MARTIN NO. 1 - 15A
87.000 ACS.
J.G. BARR NO. 11
83.000 ACS.
F.W. BARR NO. 12
7.000 ACS.
W.H. KEYS 35A
27.426 ACS.
J.M. HORN RA 75A
48.600 ACS.
J.N. HORN HEIRS
RA 77A-1
146.580 ACS.
EMALINE CRAIG 37A
51.600 ACS.
MARY JOHNS 36A
168.800 ACS.
DEEP MINE SAFETY
DONA
61.
H.W. WHITE 51A
3.706 ACS.
S.F. BARR 44A
0.729 ACS.
J.N. HORN HEIRS
RA 77A-1
146.580 ACS.
MATCH LINE
MINE 58 SHEET 2
FINAL