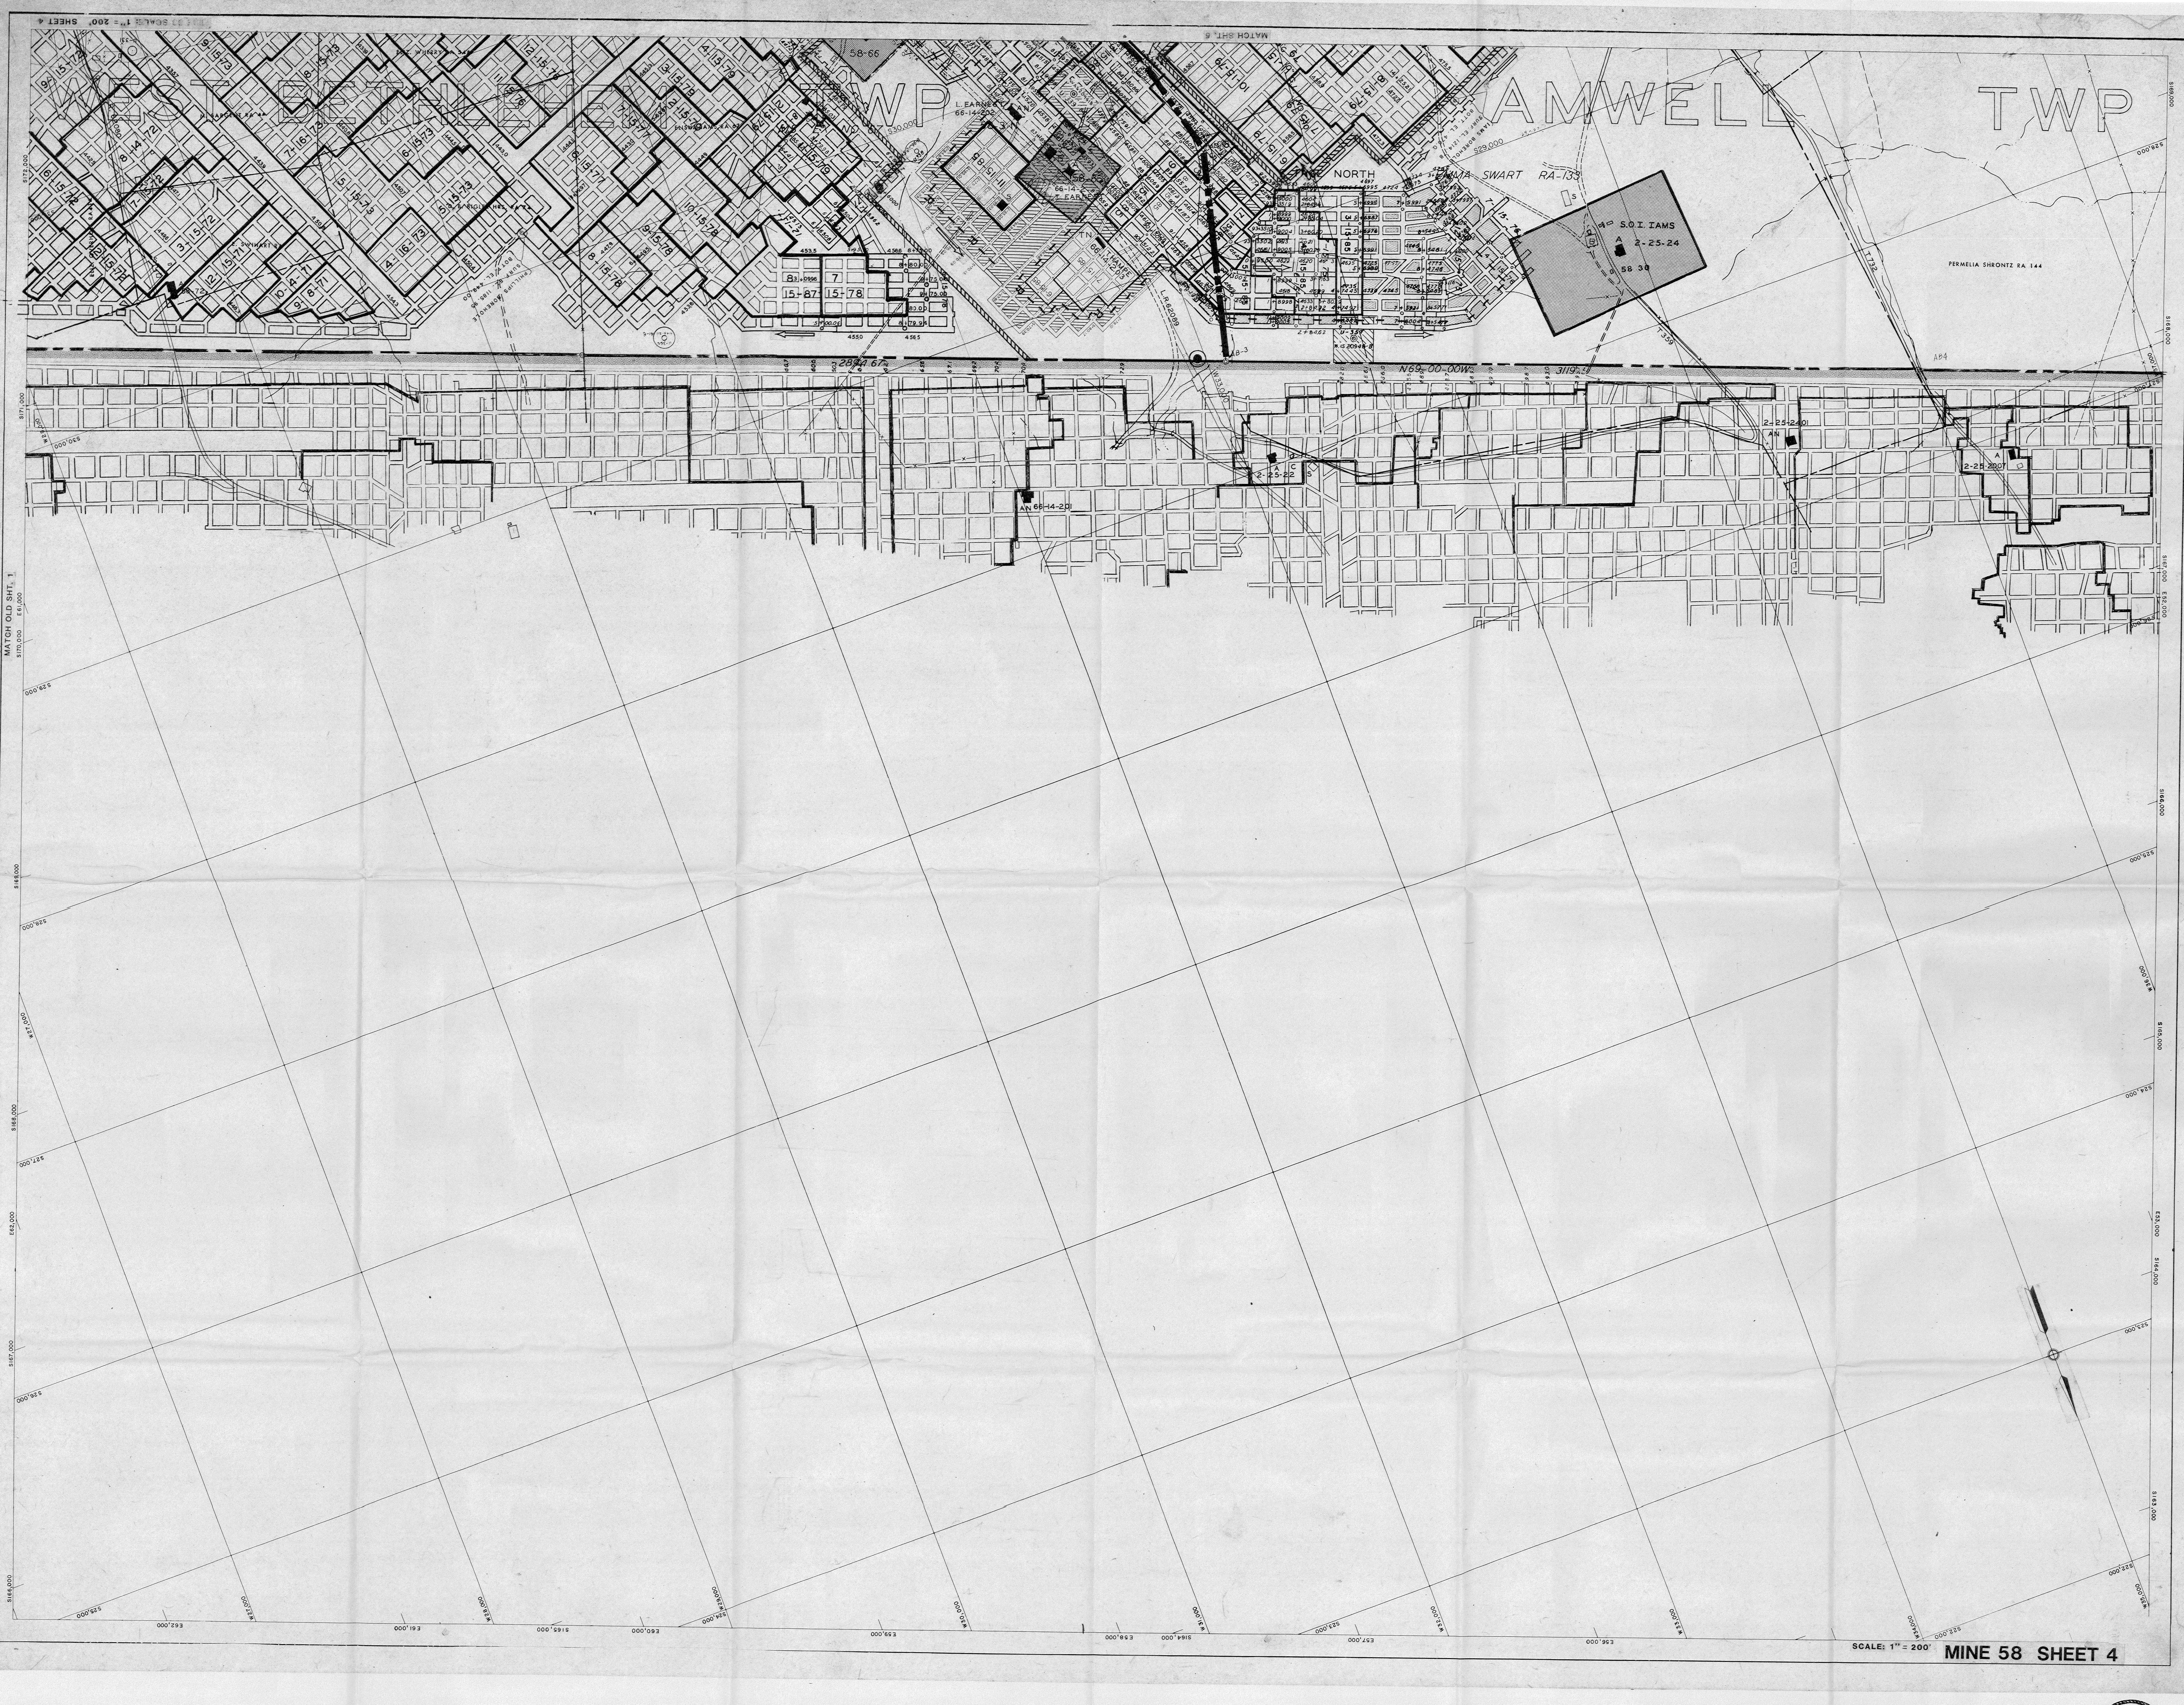
MATCH OLD SHT. 1
MATCH SHT. 6
WEST BETHLEHEM TWP
AMWELL TWP
L. EARNEST AN 66-14-202
58-66
66-14-2-8 T. EARNEST
TN 66-14-203 T. HAMPE
NORTH
EMMA SWART RA-133
S.O.I. IAMS
A 2-25-24
58 30
PERMELIA SHRONTZ RA 144
L.R. 62089
U-357
N69-00-00W
2894.67
3119.5
T359
T732
AB-3
AB4
AN 66-14-201
A C S 2-25-22
AN 2-25-2401
A 2-25-2007
S30,000
S29,000
S28,000
W33,000
W34,000
W35,000
W32,000
E56,000
S22,000

SCALE: 1" = 200'

MINE 58 SHEET 4

DEEP MINE SAFETY 200

0 200 400 Feet

COMMONWEALTH OF PENNSYLVANIA
REGISTERED PROFESSIONAL ENGINEER
DANIEL E. HORN
PE-040427-R

Dan E Horn

#3213

FINAL