


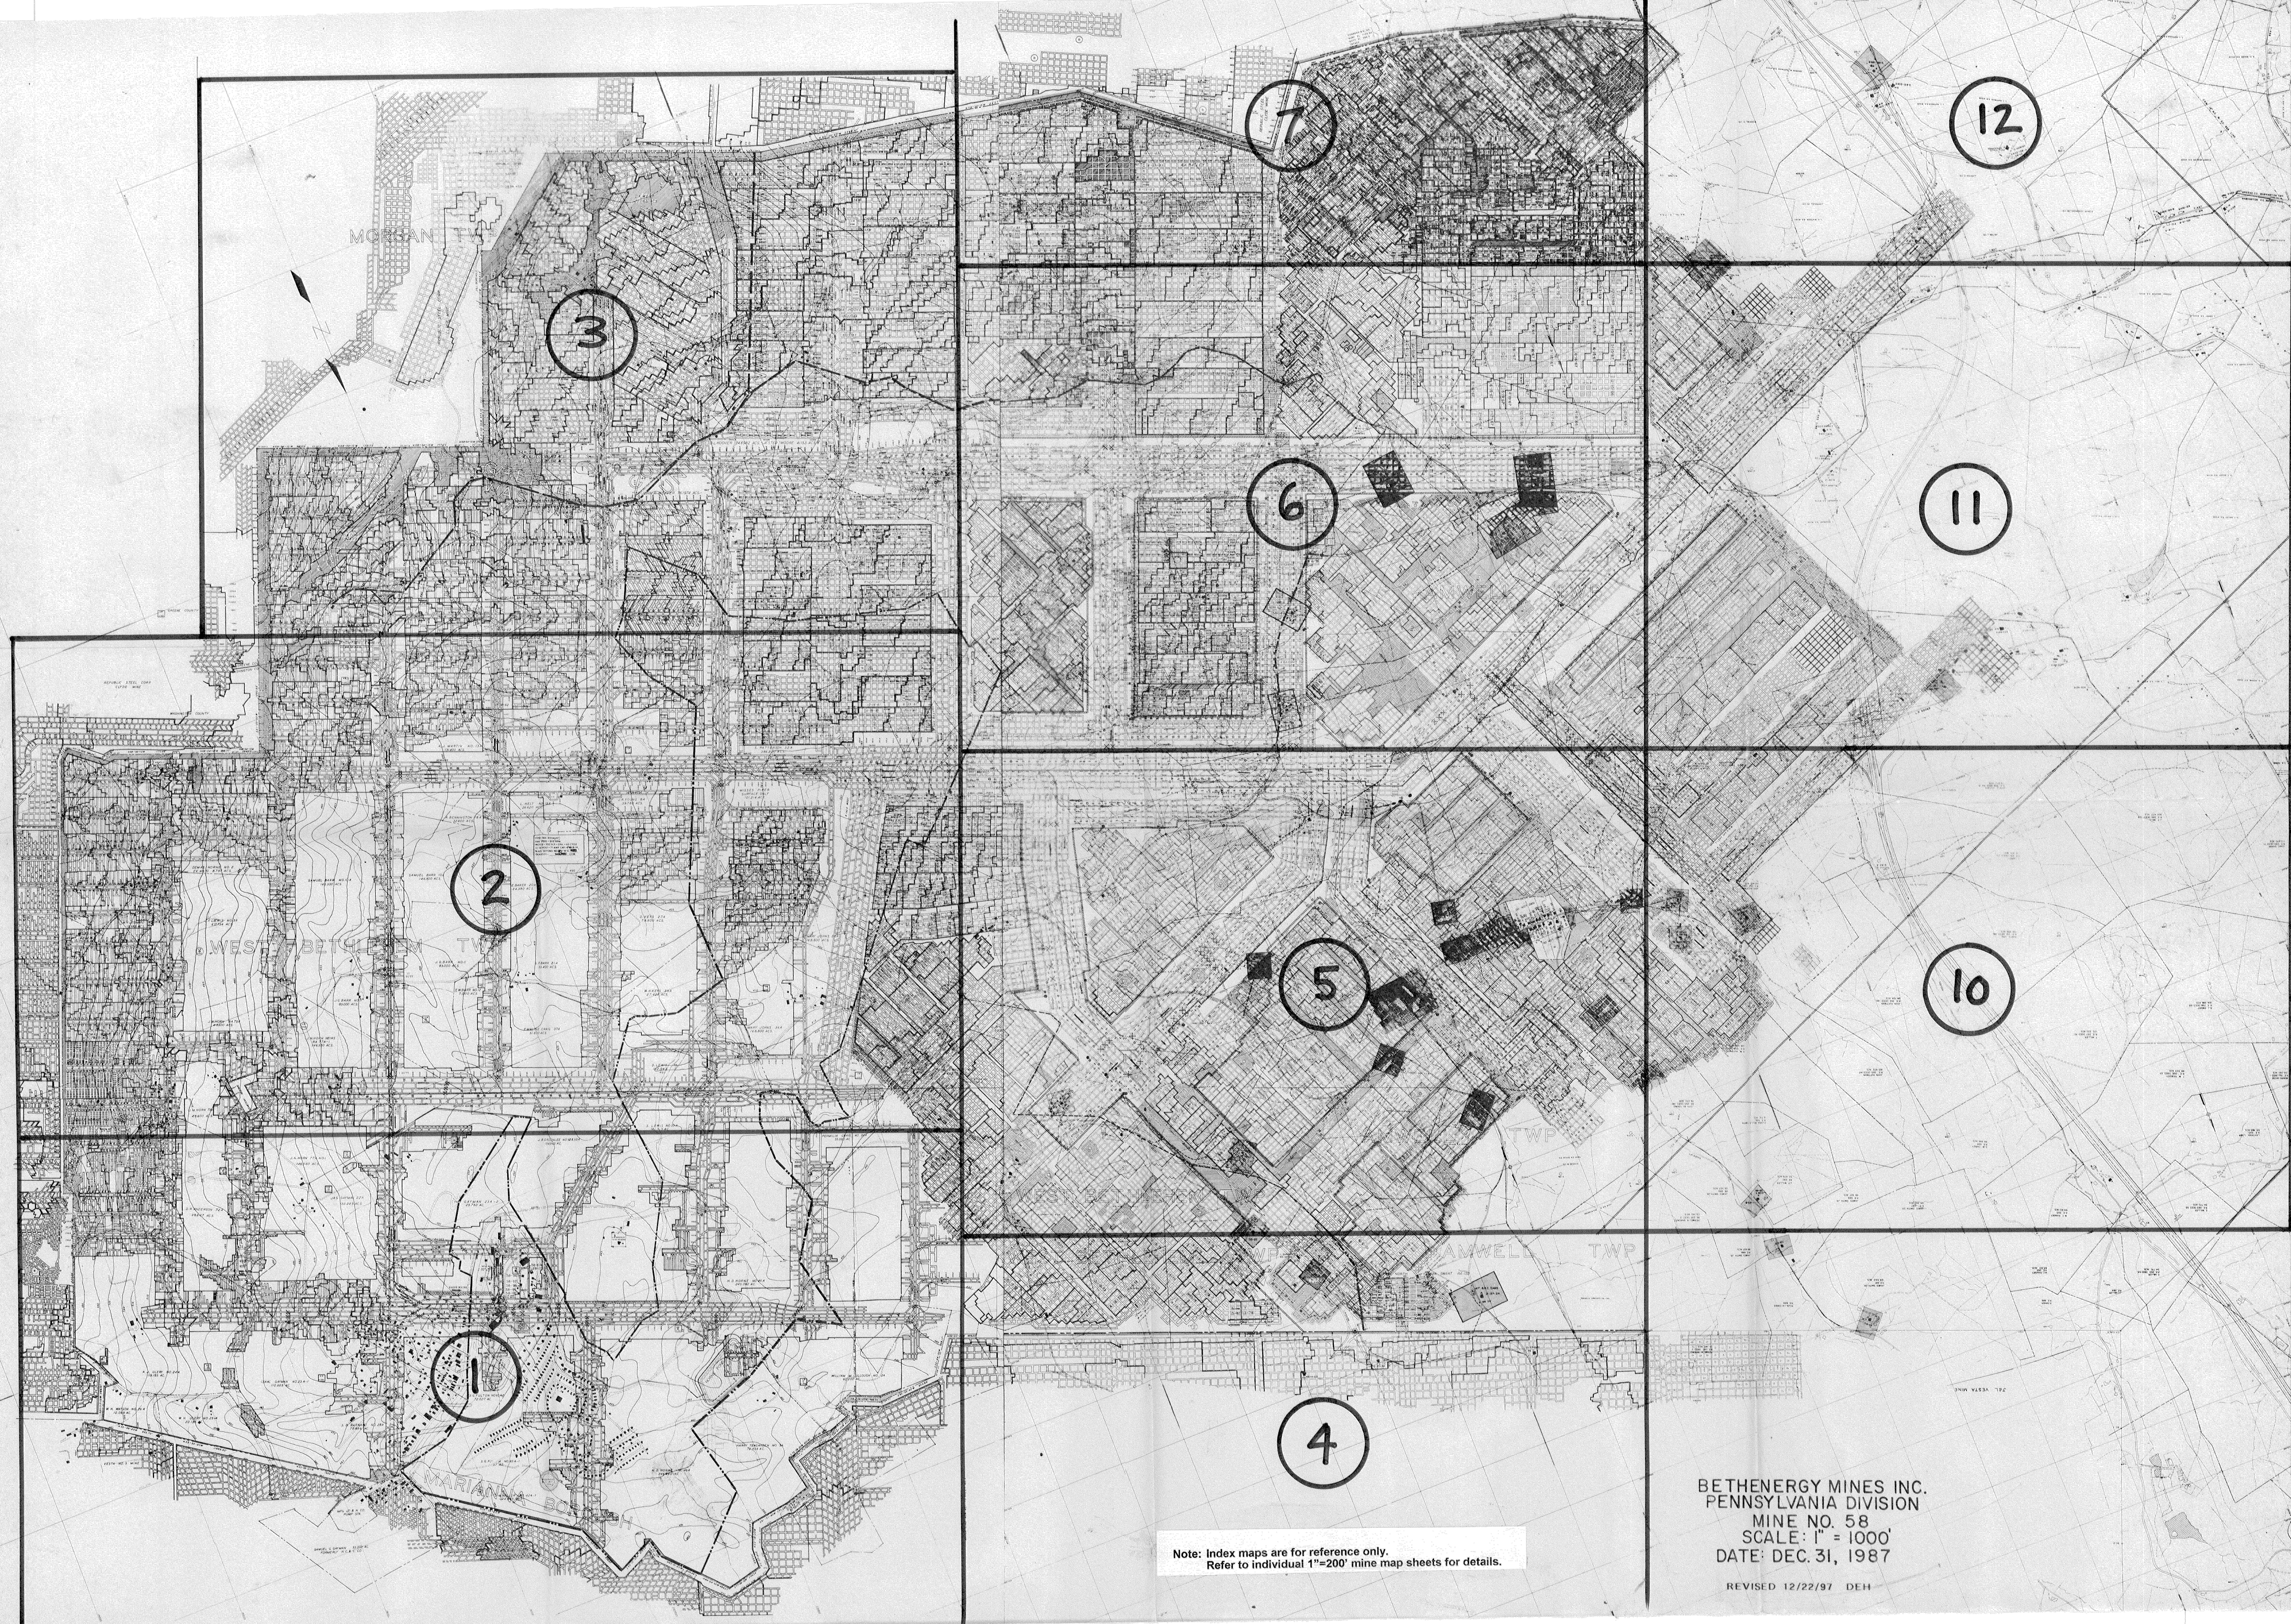

Note: Index maps are for reference only.
Refer to individual 1"=200' mine map sheets for details.

BETHENERGY MINES INC.
PENNSYLVANIA DIVISION
MINE NO. 58
SCALE: 1" = 1000'
DATE: DEC. 31, 1987
REVISED 12/22/97 DEH

3213