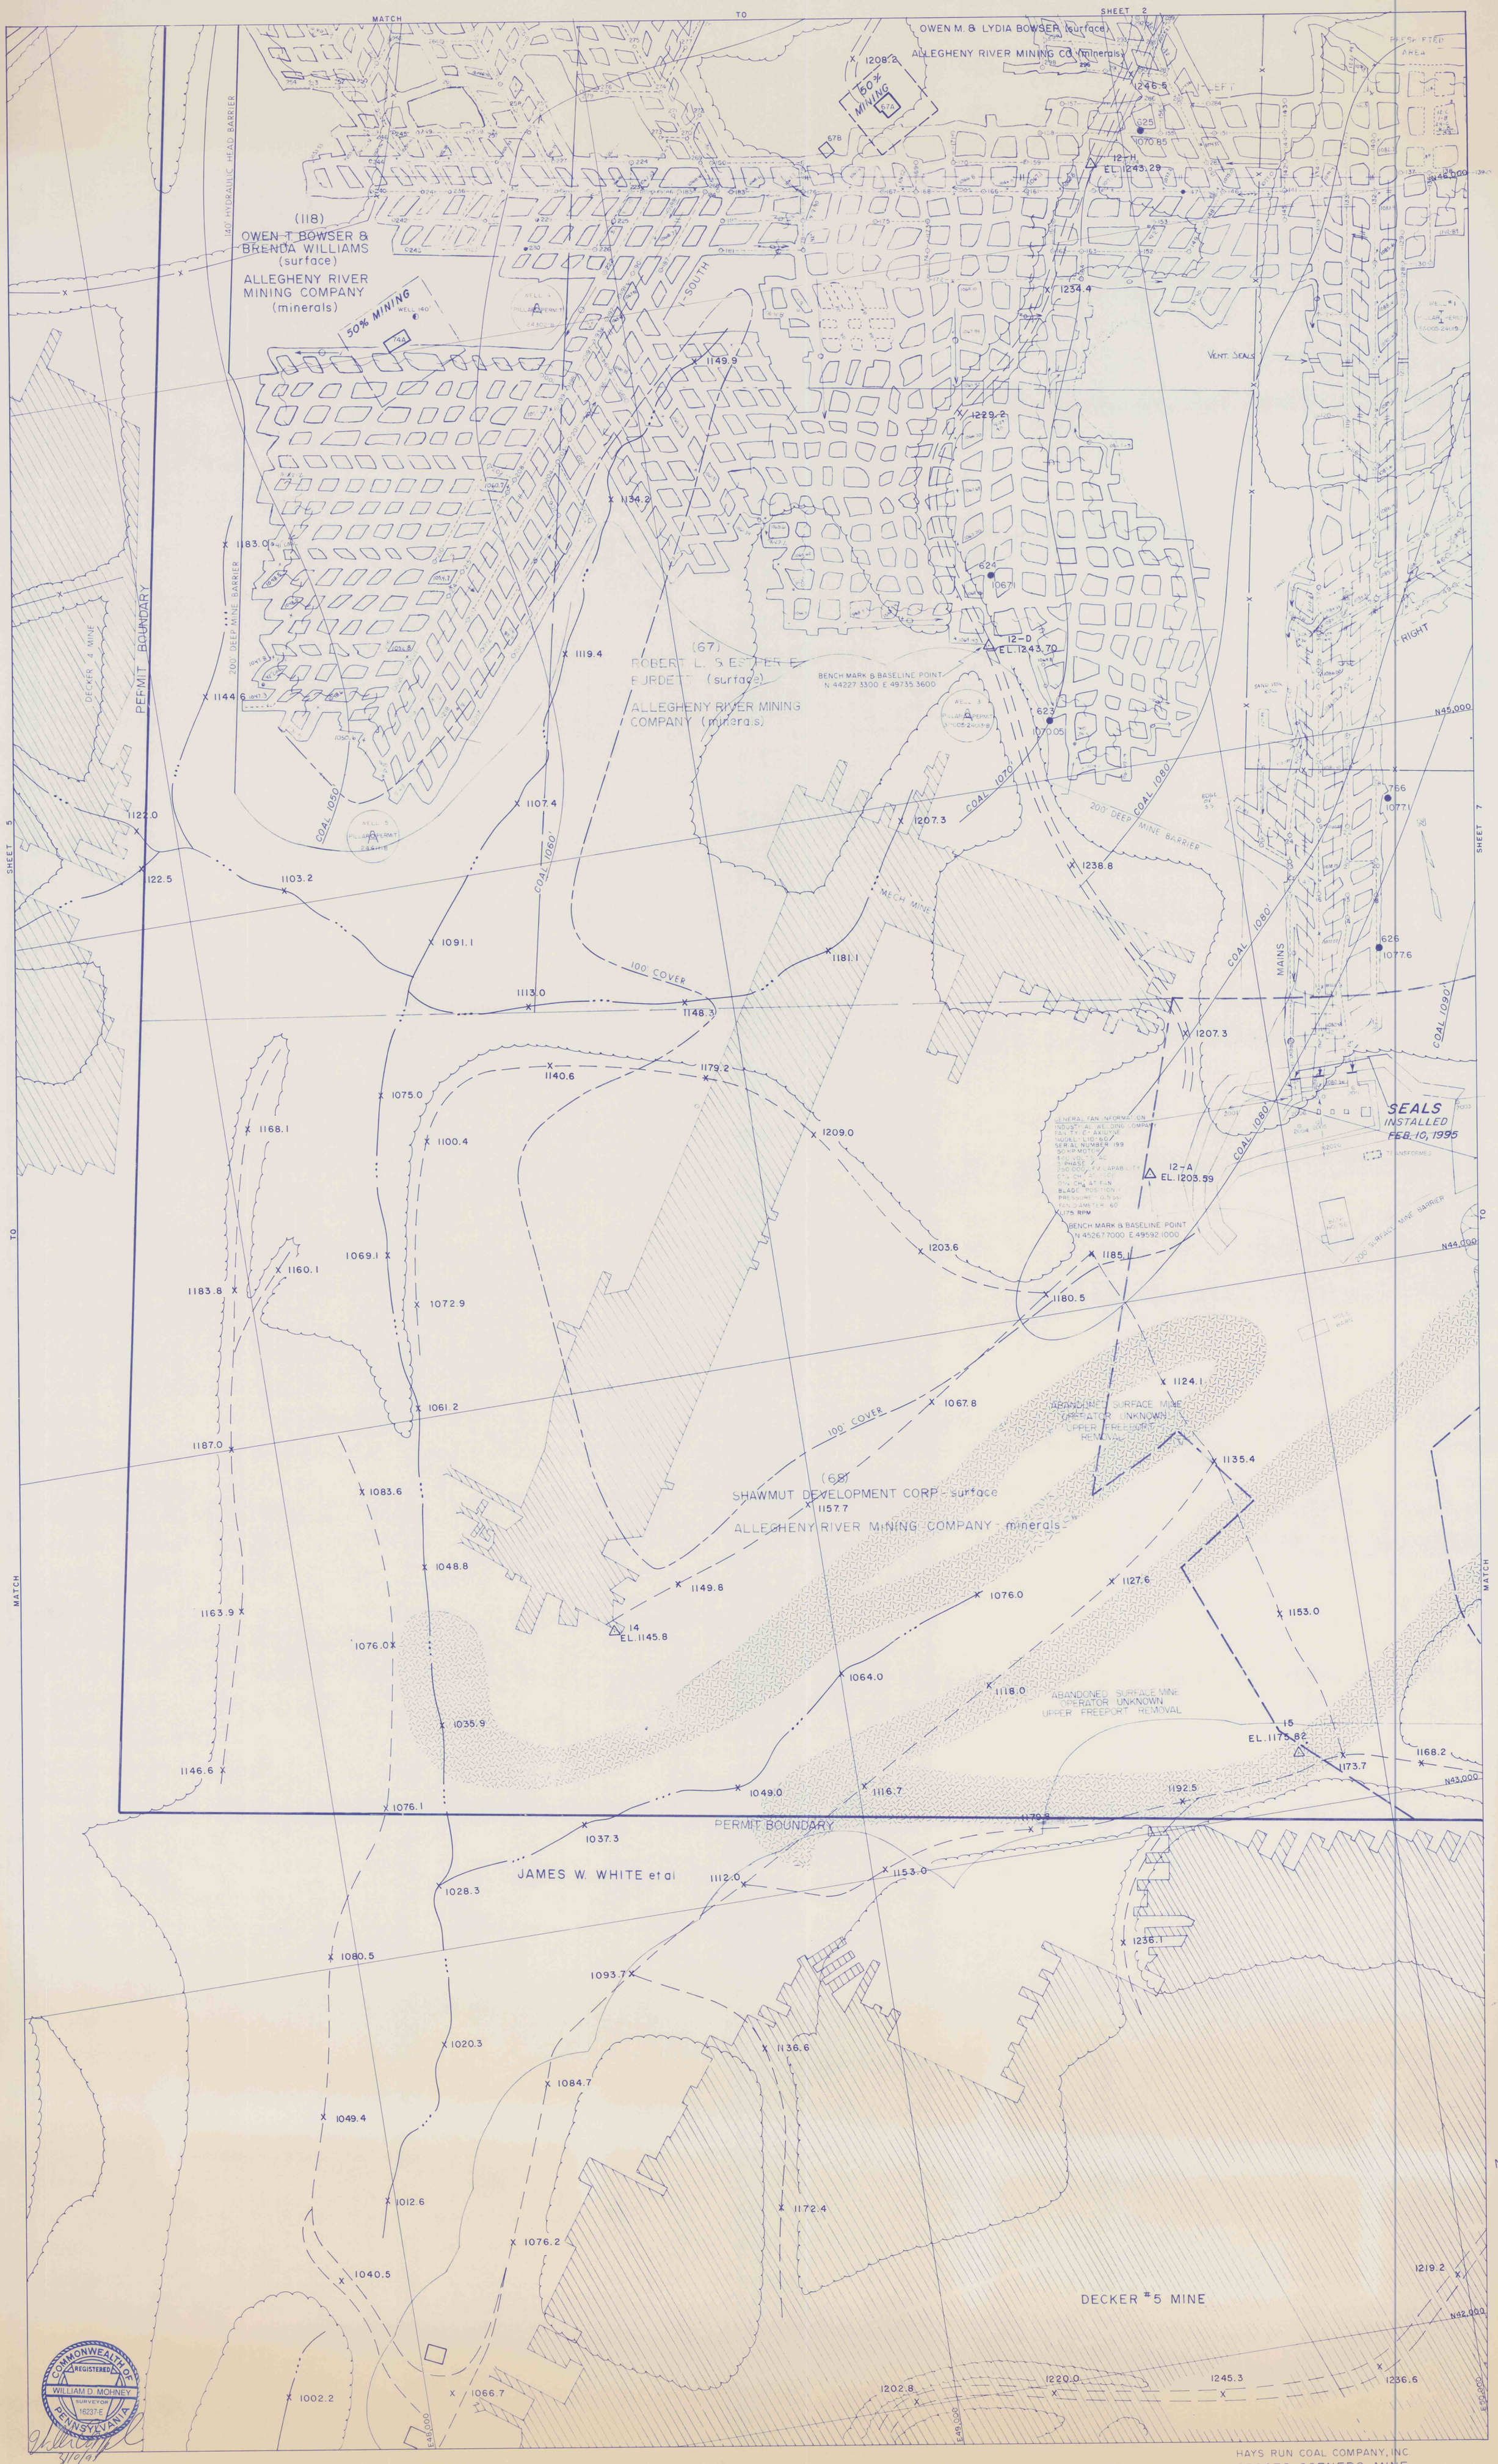
MATCH TO SHEET 2
OWEN M. & LYDIA BOWSER (surface)
ALLEGHENY RIVER MINING CO (minerals)
50% MINING
67A
67B
1208.2
1246.5
625
1070.85
12-H
EL. 1243.29
PRESHIFTED AREA
(118)
OWEN T BOWSER & BRENDA WILLIAMS (surface)
ALLEGHENY RIVER MINING COMPANY (minerals)
140' HYDRAULIC HEAD BARRIER
50% MINING
74A
WELL 140'
WELL 4 PILLAR PERMIT
WELL #1 PILLAR PERMIT
1-SOUTH
1-LEFT
1-RIGHT
VENT. SEALS
1234.4
1149.9
1229.2
1134.2
1183.0
624
1067.1
12-D
EL. 1243.70
1119.4
(67)
ROBERT L. & ESTHER E. BURDETT (surface)
ALLEGHENY RIVER MINING COMPANY (minerals)
BENCH MARK & BASELINE POINT
N 44227.3300 E 49735.3600
WELL 3 PILLAR PERMIT
1144.6
623
1070.05
N45,000
DECKER 4 MINE
PERMIT BOUNDARY
200' DEEP MINE BARRIER
COAL 1050'
COAL 1060'
COAL 1070'
COAL 1080'
COAL 1090'
WELL 5 PILLAR PERMIT
1122.0
1107.4
1207.3
766
1077.1
122.5
1103.2
1238.8
MECH MINE
626
1077.6
1091.1
100' COVER
1181.1
MAINS
1113.0
1148.3
1207.3
1140.6
1179.2
1075.0
1168.1
1100.4
1209.0
SEALS INSTALLED FEB. 10, 1995
GENERAL FAN INFORMATION
INDUSTRIAL WELDING COMPANY
FAN TYPE AXIVUNE
MODEL LIO-160
SERIAL NUMBER 199
50 HP MOTOR
400 VOLTS AC
3 PHASE
250,000 CFM CAPABILITY
0% CH4 AT FAN
0% CH4 AT FAN
BLADE POSITION
PRESSURE 0.5 psi
FAN DIAMETER 60"
1175 RPM
12-A
EL. 1203.59
TRANSFORMER
BENCH MARK & BASELINE POINT
N 452677.000 E 49592.1000
200' SURFACE MINE BARRIER
N44,000
1203.6
1185.1
1183.8
1160.1
1069.1
1072.9
1180.5
1124.1
1061.2
1067.8
ABANDONED SURFACE MINE OPERATOR UNKNOWN UPPER FREEPORT REMOVAL
1187.0
1135.4
1083.6
(68)
SHAWMUT DEVELOPMENT CORP - surface
ALLEGHENY RIVER MINING COMPANY - minerals -
1157.7
1048.8
1149.8
1127.6
1076.0
1153.0
1163.9
14
EL. 1145.8
1076.0
1064.0
1118.0
ABANDONED SURFACE MINE OPERATOR UNKNOWN UPPER FREEPORT REMOVAL
1035.9
15
EL. 1175.82
1168.2
1146.6
1173.7
1049.0
1116.7
1192.5
N43,000
1076.1
1170.9
PERMIT BOUNDARY
1037.3
JAMES W. WHITE et al
1112.0
1153.0
1028.3
1236.1
1080.5
1093.7
1020.3
1136.6
1084.7
1049.4
1012.6
1172.4
1076.2
1040.5
1219.2
DECKER #5 MINE
N42,000
1002.2
1066.7
1202.8
1220.0
1245.3
1236.6
E48,000
E49,000
E50,000
COMMONWEALTH OF PENNSYLVANIA REGISTERED WILLIAM D. MOHNEY SURVEYOR 16237-E
3/10/98
N
SCALE 1" = 100'
(UPPER FREEPORT COAL SEAM)
HAYS RUN COAL COMPANY, INC.
SPACES CORNERS MINE
RAYBURN AND VALLEY TWPS., ARMSTRONG CO., PA