

HAYS RUN COAL CO.
SPACES CORNERS MINE
ESCAPEWAY MAP

DATE: ~~10-22-92~~ SCALE: 1"=400'


Nov. 4, 1992

NOTES: NO CO MONITORING IS UTILIZED
ALONG BELTS.

NO TRACK IS UTILIZED,

LEGEND

- PRIMARY ESCAPEWAY
- ALTERNATE ESCAPEWAY
- INTAKE AIR
- BELT AIR
- RETURN AIR
- STOPPING
- || STOPPING W/ MAN DOOR
- ~ CHECK CURTAIN
- BELT ENTRY
- HAULAGE INTAKE ENTRY
- ← AIR FLOW

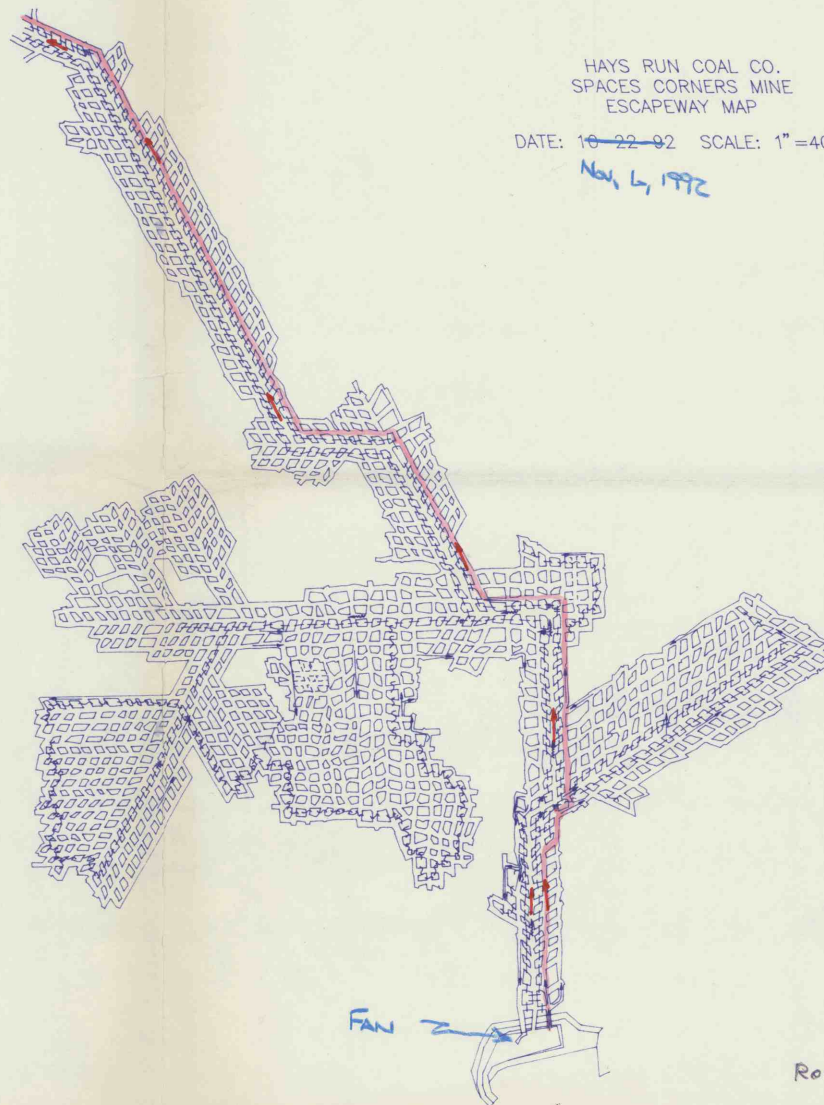

Rec. 11-6-92
DM