


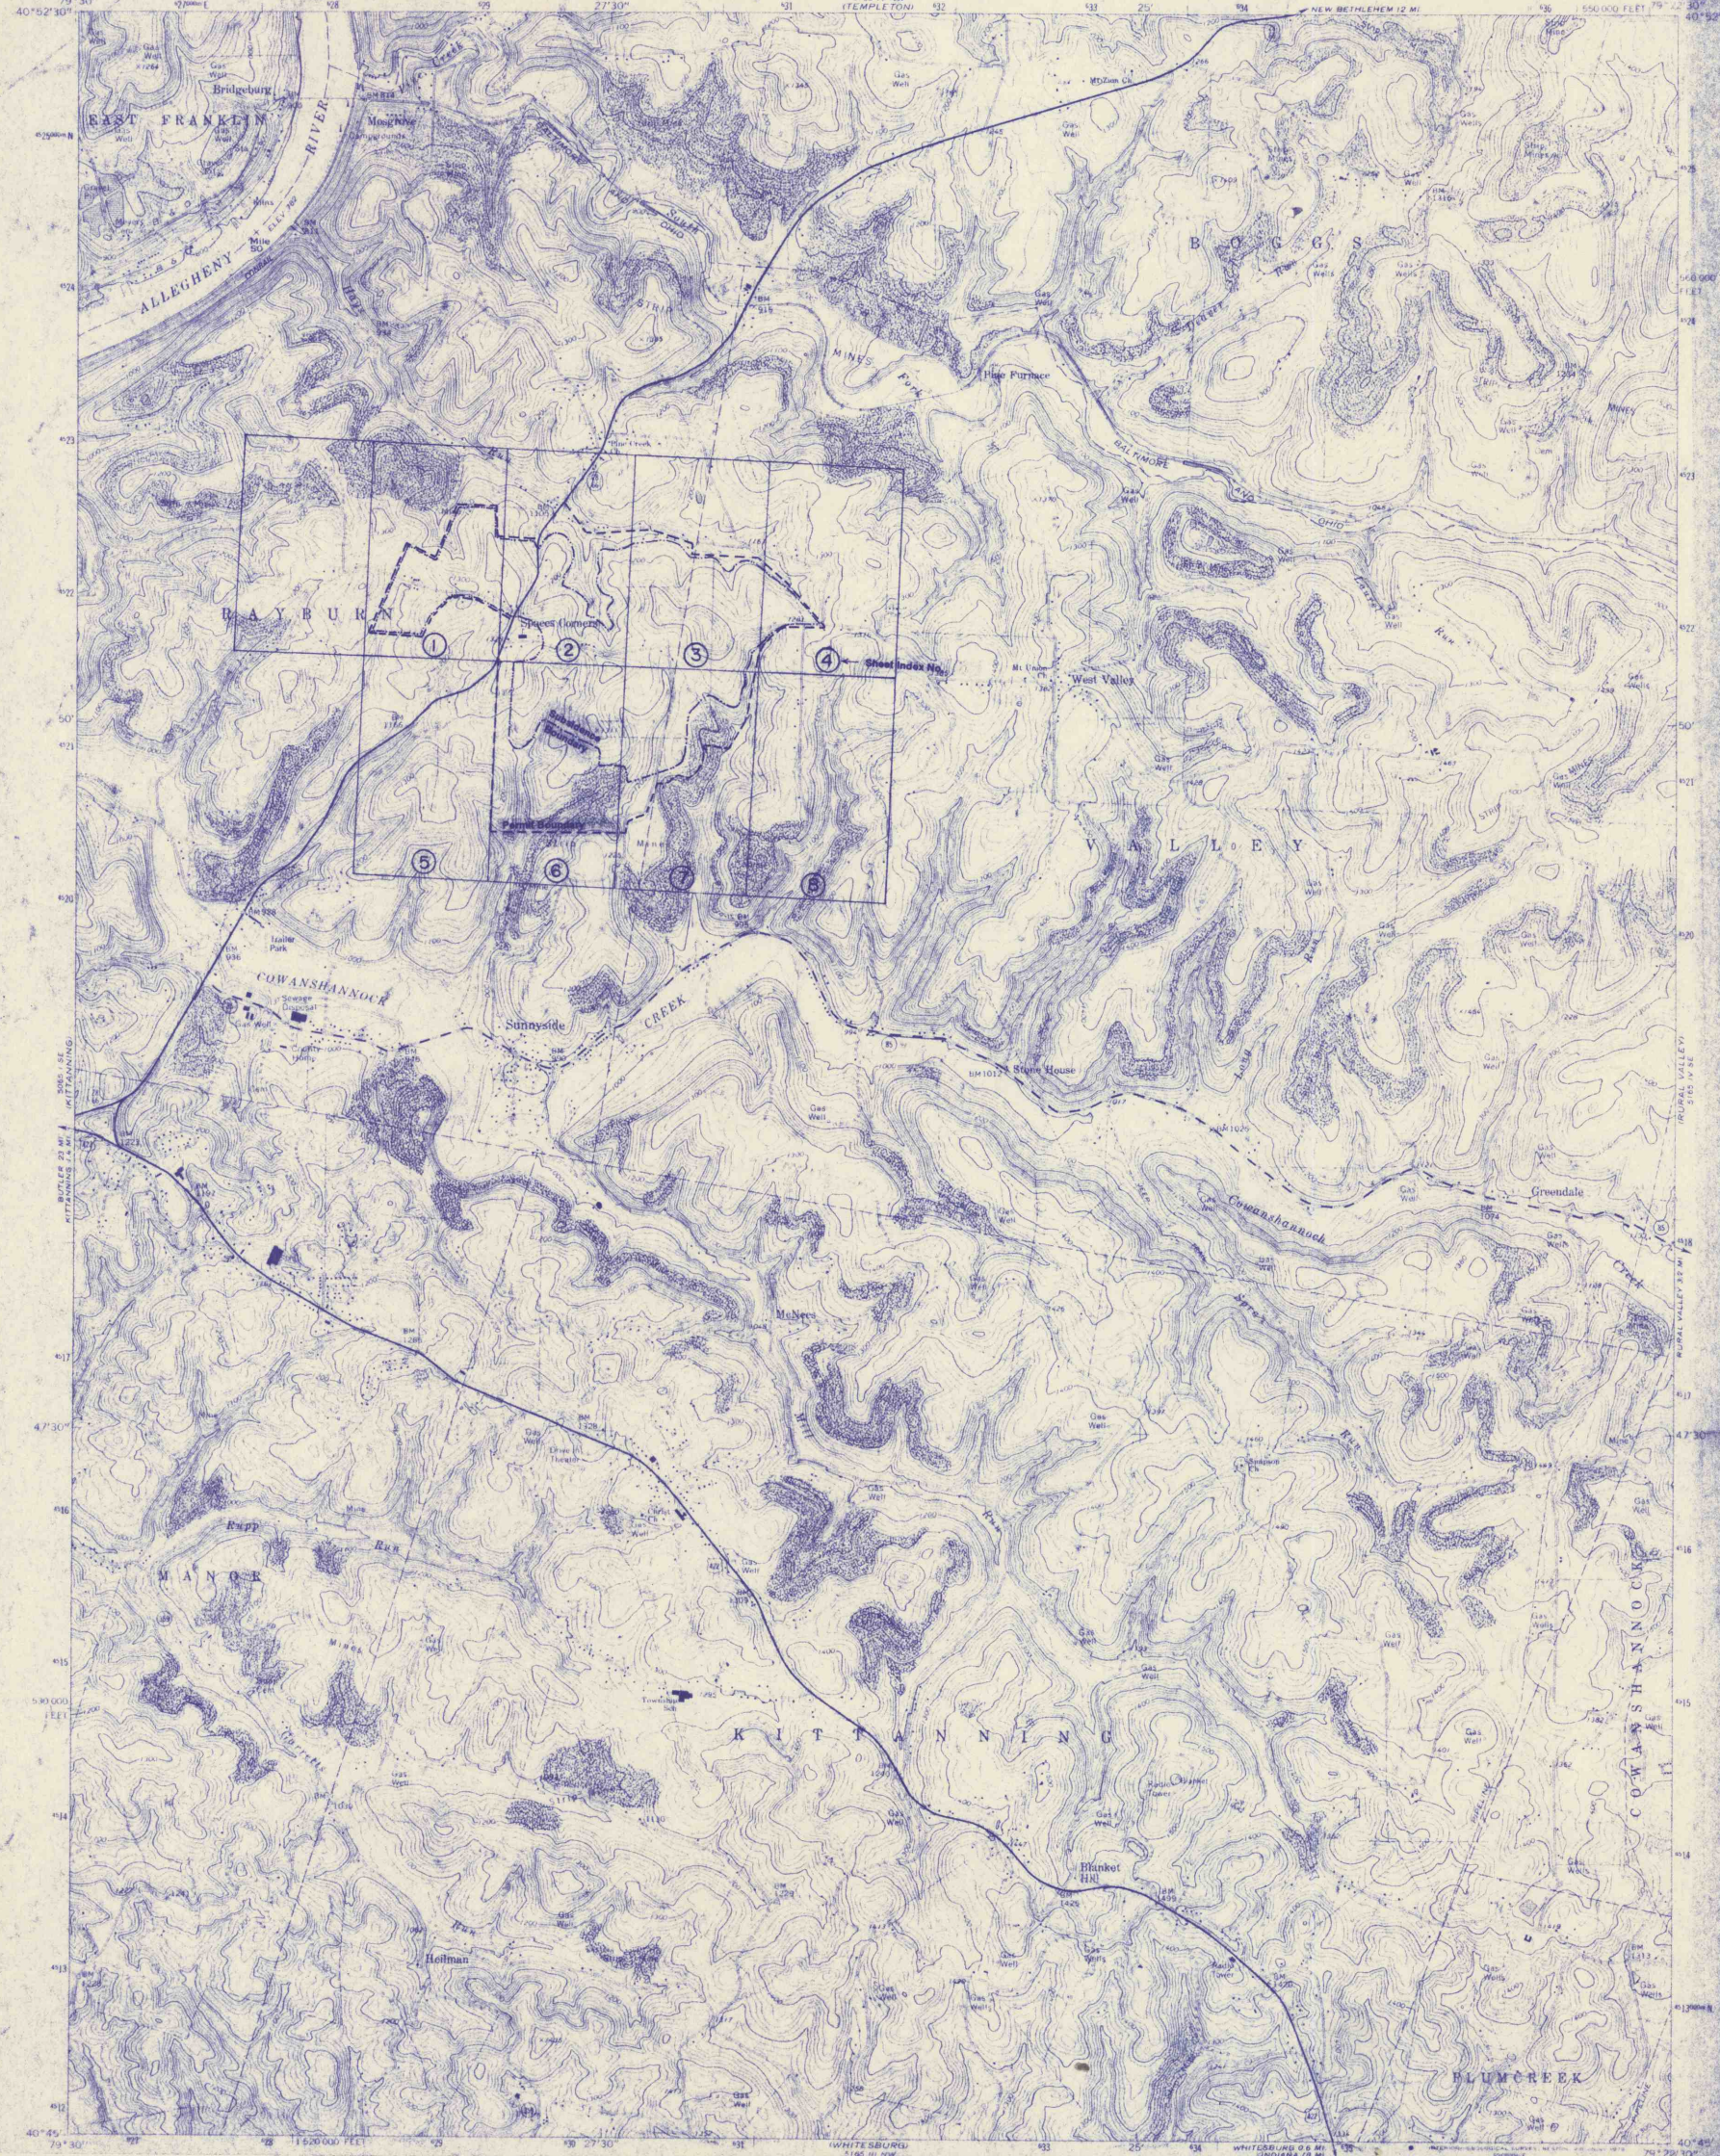

HAYS RUN COAL CO.

One Glade Park East
R.D. #8 Box 46
Kittanning, PA 16201

Spaces Corner Mine

Rayburn & Valley Twps., Armstrong Co., PA
Federal Mine I.D. No. 36 07959
Pennsylvania Mining Activity Permit No. 03841312

FINAL MAP

Index Sheet Scale: 1 inch = 2,000 feet Map Scale: 1 inch = 100 feet

Coal Seam: Upper Freeport (E) Seam
Final Mining Date: Jan. 23, 1995
Final Survey Date: Jan. 24, 1995
Seal Completion Date: Feb. 10, 1995

I, William D. Mohney a Registered Surveyor (PA License No. 16237-E) hereby certify that this is a final copy of the Spaces Corner Mine mine map and that this map fully and accurately shows all of the excavation made in said abandoned mine, to the best of my knowledge and belief.

William D. Mohney 3/10/95
William D. Mohney, R.S.

