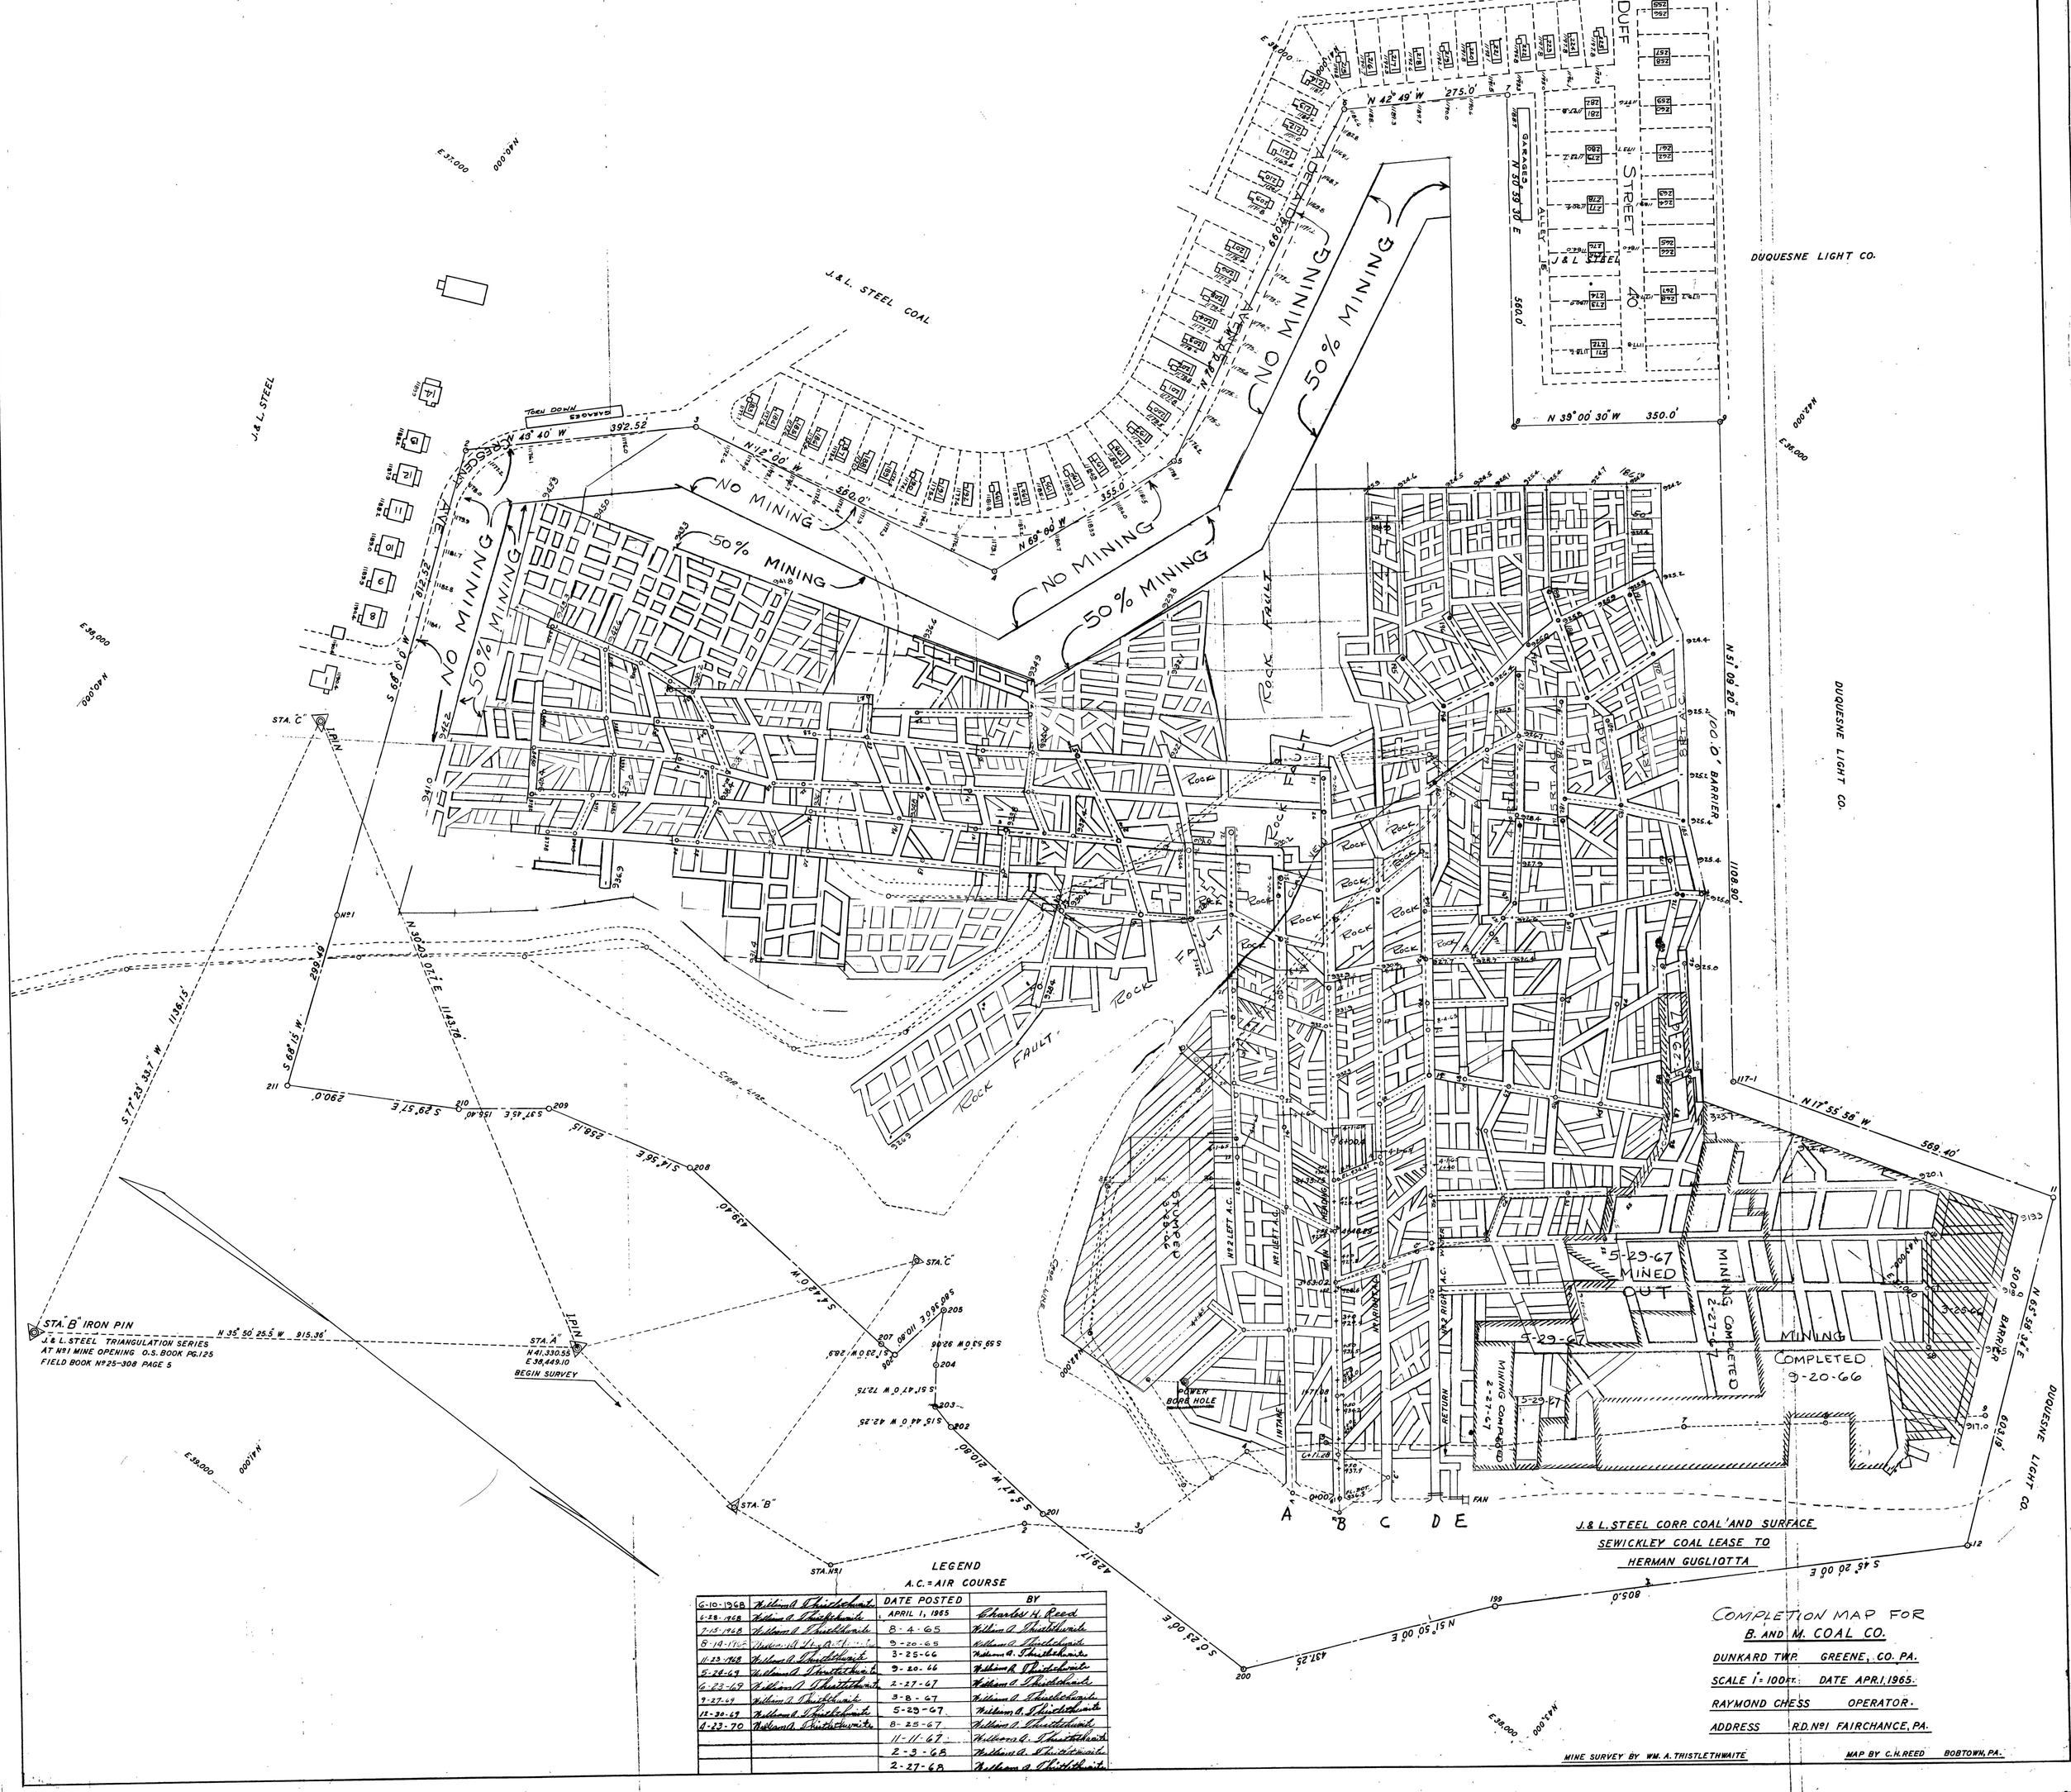
DUFF STREET
J & L STEEL
ALLEY 16
GARAGES
N 39° 00' 30" W 350.0'
N 42° 49' W 275.0'
N 69° 00' W 355.0'
N 12° 00' W 880.0'
N 49° 40' W 392.52'
S 68° 0' 0" W 812.52'
N 51° 09' 20" E
N 17° 55' 58" W 569.40'
S 45° 20' 00" E
S 23° 00' E
N 51° 50' 00" E
N 30° 03' 20" E 1143.76'
S 68° 15' W 299.40'
S 29° 57' E 290.0'
S 37° 45' E 156.40'
S 14° 56' E 258.15'
S 4° 40' W 419.40'
S 4° 14' W 210.80'
S 45° 20' 00" E 805.0'
N 65° 54' 34" E 620.19'
