


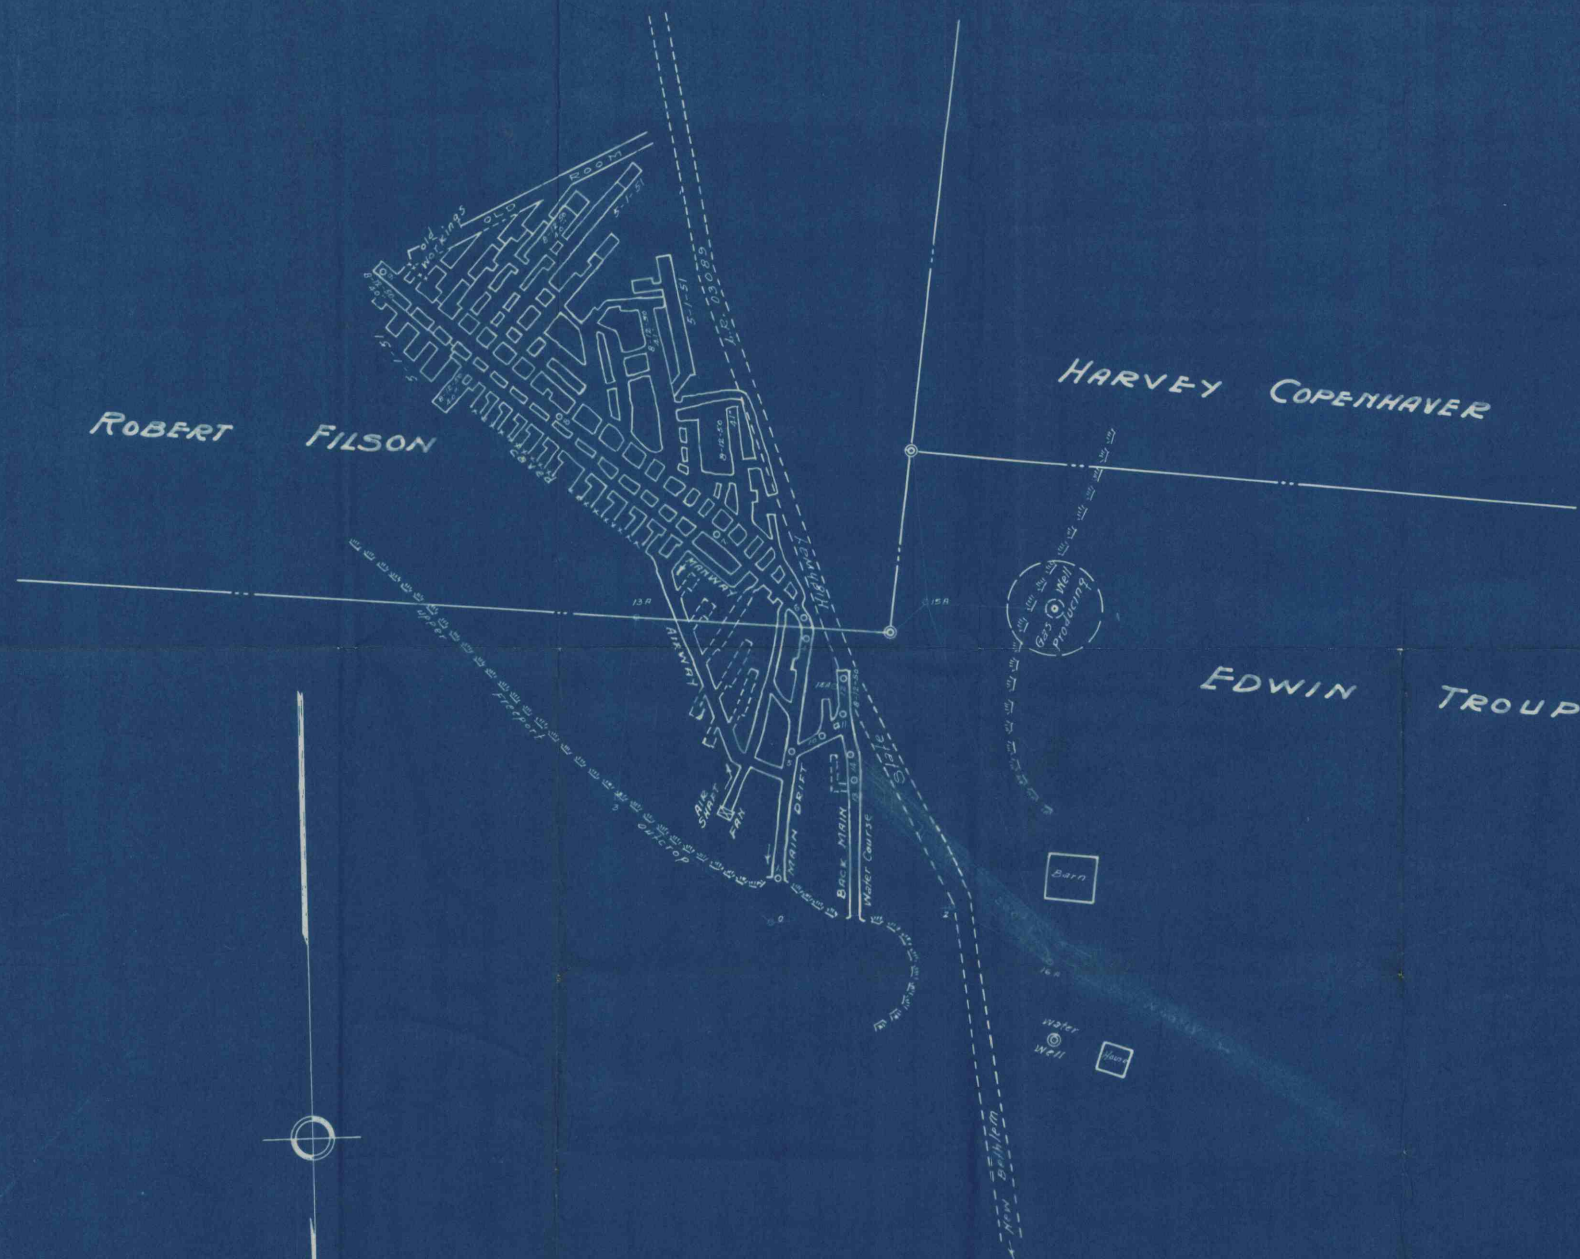

EDWIN TROUP MINE
 UPPER FREEPORT VEIN
 Red Bank Twp. Armstrong Co. Pa.
 Scale 1"=100'

Surveyed Aug. 12, 1950

E. J. Weibel R.S. 6572

Note:-
 I Certify That The mine extensions Shown under date
 of 5-1-51 are True and Correct to the best of my knowledge and
 ability and that this mine Ceased Operation as of that Date.
 May 1-1951

E. J. Weibel Reg. Sur.

Operator - Edwin Troup 800 East Penn St. New Bethlehem Pa.

