


EARL M. REED COAL CO.

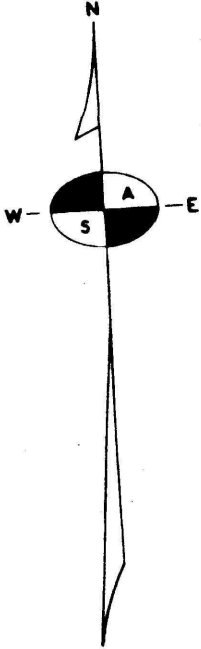

GAS
WELL

TO NEW SALEM

CAVES, WATER AND BAD ROOF

CONCAVE MASONRY SEALS

HIGHWALL

TOE

OF

TOE

OF

SPOIL

C O A P

F R E E D O O K

TO RT = 03066

DAVID G. BEST ET. AL.

REVISED 6/15/65

COMPLETION REPORT
MEWILLIAMS COAL MINE
HAWK BROS. INCORPORATED
REDBANK TWP, ARMSTRONG CO., PA.
R. B. SHANNON & ASSOCIATES, KITTANNING, PA.
DRAWN BY RLM DATE JAN. 1965
SCALE 1" = 100' DRAWING NO. C-503

WILLIAM M. GEIST