


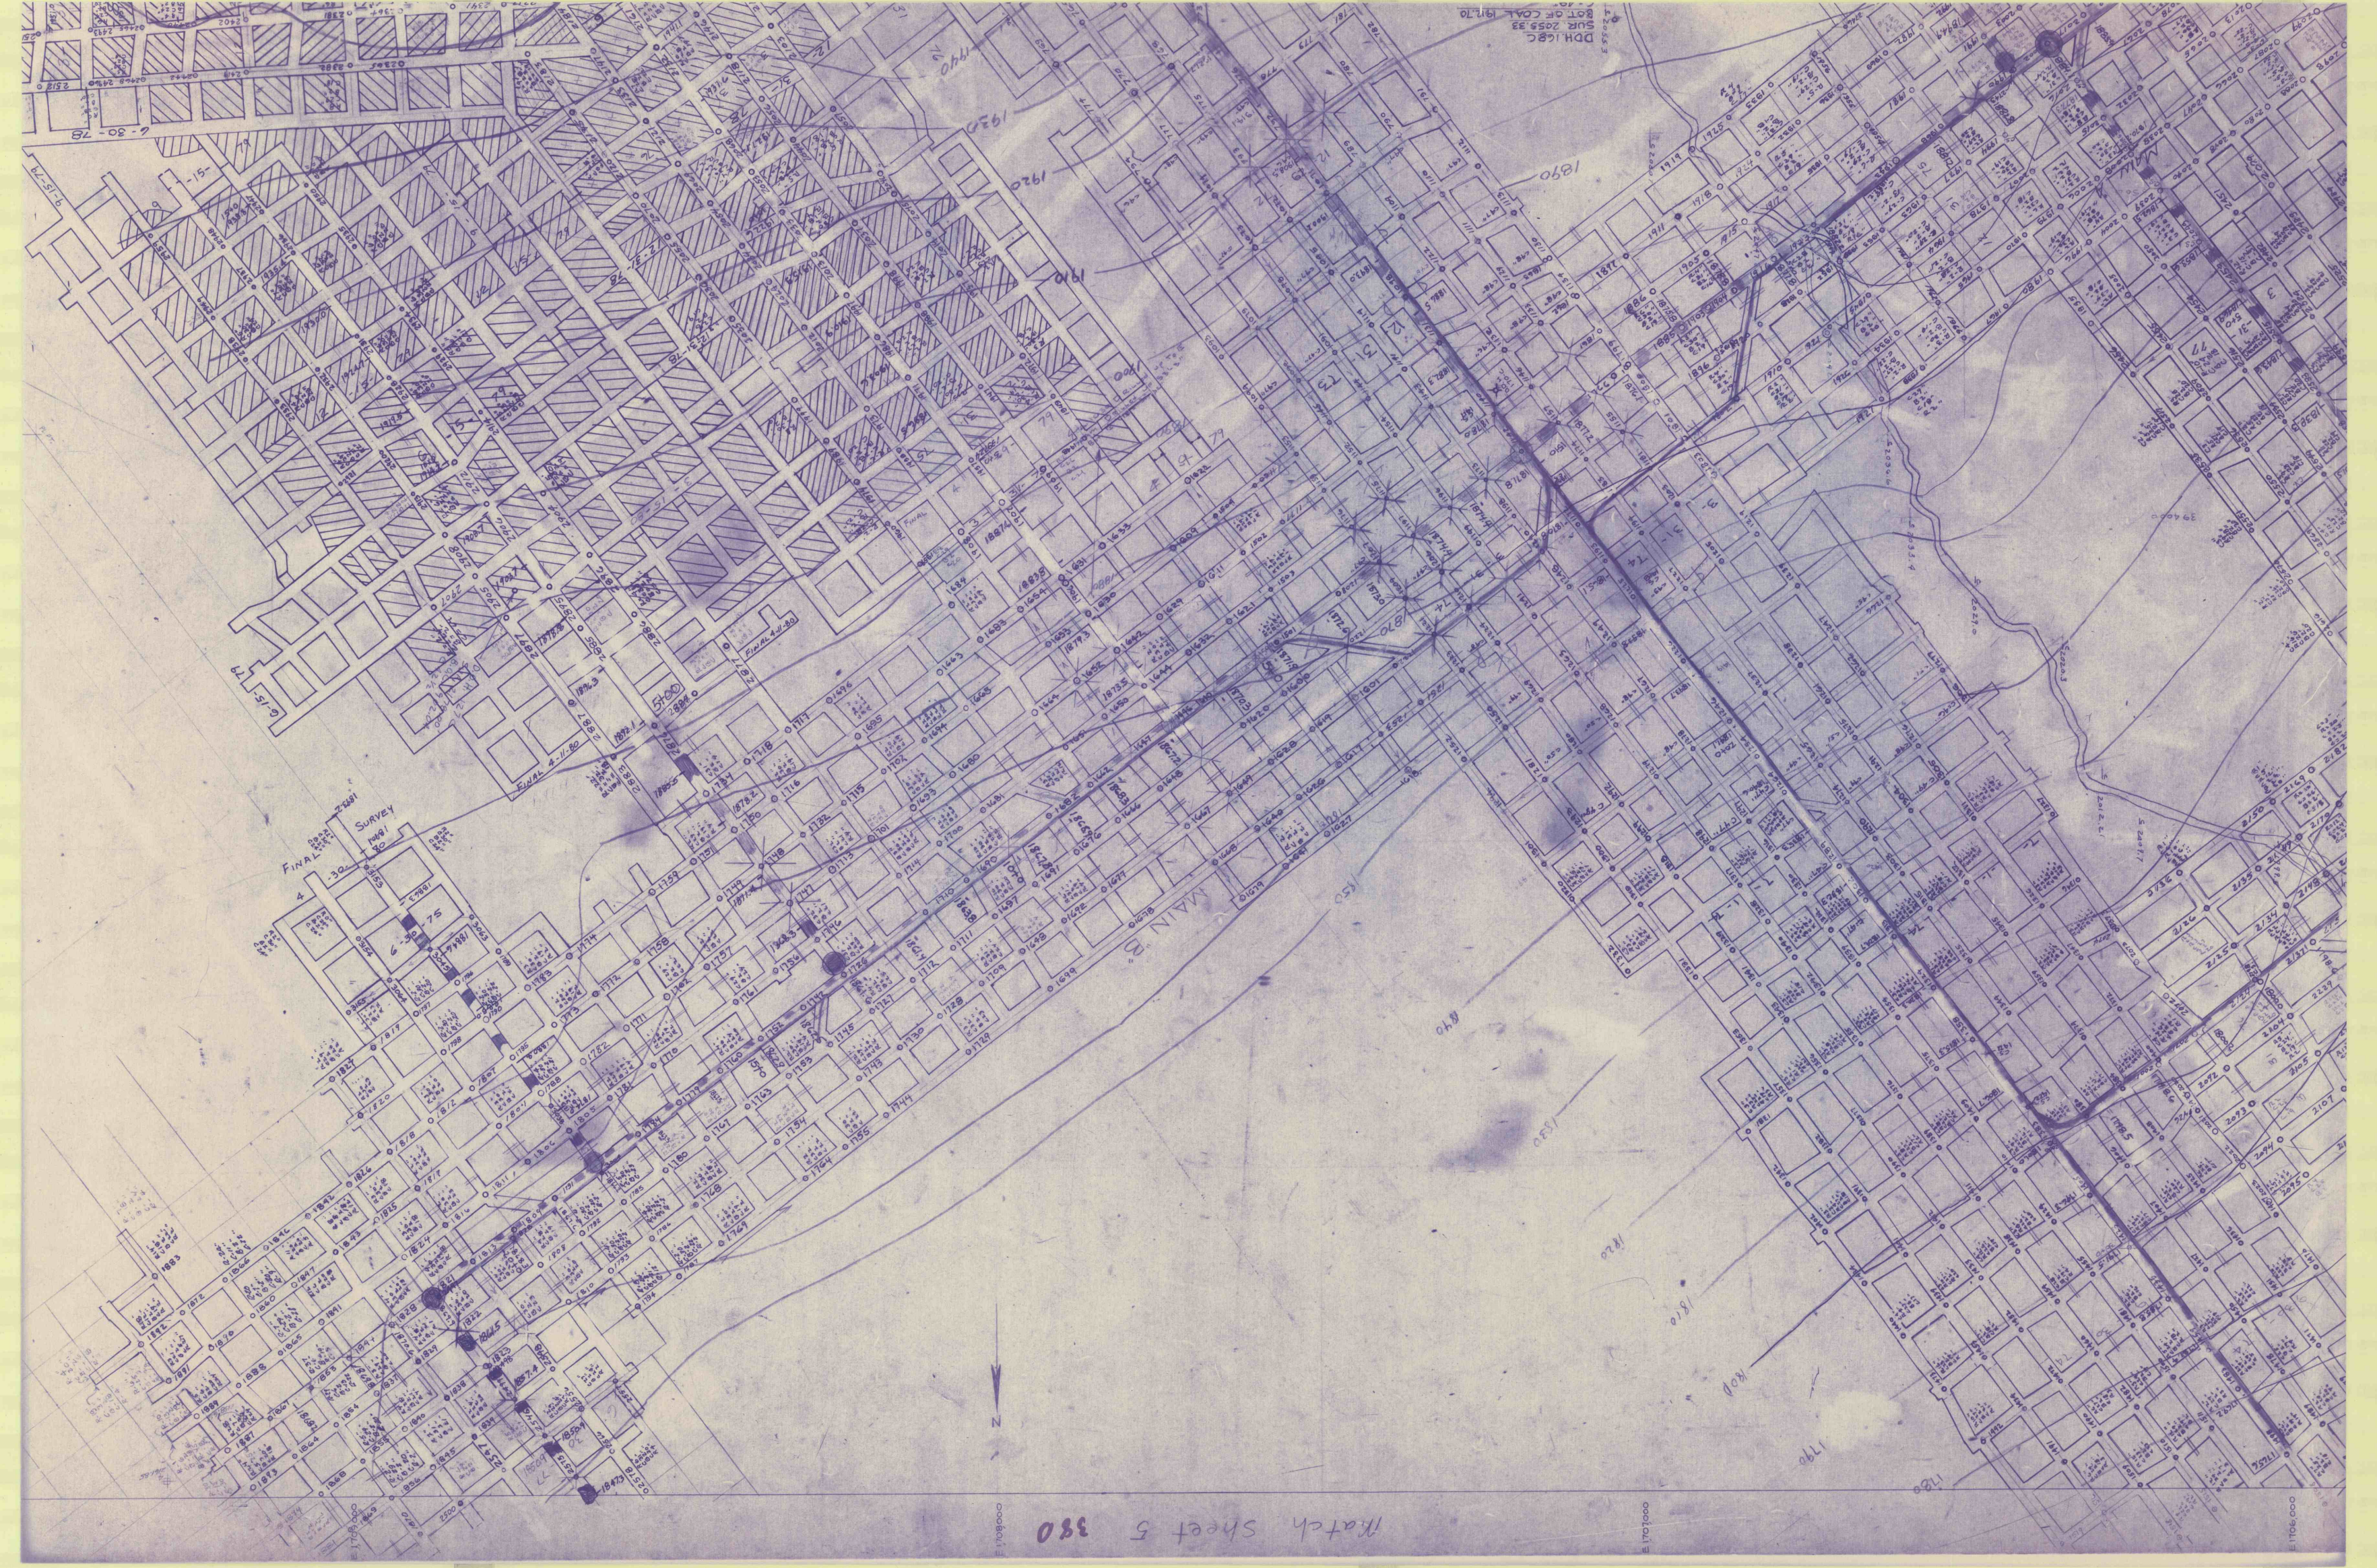

Match Sheet 5 380

