


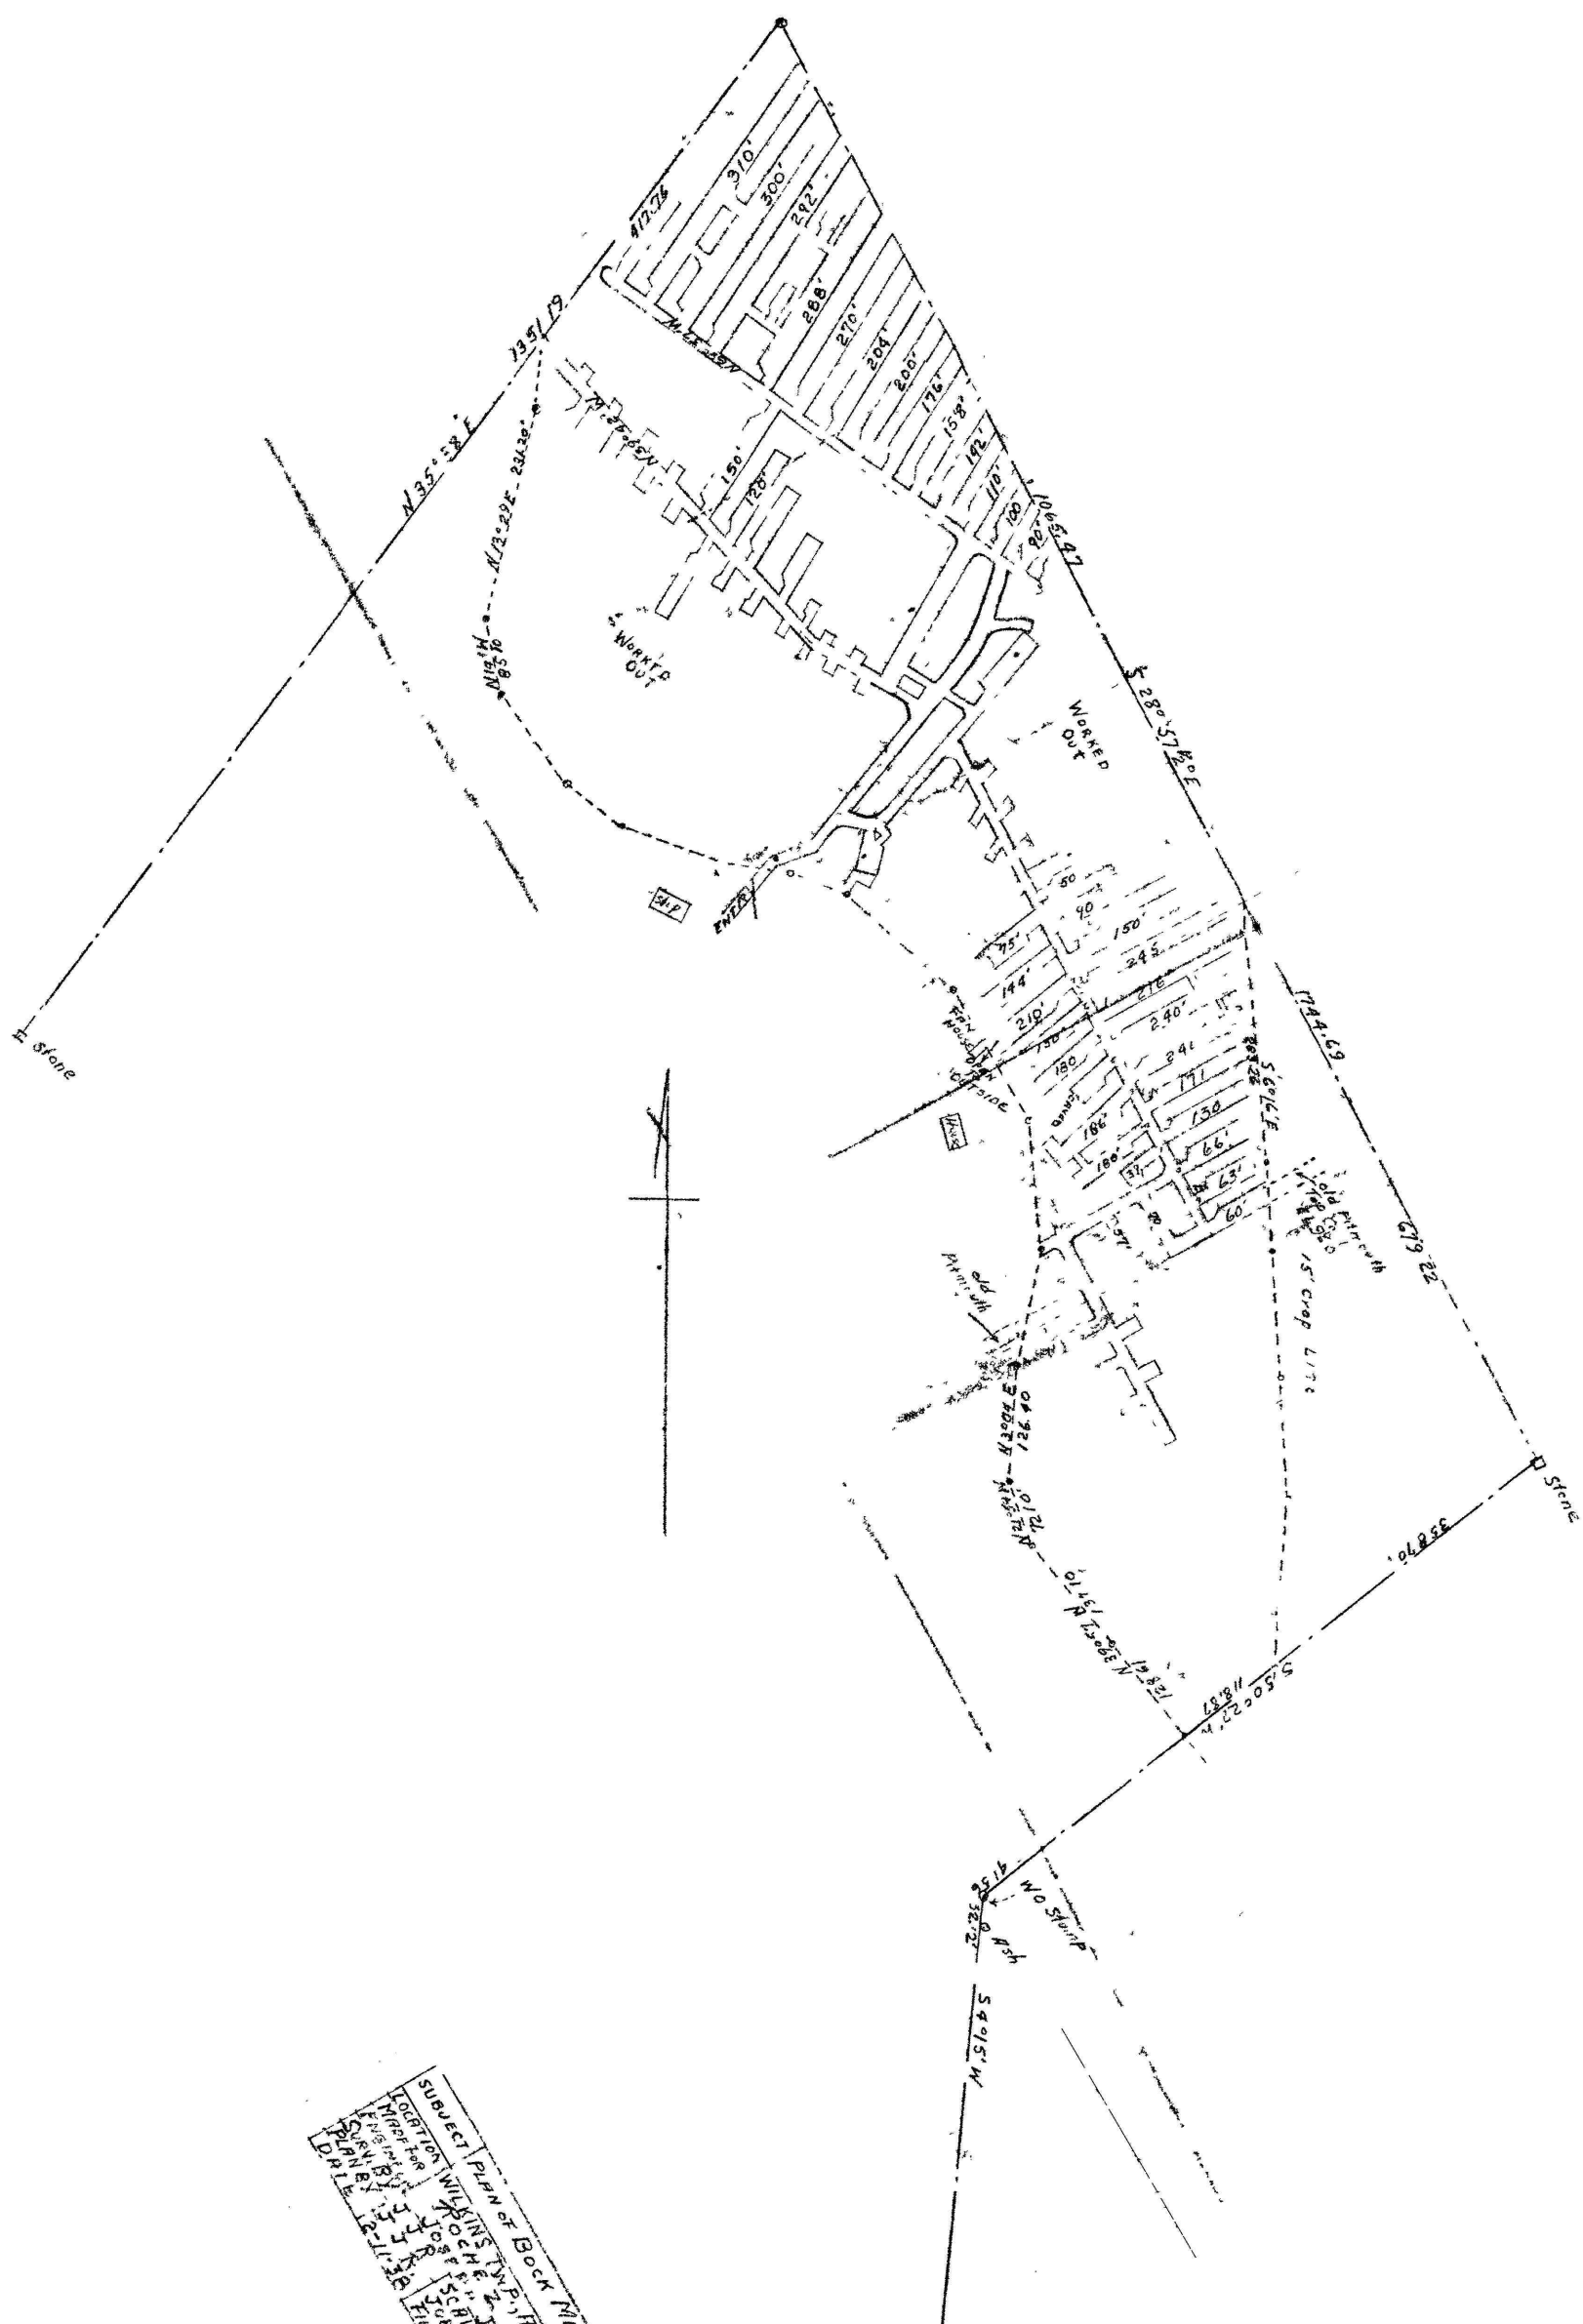

DATE	LOCATION	PLAN of BOCK	NAME
