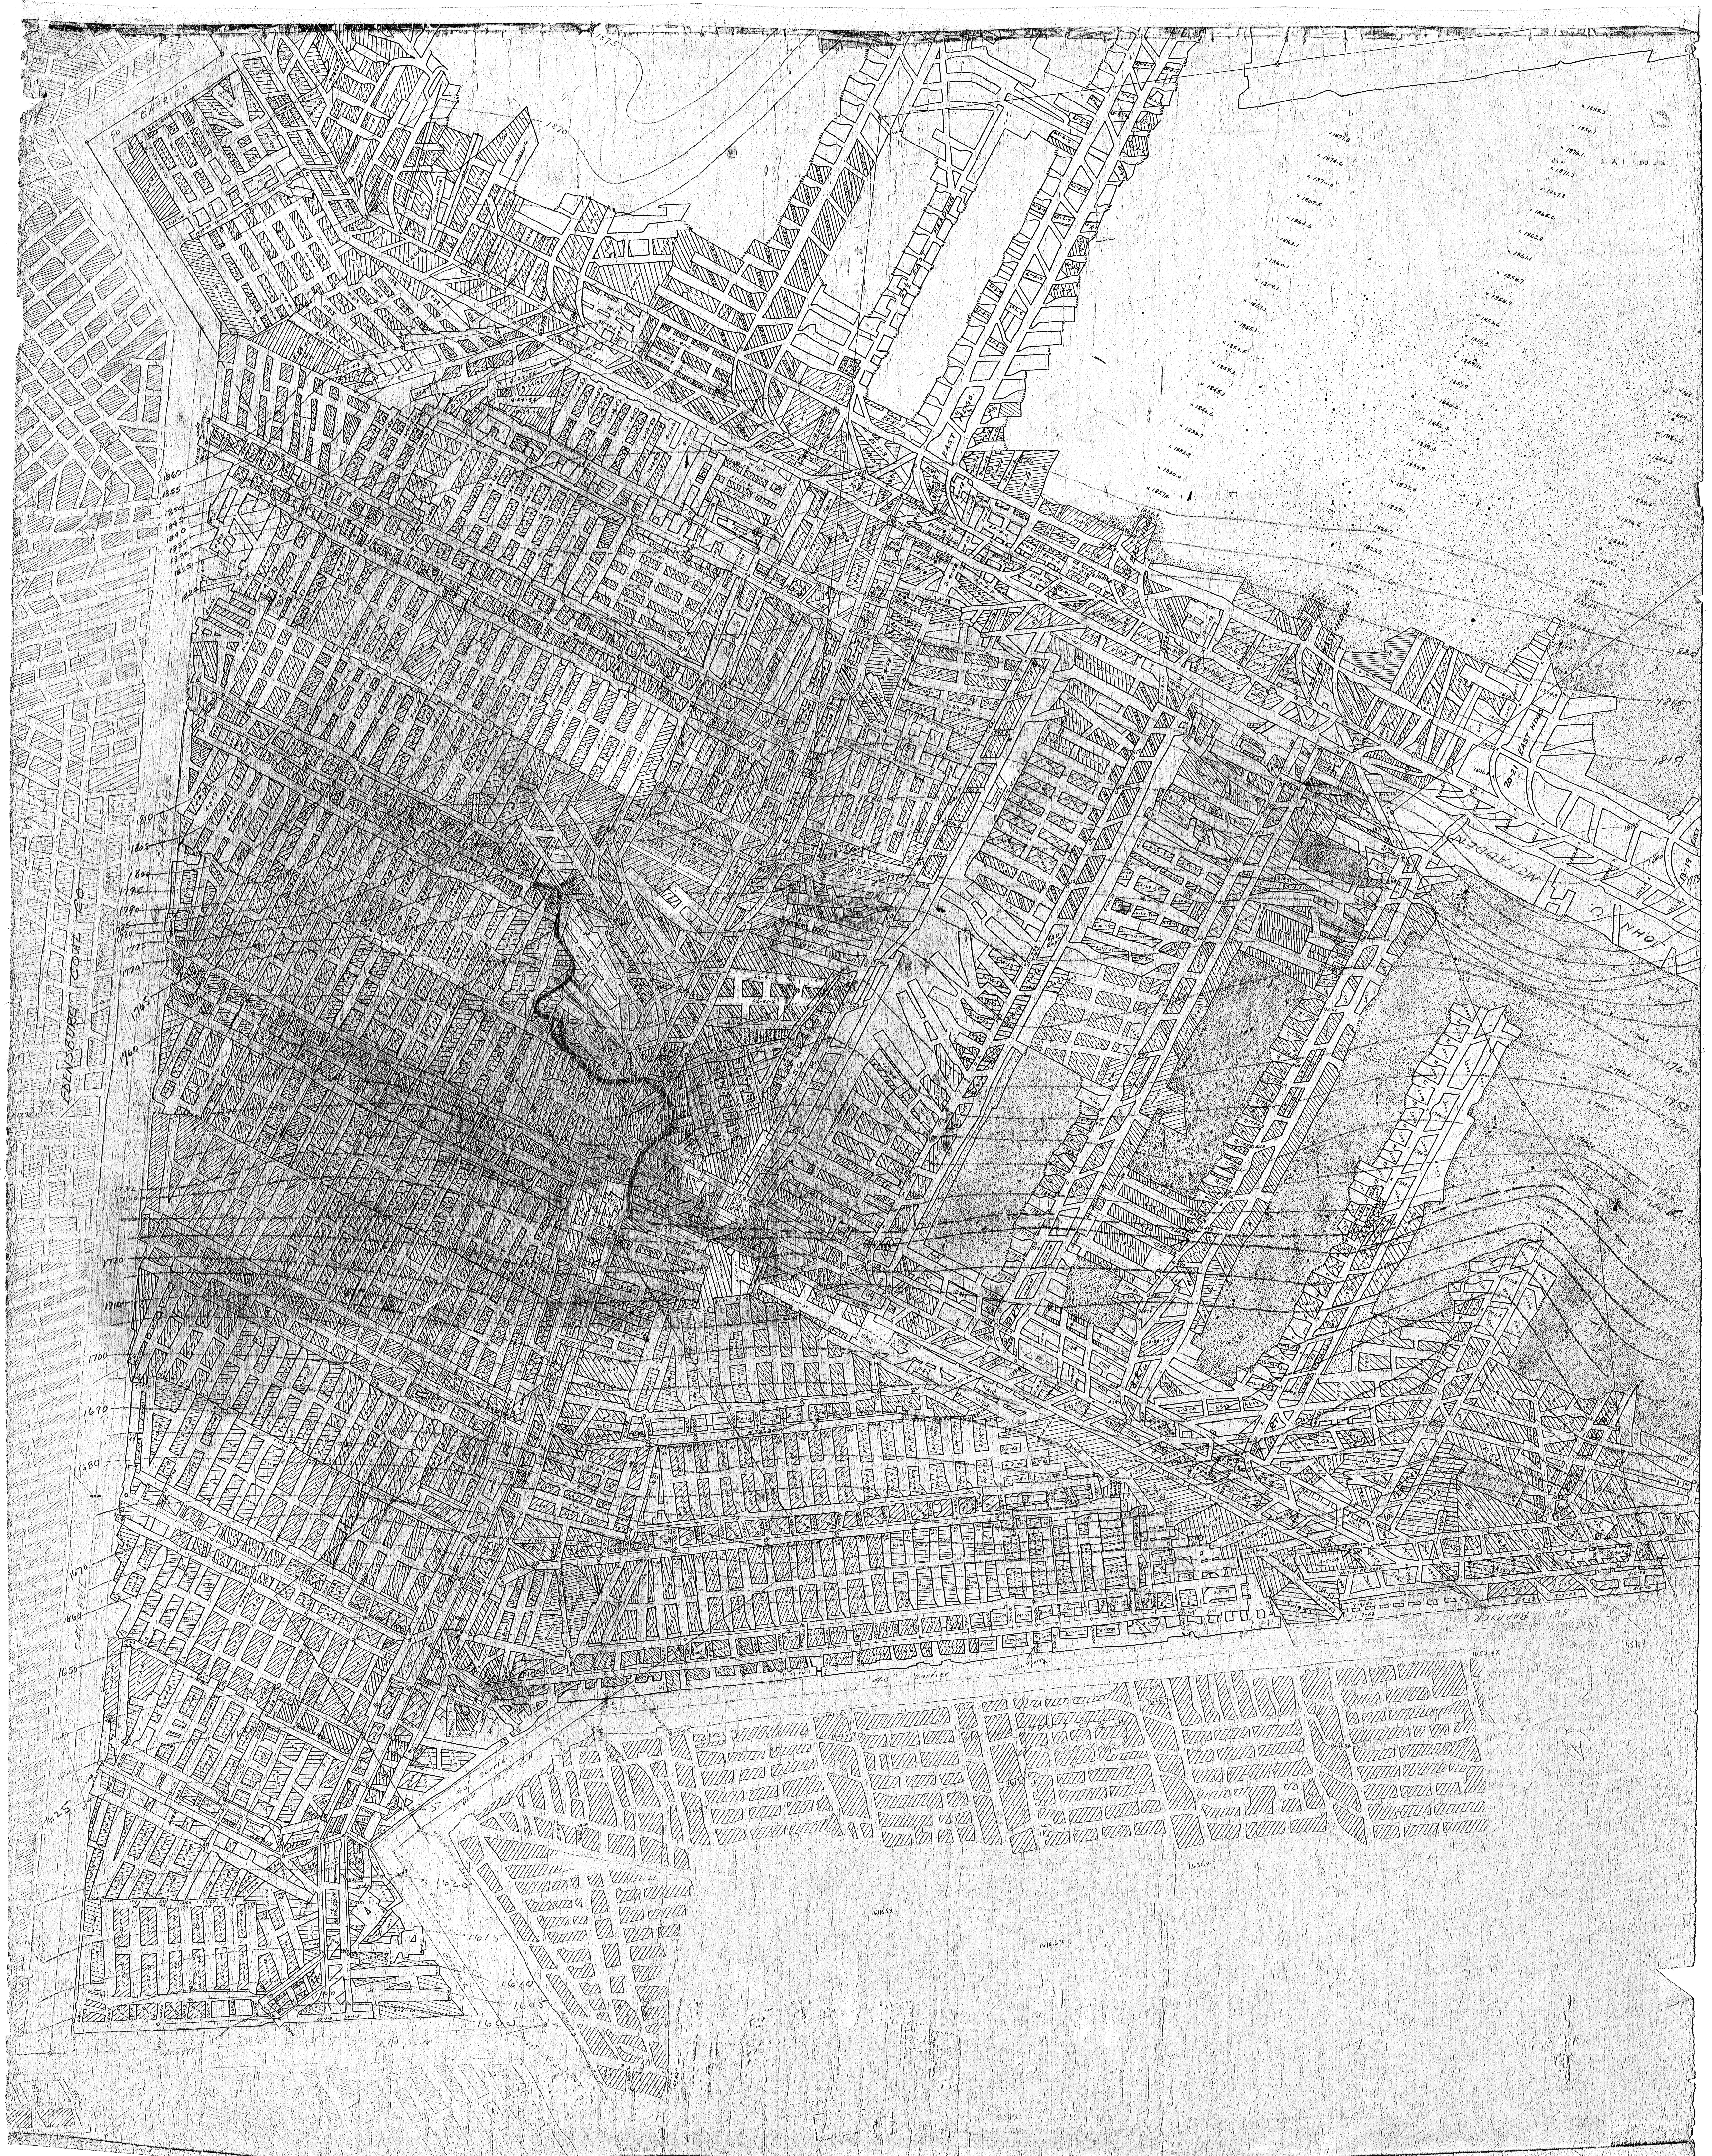
BARRIER
1875
1870
1860
1855
1850
1845
1840
1835
1830
1825
1820
1810
1805
1800
1795
1790
1785
1780
1775
1770
1765
1760
1732
1730
1720
1710
1700
1690
1680
1670
1664
1650
1640
1630
1625
1620
1615
1610
1605
1600
EBENSBURG COAL CO.
EAST HDGS
20-21
18-19
EAST
MCFADDEN
JOHN
1815
1810
1800
1795
1765
1760
1755
1745
1705
LOST
40' Barrier
BARRIER