


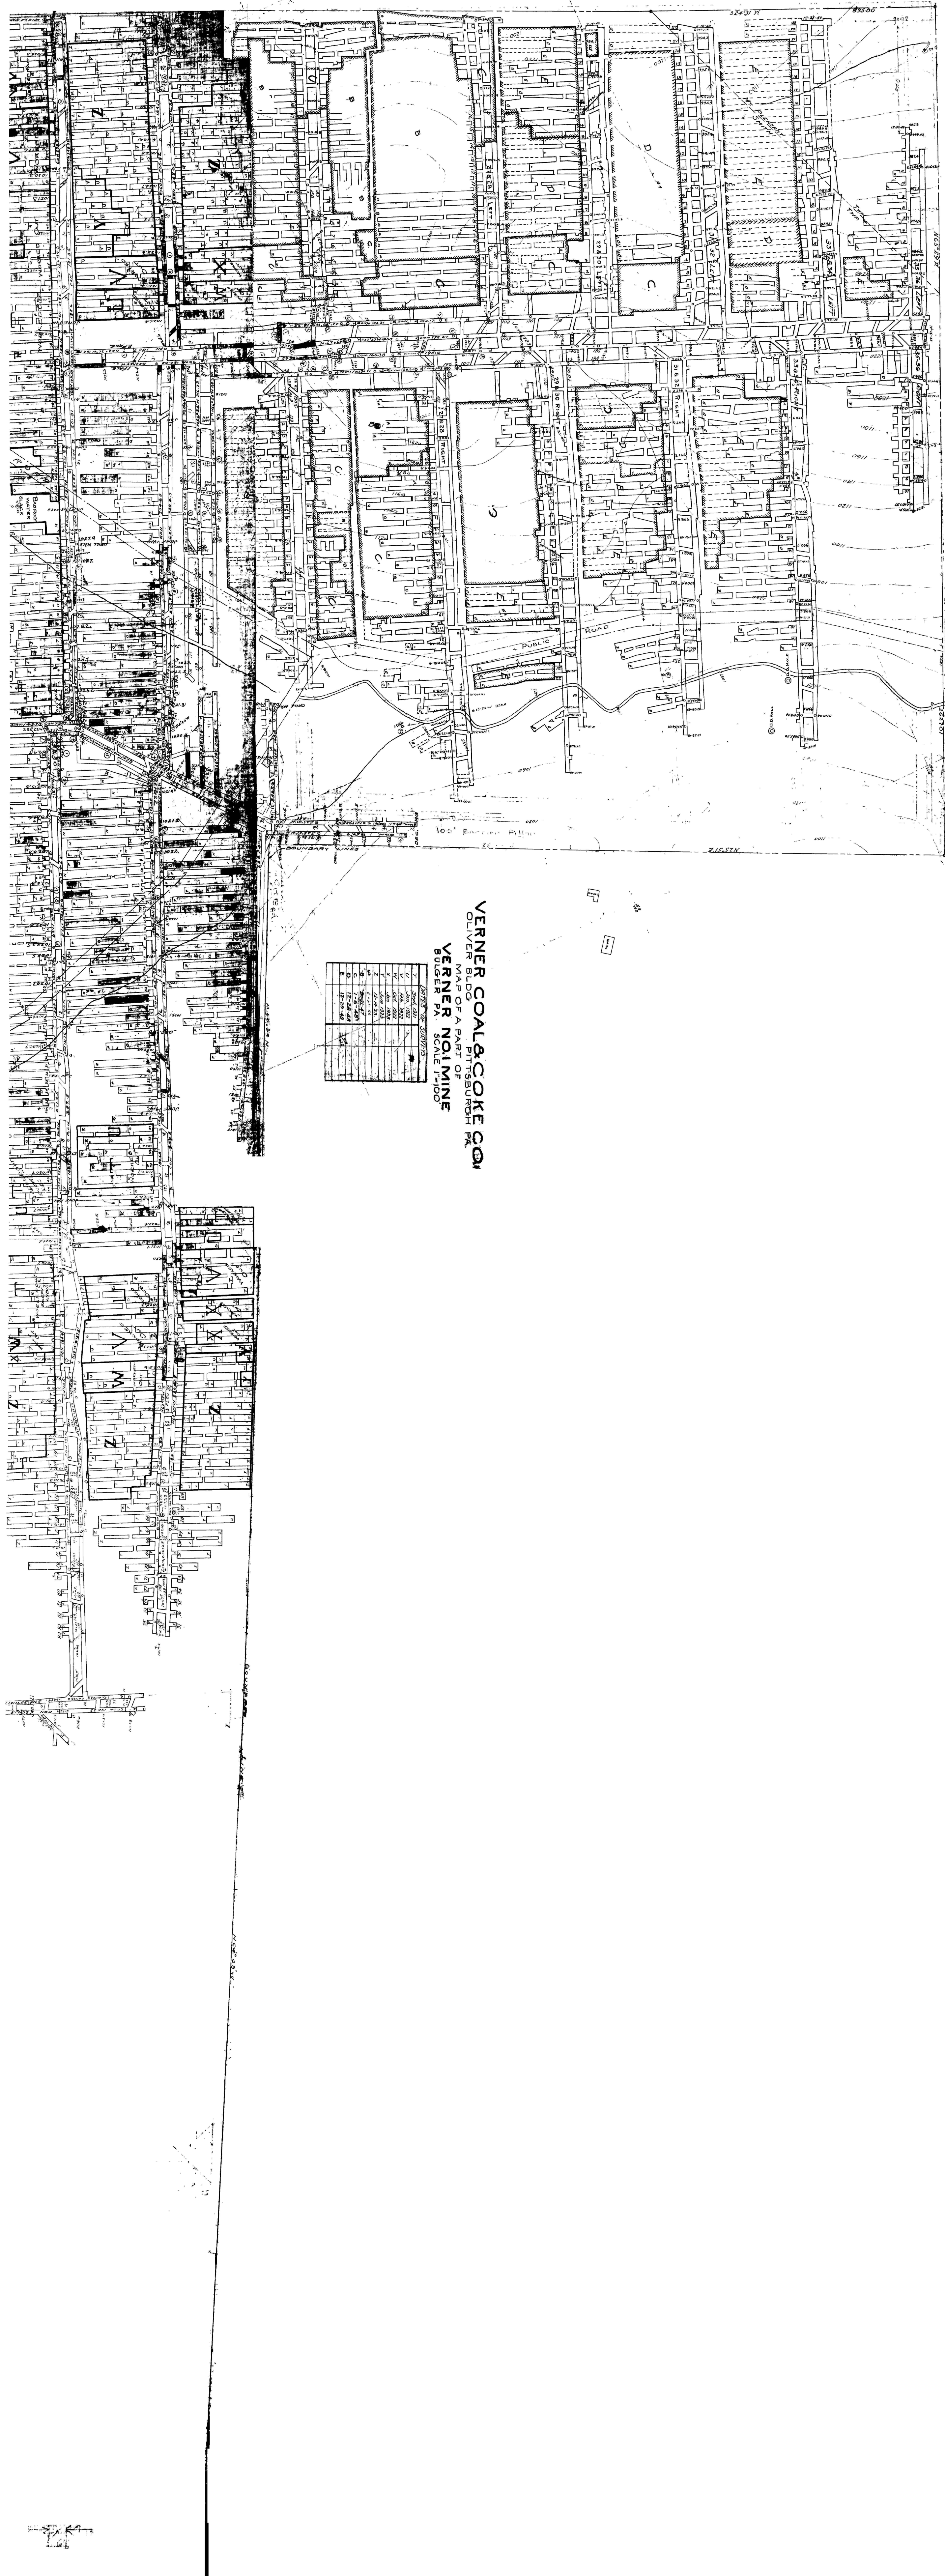

VERNER COAL & COKE CO.
OLIVER BLDG. OF A PART OF
VERNER NO. 1 MINE
PITTSBURGH, PA.
SCALE 1"=100'

