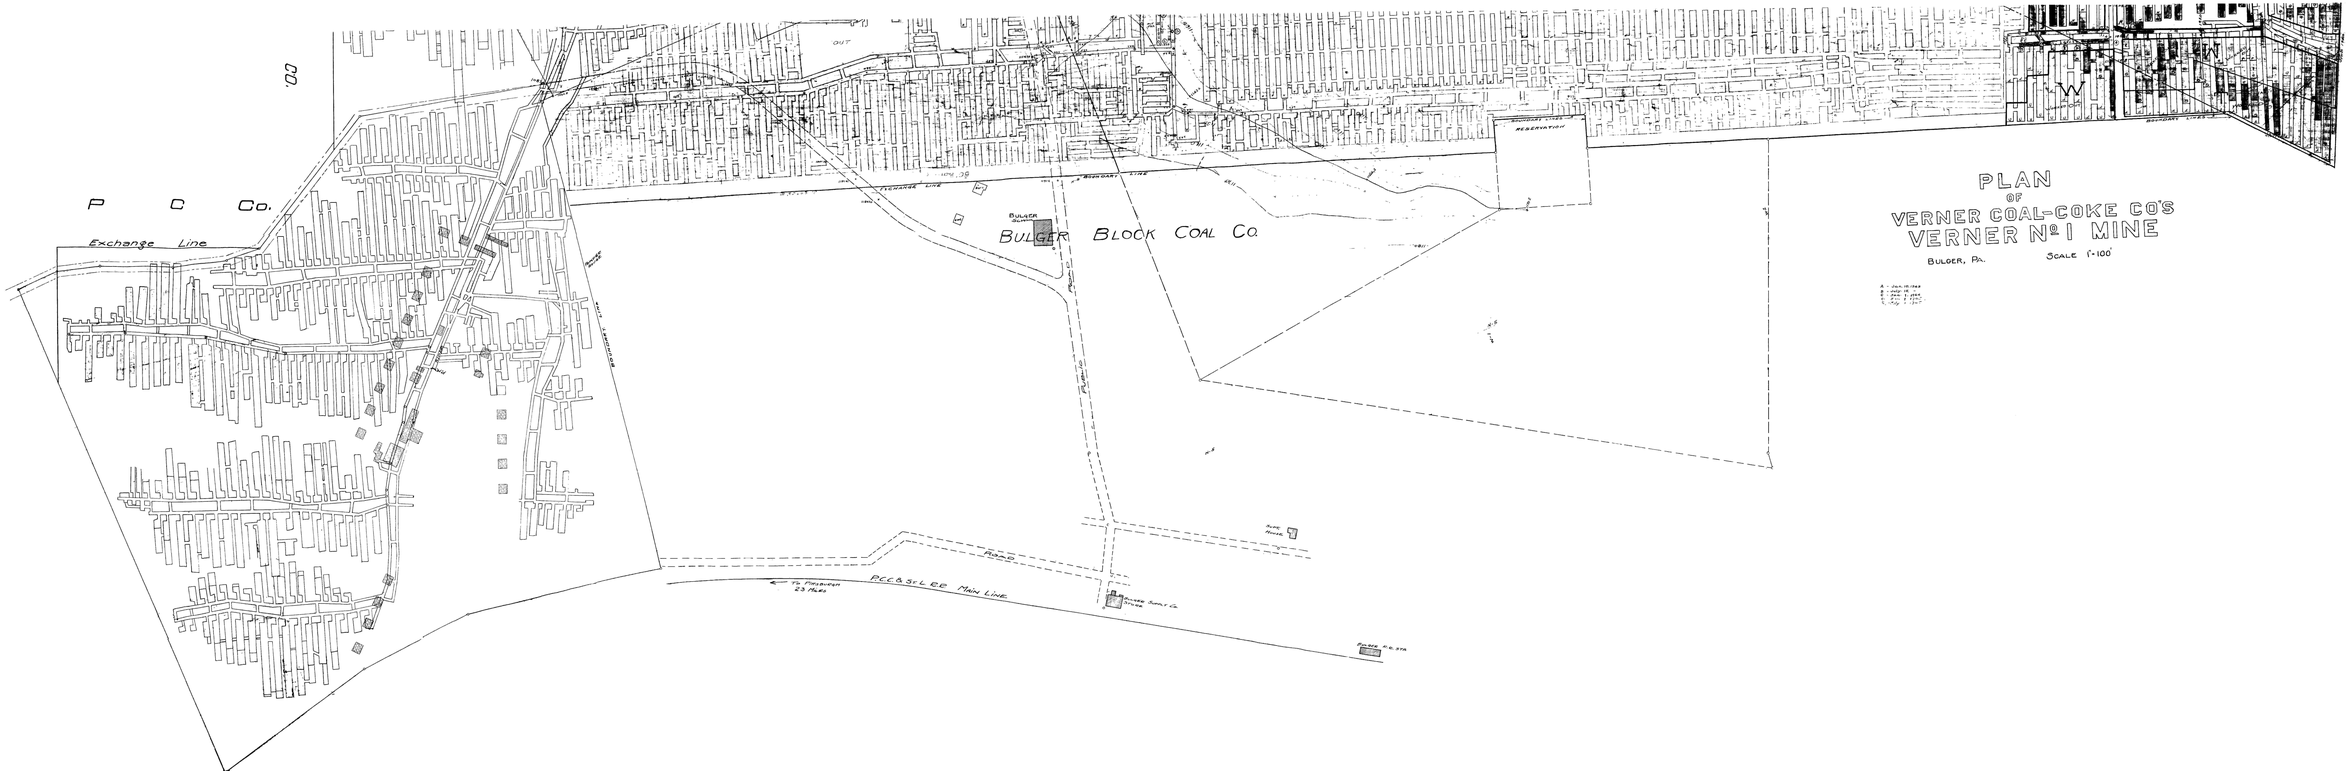
PLAN
OF
VERNER COAL-COKE CO'S
VERNER No 1 MINE
BULGER, PA.
SCALE 1"-100'
P C Co.
Exchange Line
BULGER BLOCK COAL CO.
RESERVATION
ROAD
P.C.C.&St.L.RR. Main Line
To Pittsburgh 23 Miles