




MATCH TO SHEET 31

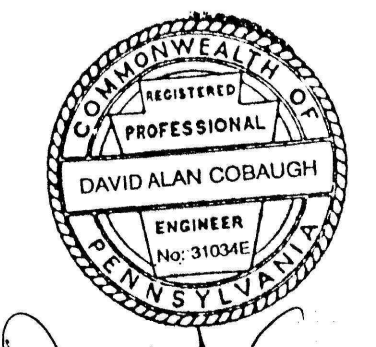

David A. Cabaugh

JANE MINE (MSHA) No. 3600823
JANE MINE PERMIT (DER) No. 03831305

(COAL SEAM)
LOWER FREEPORT

JANE MINE
KEYSTONE COAL MINING CORP.
PLUMCREEK & COWANSHANNOCK TWP. ARMSTRONG CO.

9-3-96
RTA

1"=400' scale
0 400 800 feet
N
POSTING DATE 12-31-1995
Final Mining