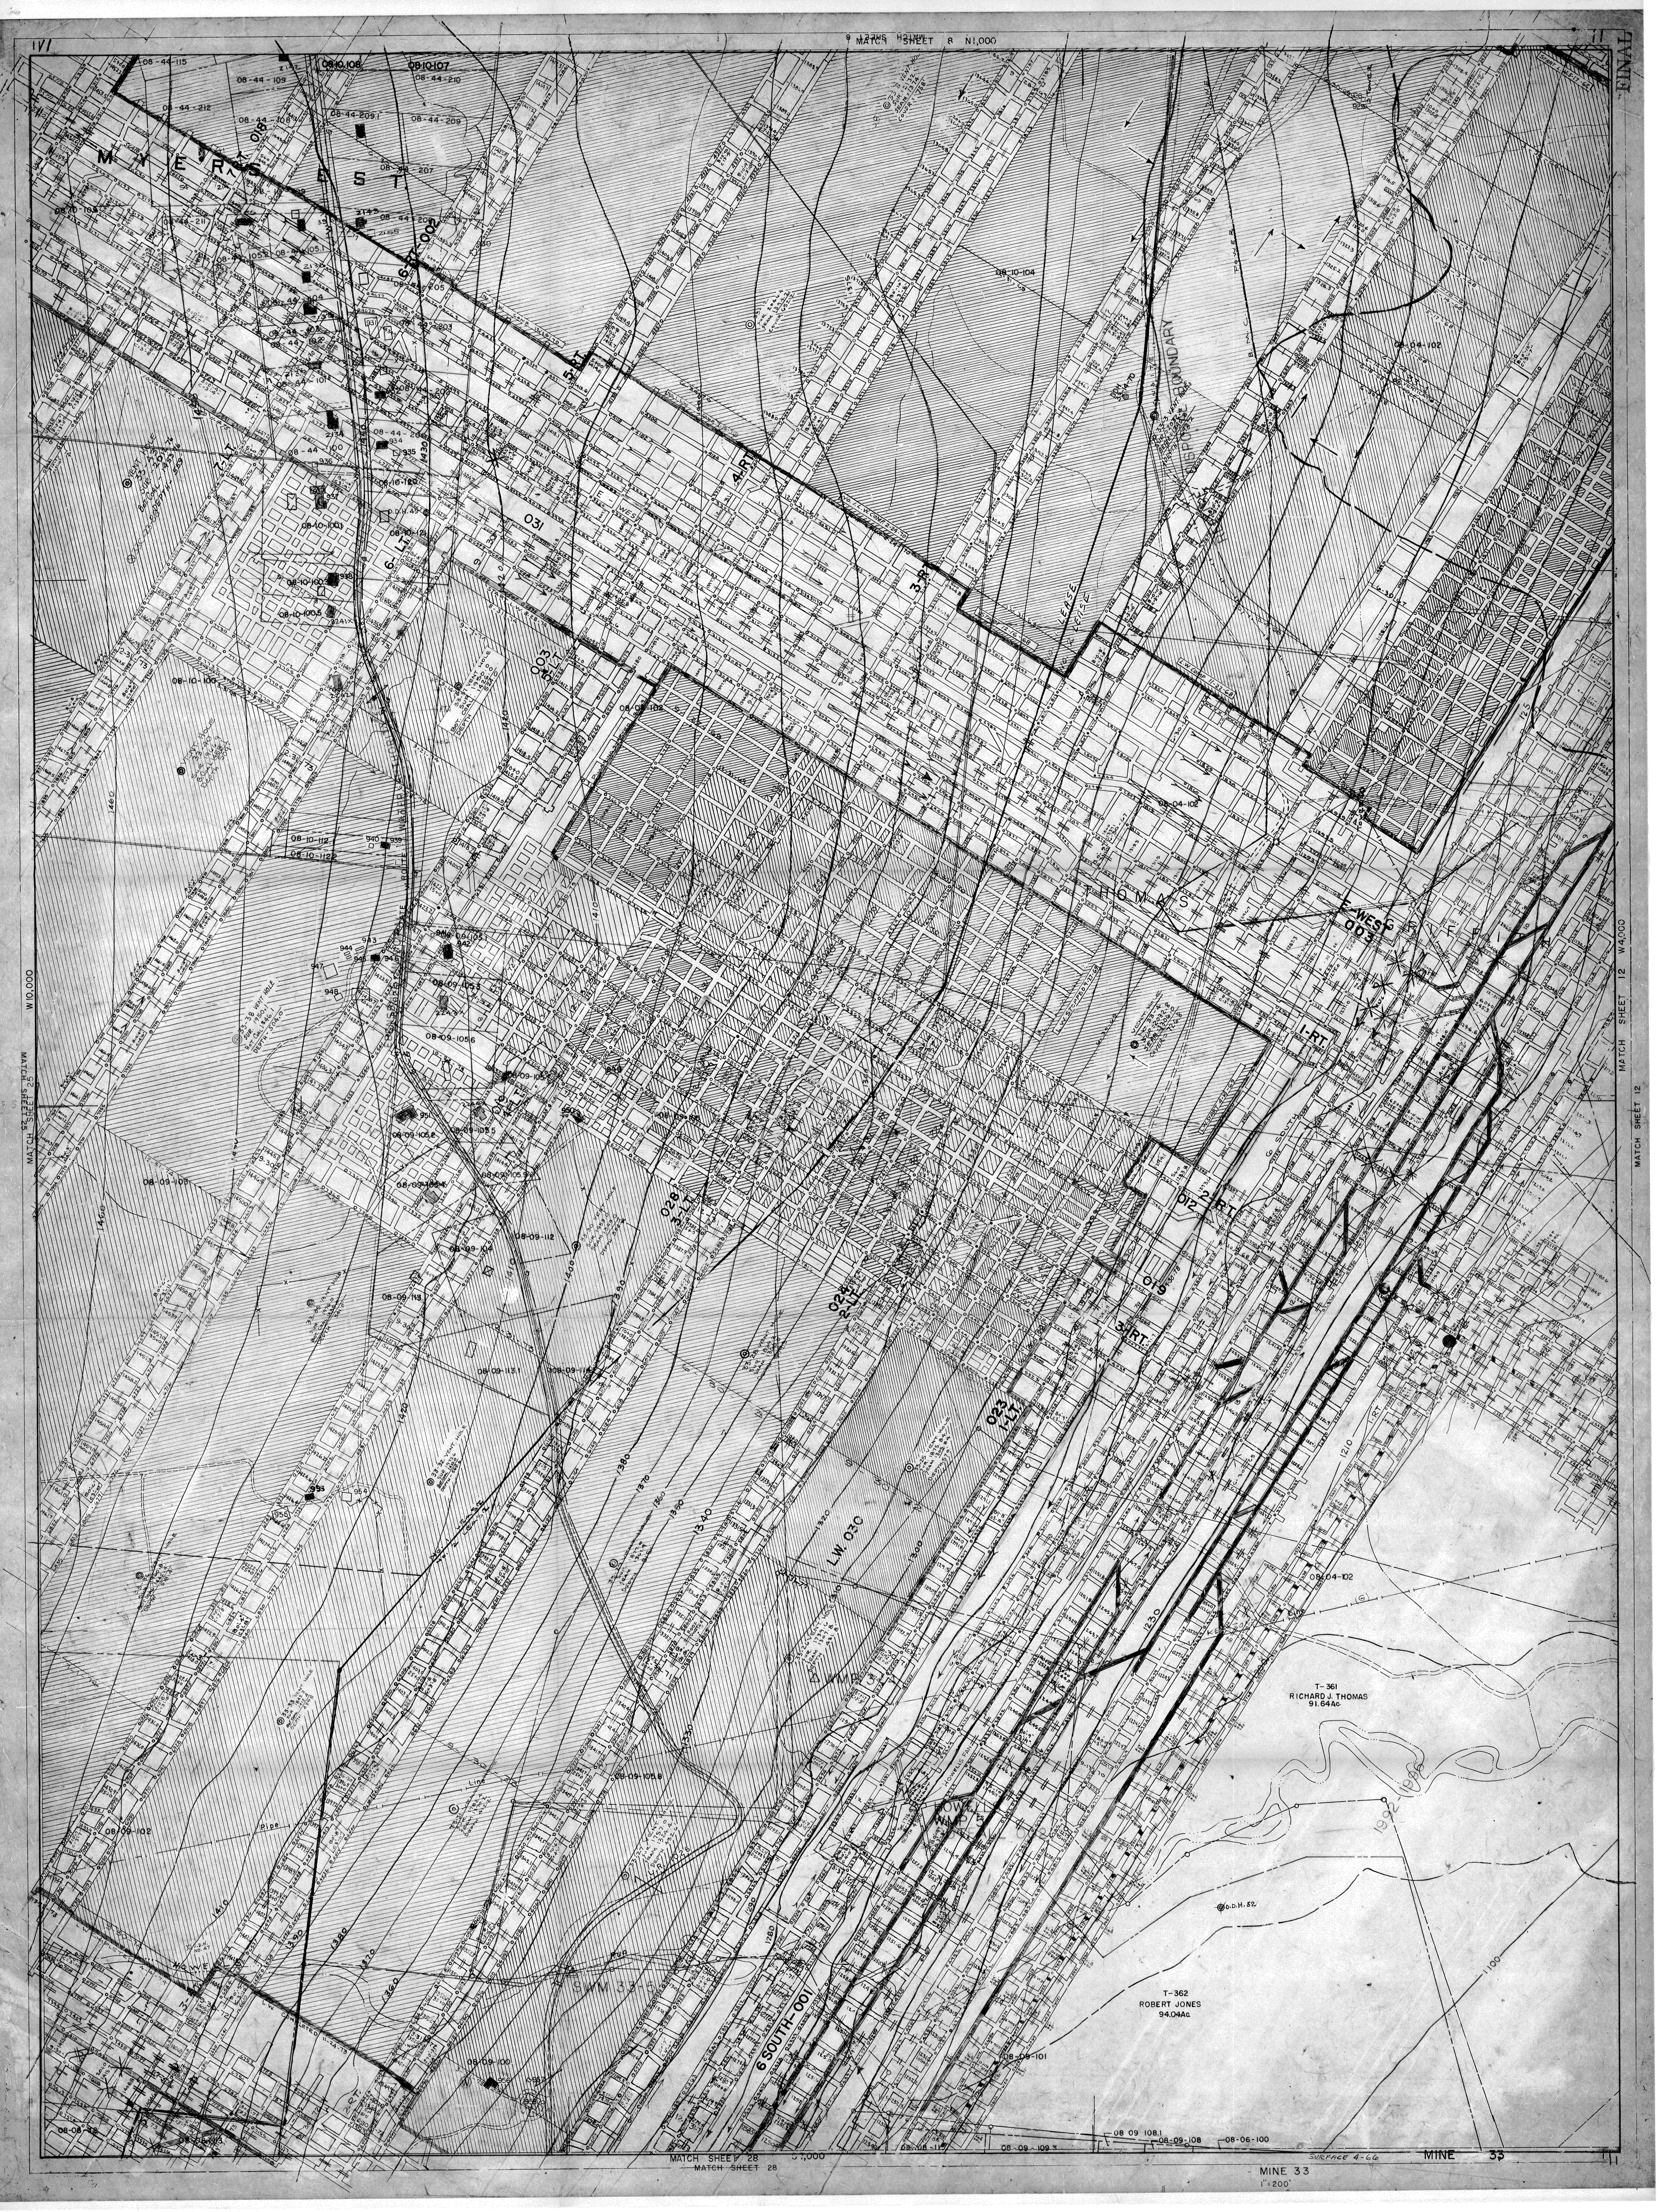
FINAL
MATCH SHEET 8 N1,000
MATCH SHEET 12 W4,000
MATCH SHEET 12
MATCH SHEET 25 W10,000
MATCH SHEET 28
MYERS
EAST
THOMAS
GRIFFITH
08-44-115
08-10-108
08-10-107
08-44-109
08-44-210
08-44-212
08-44-108
08-44-209.1
08-44-209
018
08-44-207
08-10-109
08-44-211
6-RT.-002
5-RT.
4-RT.
3-RT.
2-RT.
1-RT.
7-LT.
6-LT.
5-LT.
3-LT.
2-LT.
1-LT.
031
003
028
024
023
012
019
E-WEST 003
08-10-104
08-04-102
08-10-100
08-10-112
08-10-112.2
08-09-105.1
08-09-105.3
08-09-105.6
08-09-105.2
08-09-105.5
08-09-105.9
08-09-103
08-09-112
08-09-104
08-09-113
08-09-113.1
08-09-114
08-09-105.8
08-09-102
08-09-100
08-09-101
08-09-108.1
08-09-108
08-09-109.3
08-06-100
08-08-112
08-08-113
LEASE
DISPOSAL BOUNDARY
POWER LINE
L.W. 030
6 SOUTH-001
HOWELLS FAN
HOWELL WMP 5
SWM 33-5
WMP 3
T-361
RICHARD J. THOMAS
91.64Ac.
T-362
ROBERT JONES
94.04Ac.
D.D.H. 52
1100
1210
1230
1300
1320
1340
1350
1360
1370
1380
1390
1400
1410
1420
1430
1460
SURFACE 4-66
MINE 33

MINE 33
1"=200'