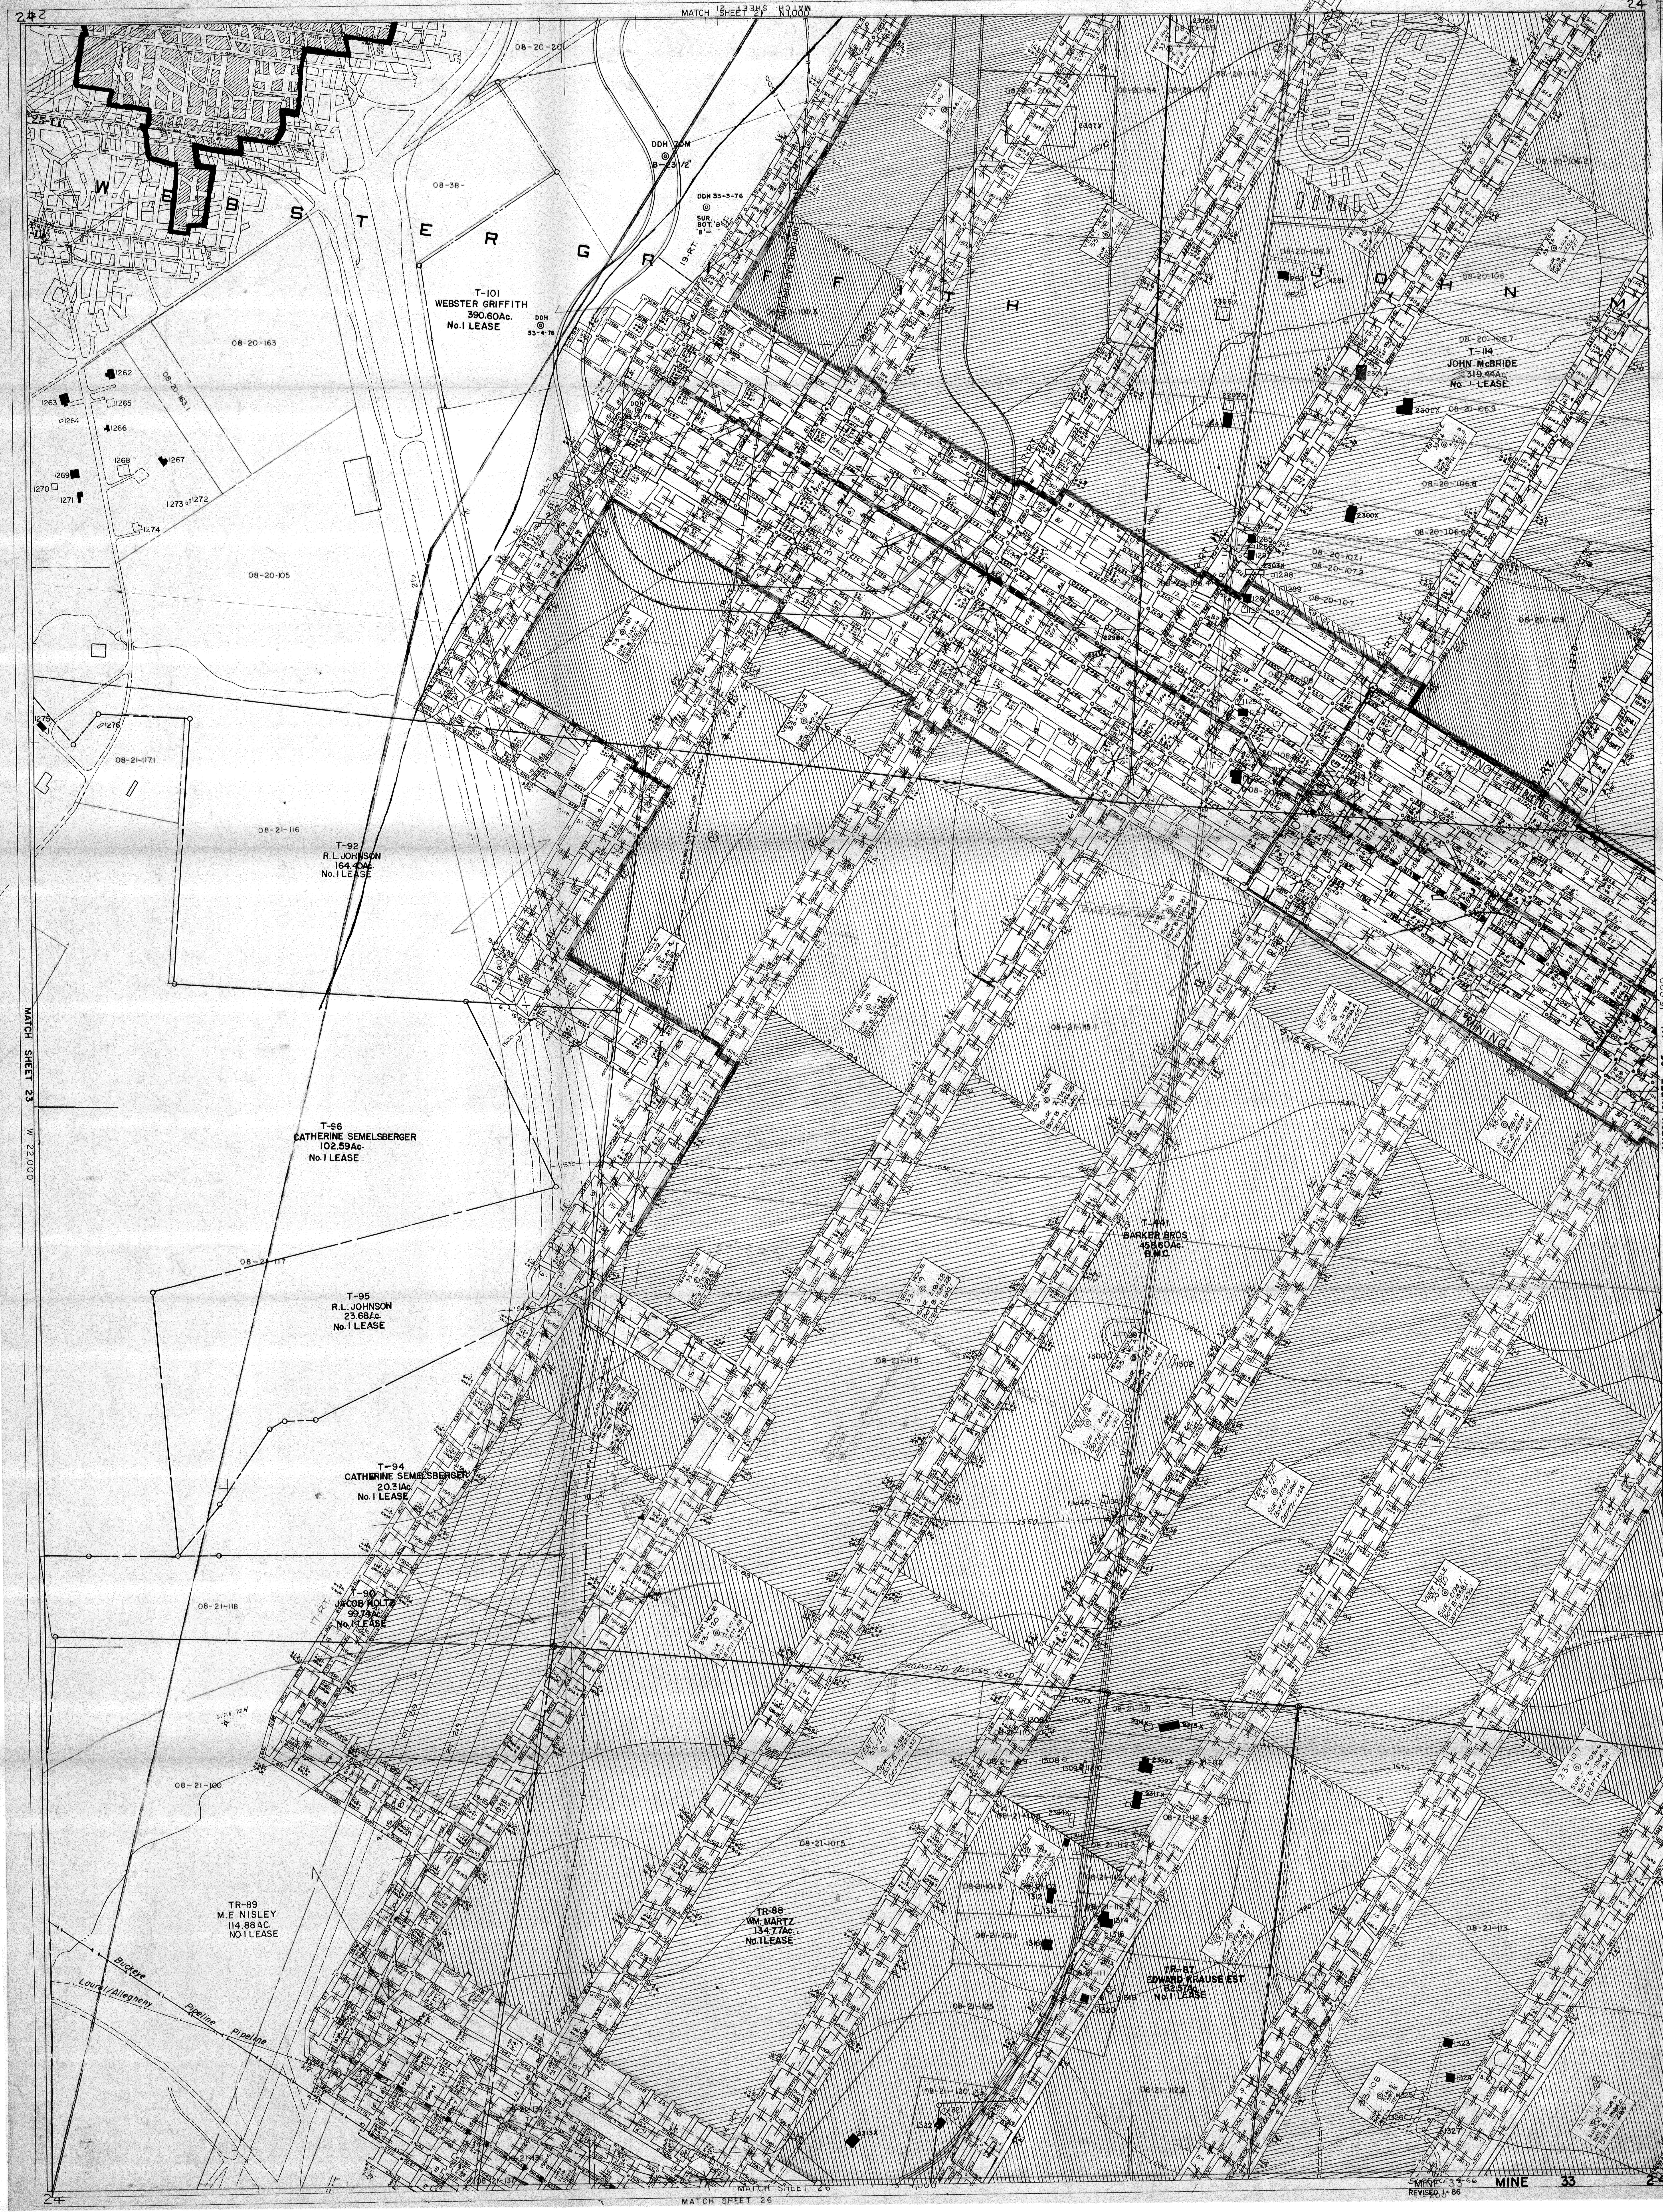
24
MATCH SHEET 21 N1,000
WEBSTER GRIFFITH
T-101
WEBSTER GRIFFITH
390.60Ac.
No.1 LEASE
DDH 70M
B-23 1/2"
DDH 33-3-76
DDH 33-4-76
08-20-201
08-38-
08-20-163
08-20-163.1
08-20-105
08-20-105.3
08-20-200
08-20-154
08-20-170
08-20-171
08-20-169
08-20-106.3
08-20-106.2
08-20-106
08-20-106.7
08-20-106.9
08-20-106.8
08-20-106.6
08-20-106.11
08-20-107.1
08-20-107.2
08-20-107
08-20-109
JOHN M
T-114
JOHN McBRIDE
319.44Ac.
No. 1 LEASE
VENT HOLE 33-100
VENT HOLE 33-101
VENT HOLE 33-103
VENT HOLE 33-102
VENT HOLE 33-104
VENT HOLE 33-105
VENT HOLE 33-118
VENT HOLE 33-115
VENT HOLE 33-115A
VENT HOLE 33-112
VENT HOLE 33-119
VENT HOLE 33-116
VENT HOLE 33-113
VENT HOLE 33-110
VENT HOLE 33-117
VENT HOLE 33-114
VENT HOLE 33-120
33-107
SUR. 2105.6
BOT. B. 1564.6
DEPTH 541
33-108
33-91
NO MINING
PEOPLES NATURAL GAS PIPE LINE
MATCH SHEET 23 W 22,000
MATCH SHEET 25 W 16,000
08-21-117.1
08-21-116
T-92
R.L. JOHNSON
164.40Ac.
No. 1 LEASE
T-96
CATHERINE SEMELSBERGER
102.59Ac.
No. 1 LEASE
08-21-117
T-95
R.L. JOHNSON
23.68Ac.
No. 1 LEASE
T-94
CATHERINE SEMELSBERGER
20.31Ac.
No. 1 LEASE
08-21-118
T-90
JACOB HOLTZ
99.74Ac.
No. 1 LEASE
D.D.H. 72H
08-21-100
TR-89
M.E. NISLEY
114.88 AC.
NO. 1 LEASE
Buckeye Pipeline
Laurel/Allegheny Pipeline
08-21-115.1
08-21-115
T-441
BARKER BROS.
458.60Ac.
B.M.C.
EXISTING ACCESS ROAD
PROPOSED ACCESS ROAD
08-21-121
08-21-122
08-21-110
08-21-109
08-21-108
08-21-112.4
08-21-112.3
08-21-112.1
08-21-101.5
08-21-101.3
08-21-101.1
08-21-112.5
08-21-111
08-21-125
08-21-120
08-21-112.2
08-21-113
08-21-139
08-21-136
08-21-137
TR-88
WM. MARTZ
134.77Ac.
No. 1 LEASE
TR-87
EDWARD KRAUSE EST.
82.57Ac.
No. 1 LEASE
MATCH SHEET 26
S 4,000
MINE 33
SURFACE 4-66
REVISED 1-86
24

FINAL