


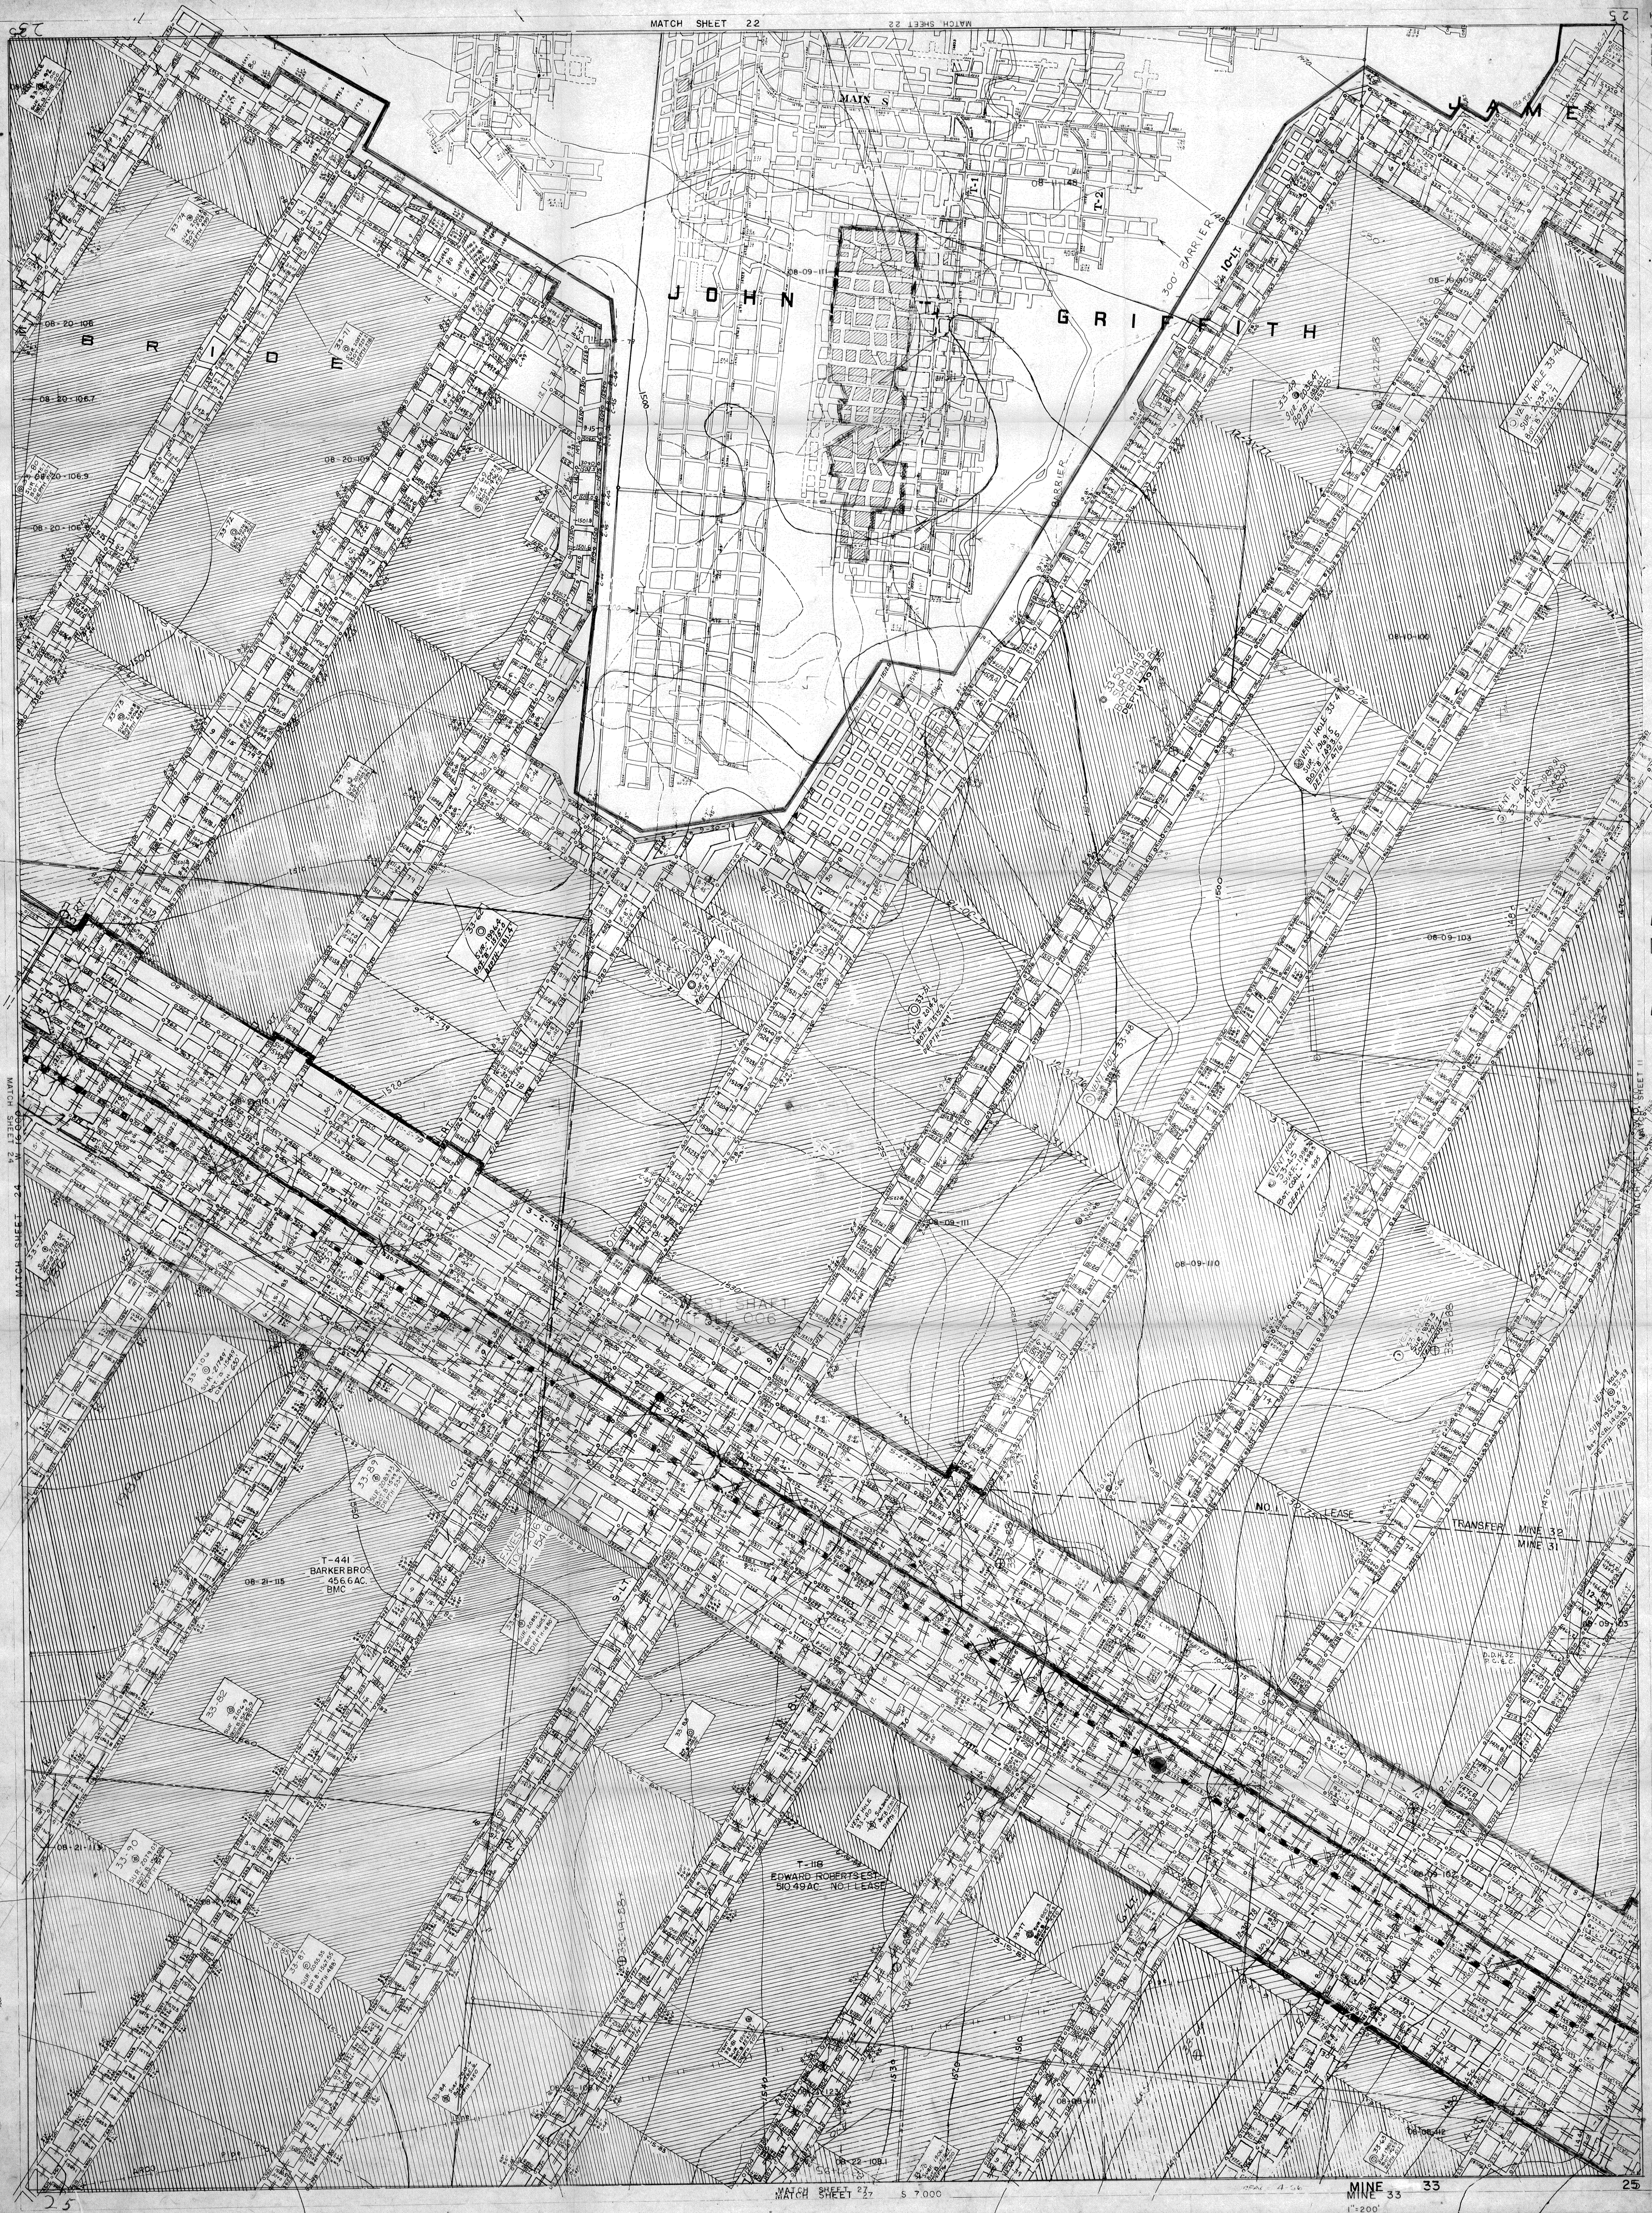

MATCH SHEET 22

JOHN

GRIFFITH

300' BARRIER

T-441
BARKER BROS
456.6 AC
BMC

T-118

NO LEASE

TRANSFER MINE 32
MINE 31


MINE 33 33
1"=200'