



LEGEND


DRILL HOLES

- COAL INTERSECTED OF MINEABLE THICKNESS
- COAL INTERSECTED BELOW MINEABLE THICKNESS
- NO COAL INTERSECTED

CORE HOLES


- COAL INTERSECTED OF MINEABLE THICKNESS
- COAL INTERSECTED BELOW MINEABLE THICKNESS
- NO COAL INTERSECTED

1982 WORKINGS
 FAULTY AREAS
 MAIN TRACK
 ABD - ACTIVE WELLS
 MG SETS - RECTIFIERS
 PUMPS TO OUTSIDE
 RESERVES
 SURFACE OWNED
 BELT

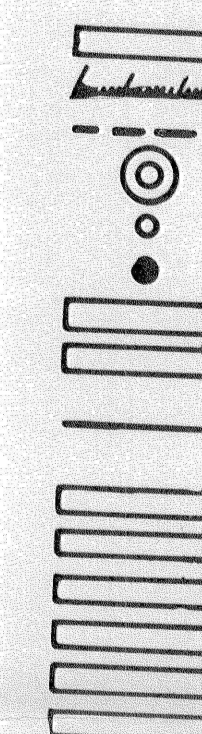

1983
 JANUARY
 FEBRUARY
 MARCH
 APRIL
 MAY
 JUNE
 JULY
 AUGUST
 SEPTEMBER
 OCTOBER
 NOVEMBER
 DECEMBER

RENTON MINE
 1986
 1"-500'

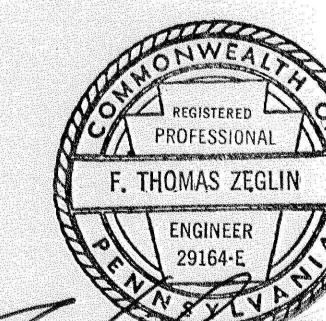

F. Thomas Zeglin

ATTACH RENT A8
 VILLA COAL COMPANY, INC.
 SCALE: 1"=500' SHEET 1 OF 4