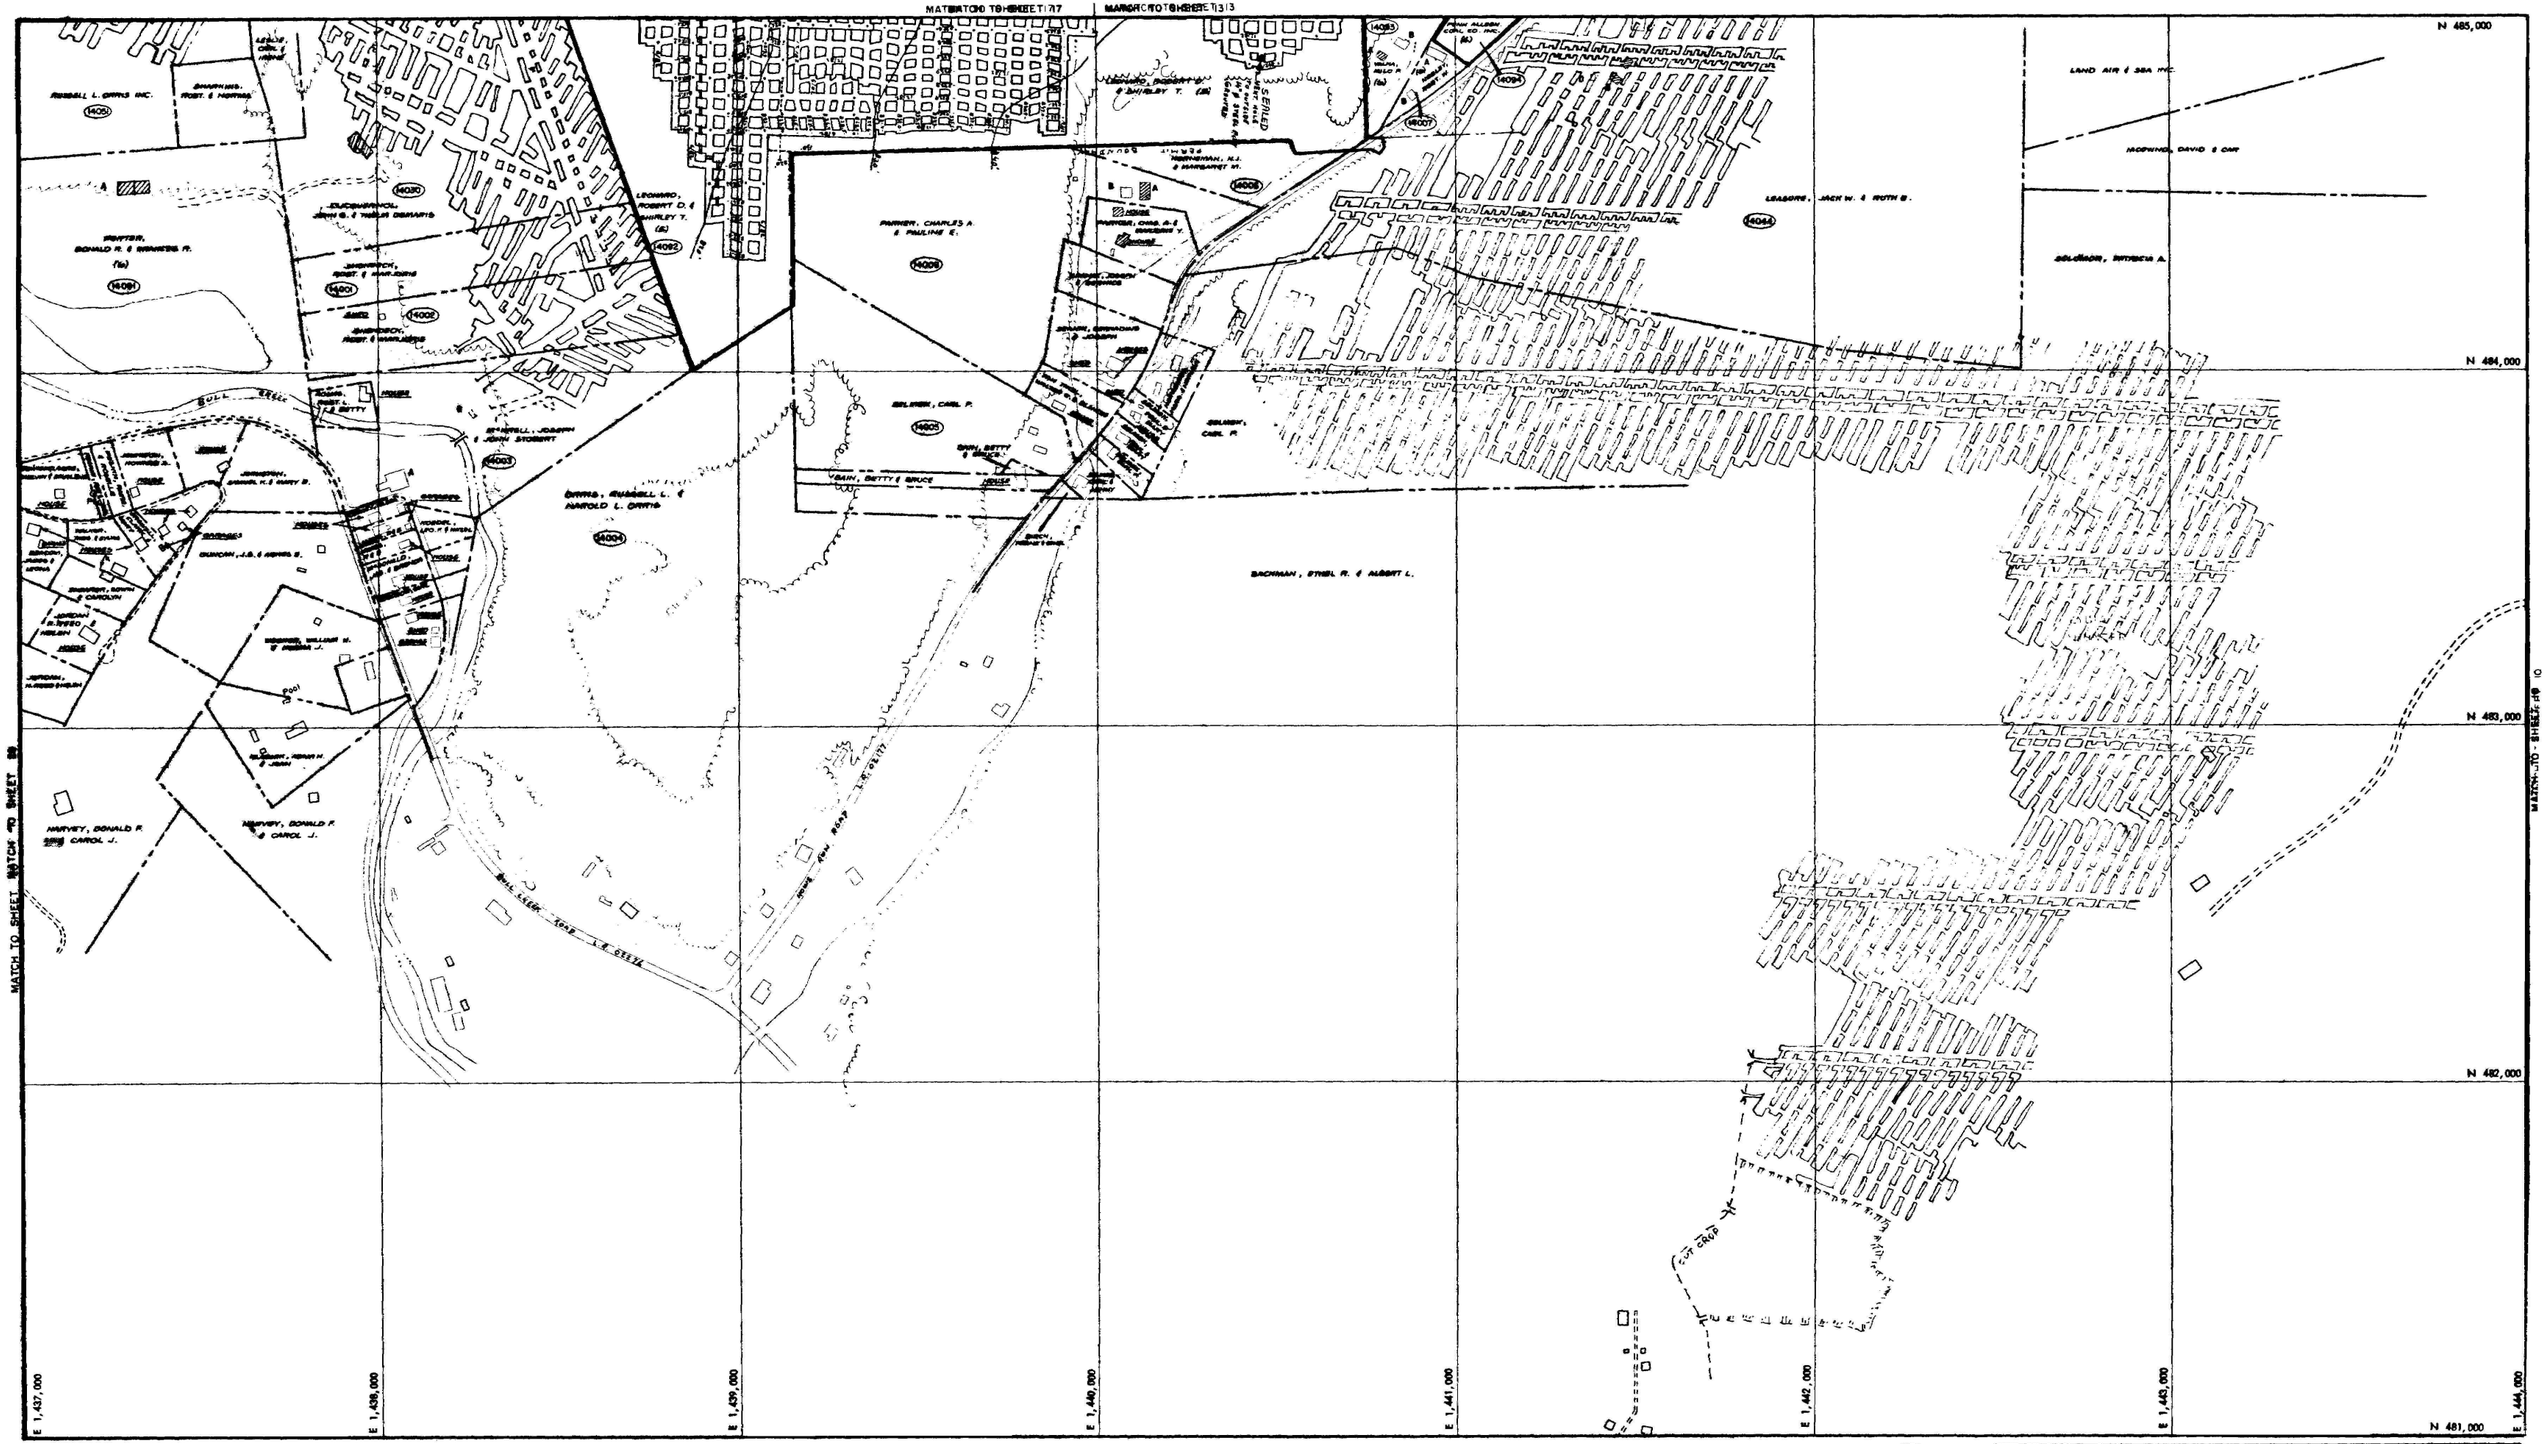

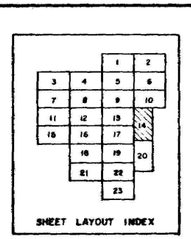

SHEET LAYOUT INDEX

LEGEND FOR MINERAL OWNERSHIP

(1) WOOD COAL - LEASE
(2) PILGRIM COAL - LEASE
(3) MUSE COAL - LEASE
(4) PENN ALLEGH COAL PROPERTY
(5) FAWN DEVELOPMENT CORP.
(6) DO NOT OWN

LEGEND FOR THE 6 MONTH SURFACE SUPPORT PROJECTIONS

AREA OF PROJECTED MINING FROM: ____ TO: ____
AREA OF 50% MINING
PROTECTED STRUCTURE
STRUCTURE
SURVEY STATION 4589+
ELEVATION 820.1 -
SINGLE LINE PROJECTION OF ENTRIES & CROSSCUTS HAVING A MAXIMUM WIDTH OF 20 FEET

NOTE: ANY PROJECTED COAL PILLAR FULLY OR PARTIALLY WITHIN AN AREA DESIGNATED FOR 50% MINING SHALL BE LEFT IN PLACE INTACT

COMMONWEALTH OF PENNSYLVANIA
REGISTERED PROFESSIONAL
ALFRED REISZ
ENGINEER
NO. 14613-E

Alfred Reisz

ALLEGHENY No. 2 & PORTAL No. 3 MINE

UPPER FREEPORT COAL SEAM

ALLEGHENY COUNTY: FAWN, FRAZER & HARRISON TOWNSHIPS

BUTLER COUNTY: BUFFALO & CLINTON TOWNSHIPS

PENN ALLEGH COAL CO., INC.

ADDRESS: BOX 238A, RD 2, TARENTUM, PA. 15084

SCALE 1" = 200'

FINAL SURVEY DATE: 7/31/72

SHEET No. 14