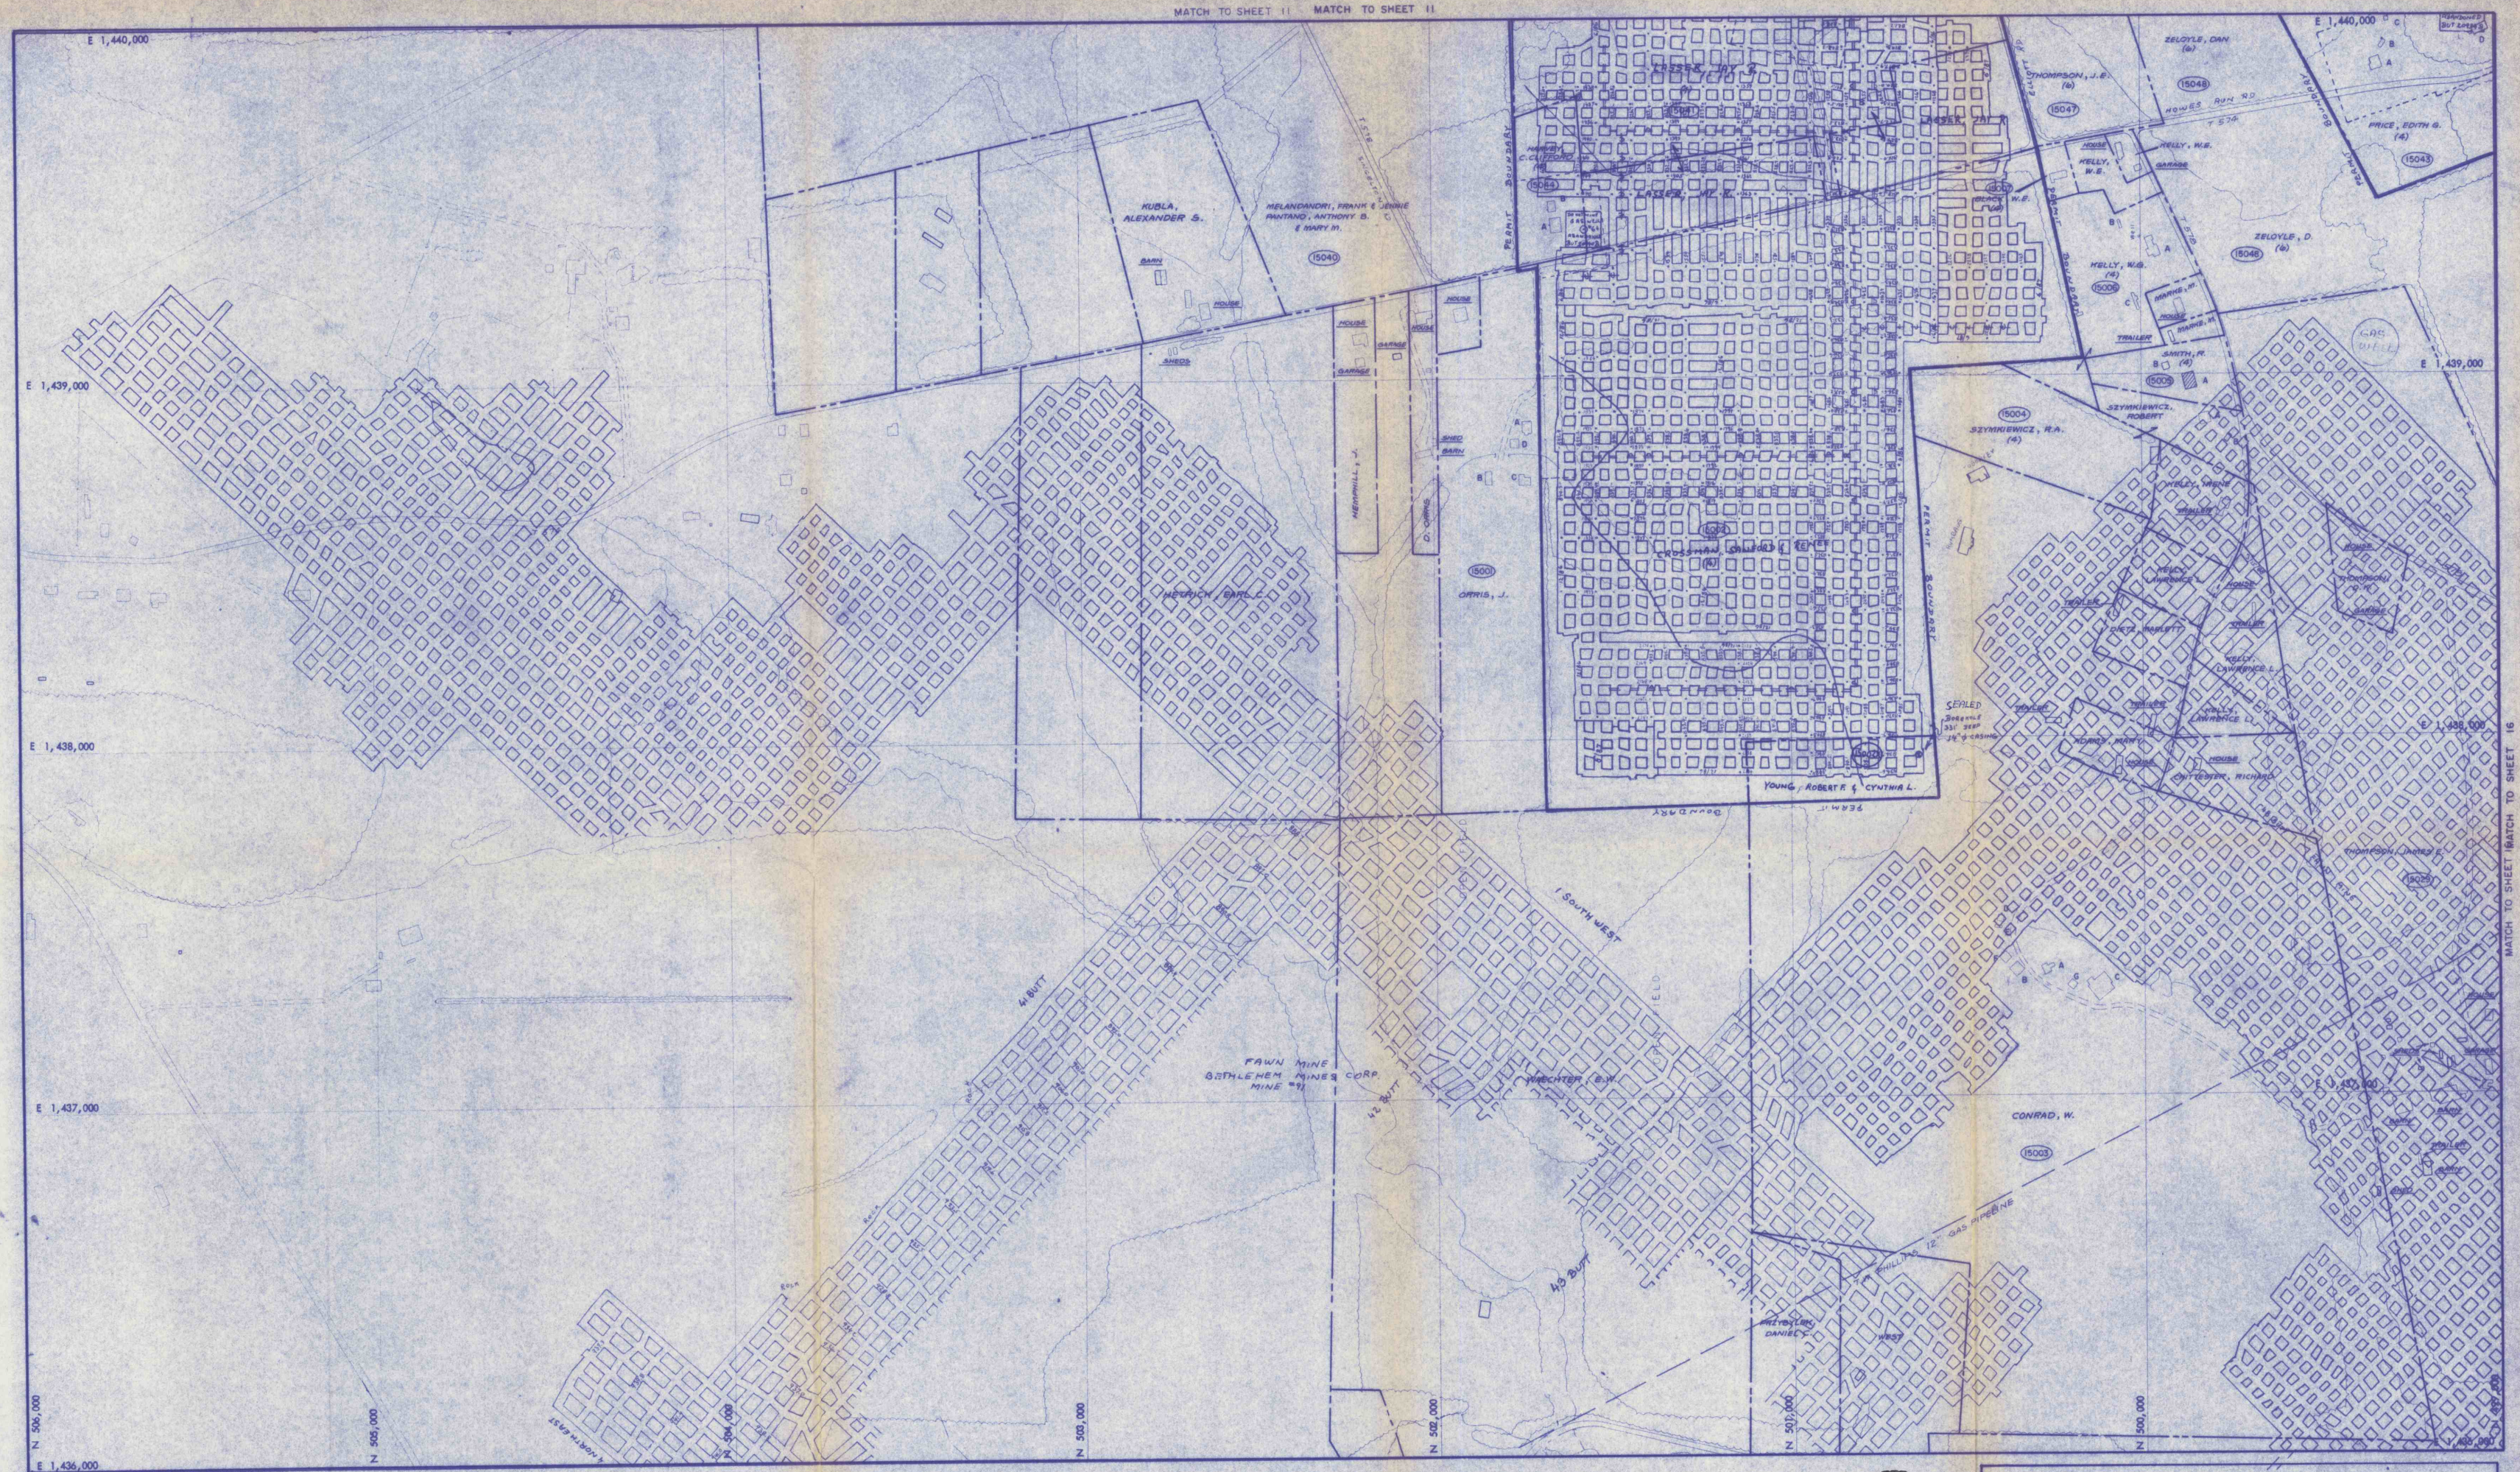


SHEET LAYOUT INDEX

1	2
3	4
5	6
7	8
9	10
11	12
13	14
15	16
17	18
19	20
21	22
23	24

LEGEND FOR MINERAL OWNERSHIP

(1)	WOOD COAL - LEASE
(2)	PILGRIM COAL - LEASE
(3)	MUSE COAL - LEASE
(4)	PENN ALLEGH COAL PROPERTY
(5)	FAWN DEVELOPMENT CORP.
(6)	DO NOT OWN

LEGEND FOR THE 6 MONTH SURFACE SUPPORT PROJECTIONS

AREA OF PROJECTED MINING FROM TO	SURVEY STATION
AREA OF 50% MINING	ELEVATION
PROTECTED STRUCTURE	SINGLE LINE PROJECTION OF ENTRIES & CROSSCUTS HAVING A MAXIMUM WIDTH OF 20 FEET
STRUCTURE	

NOTE: ANY PROJECTED COAL PILLAR FULLY OR PARTIALLY WITHIN AN AREA DESIGNATED FOR 50% MINING SHALL BE LEFT IN PLACE INTACT



ALLEGHENY No. 2 & PORTAL No. 3 MINE
UPPER FREEPORT COAL SEAM
ALLEGHENY COUNTY: FAWN, FRAZER & HARRISON TOWNSHIPS
BUTLER COUNTY: BUFFALO & CLINTON TOWNSHIPS
PENN ALLEGH COAL CO., INC.
ADDRESS: BOX 238A, RD 2, TARENTUM, PA. 15084
SCALE 1" = 200' SURVEY DATE: 7/31/92 SHEET No. 15