


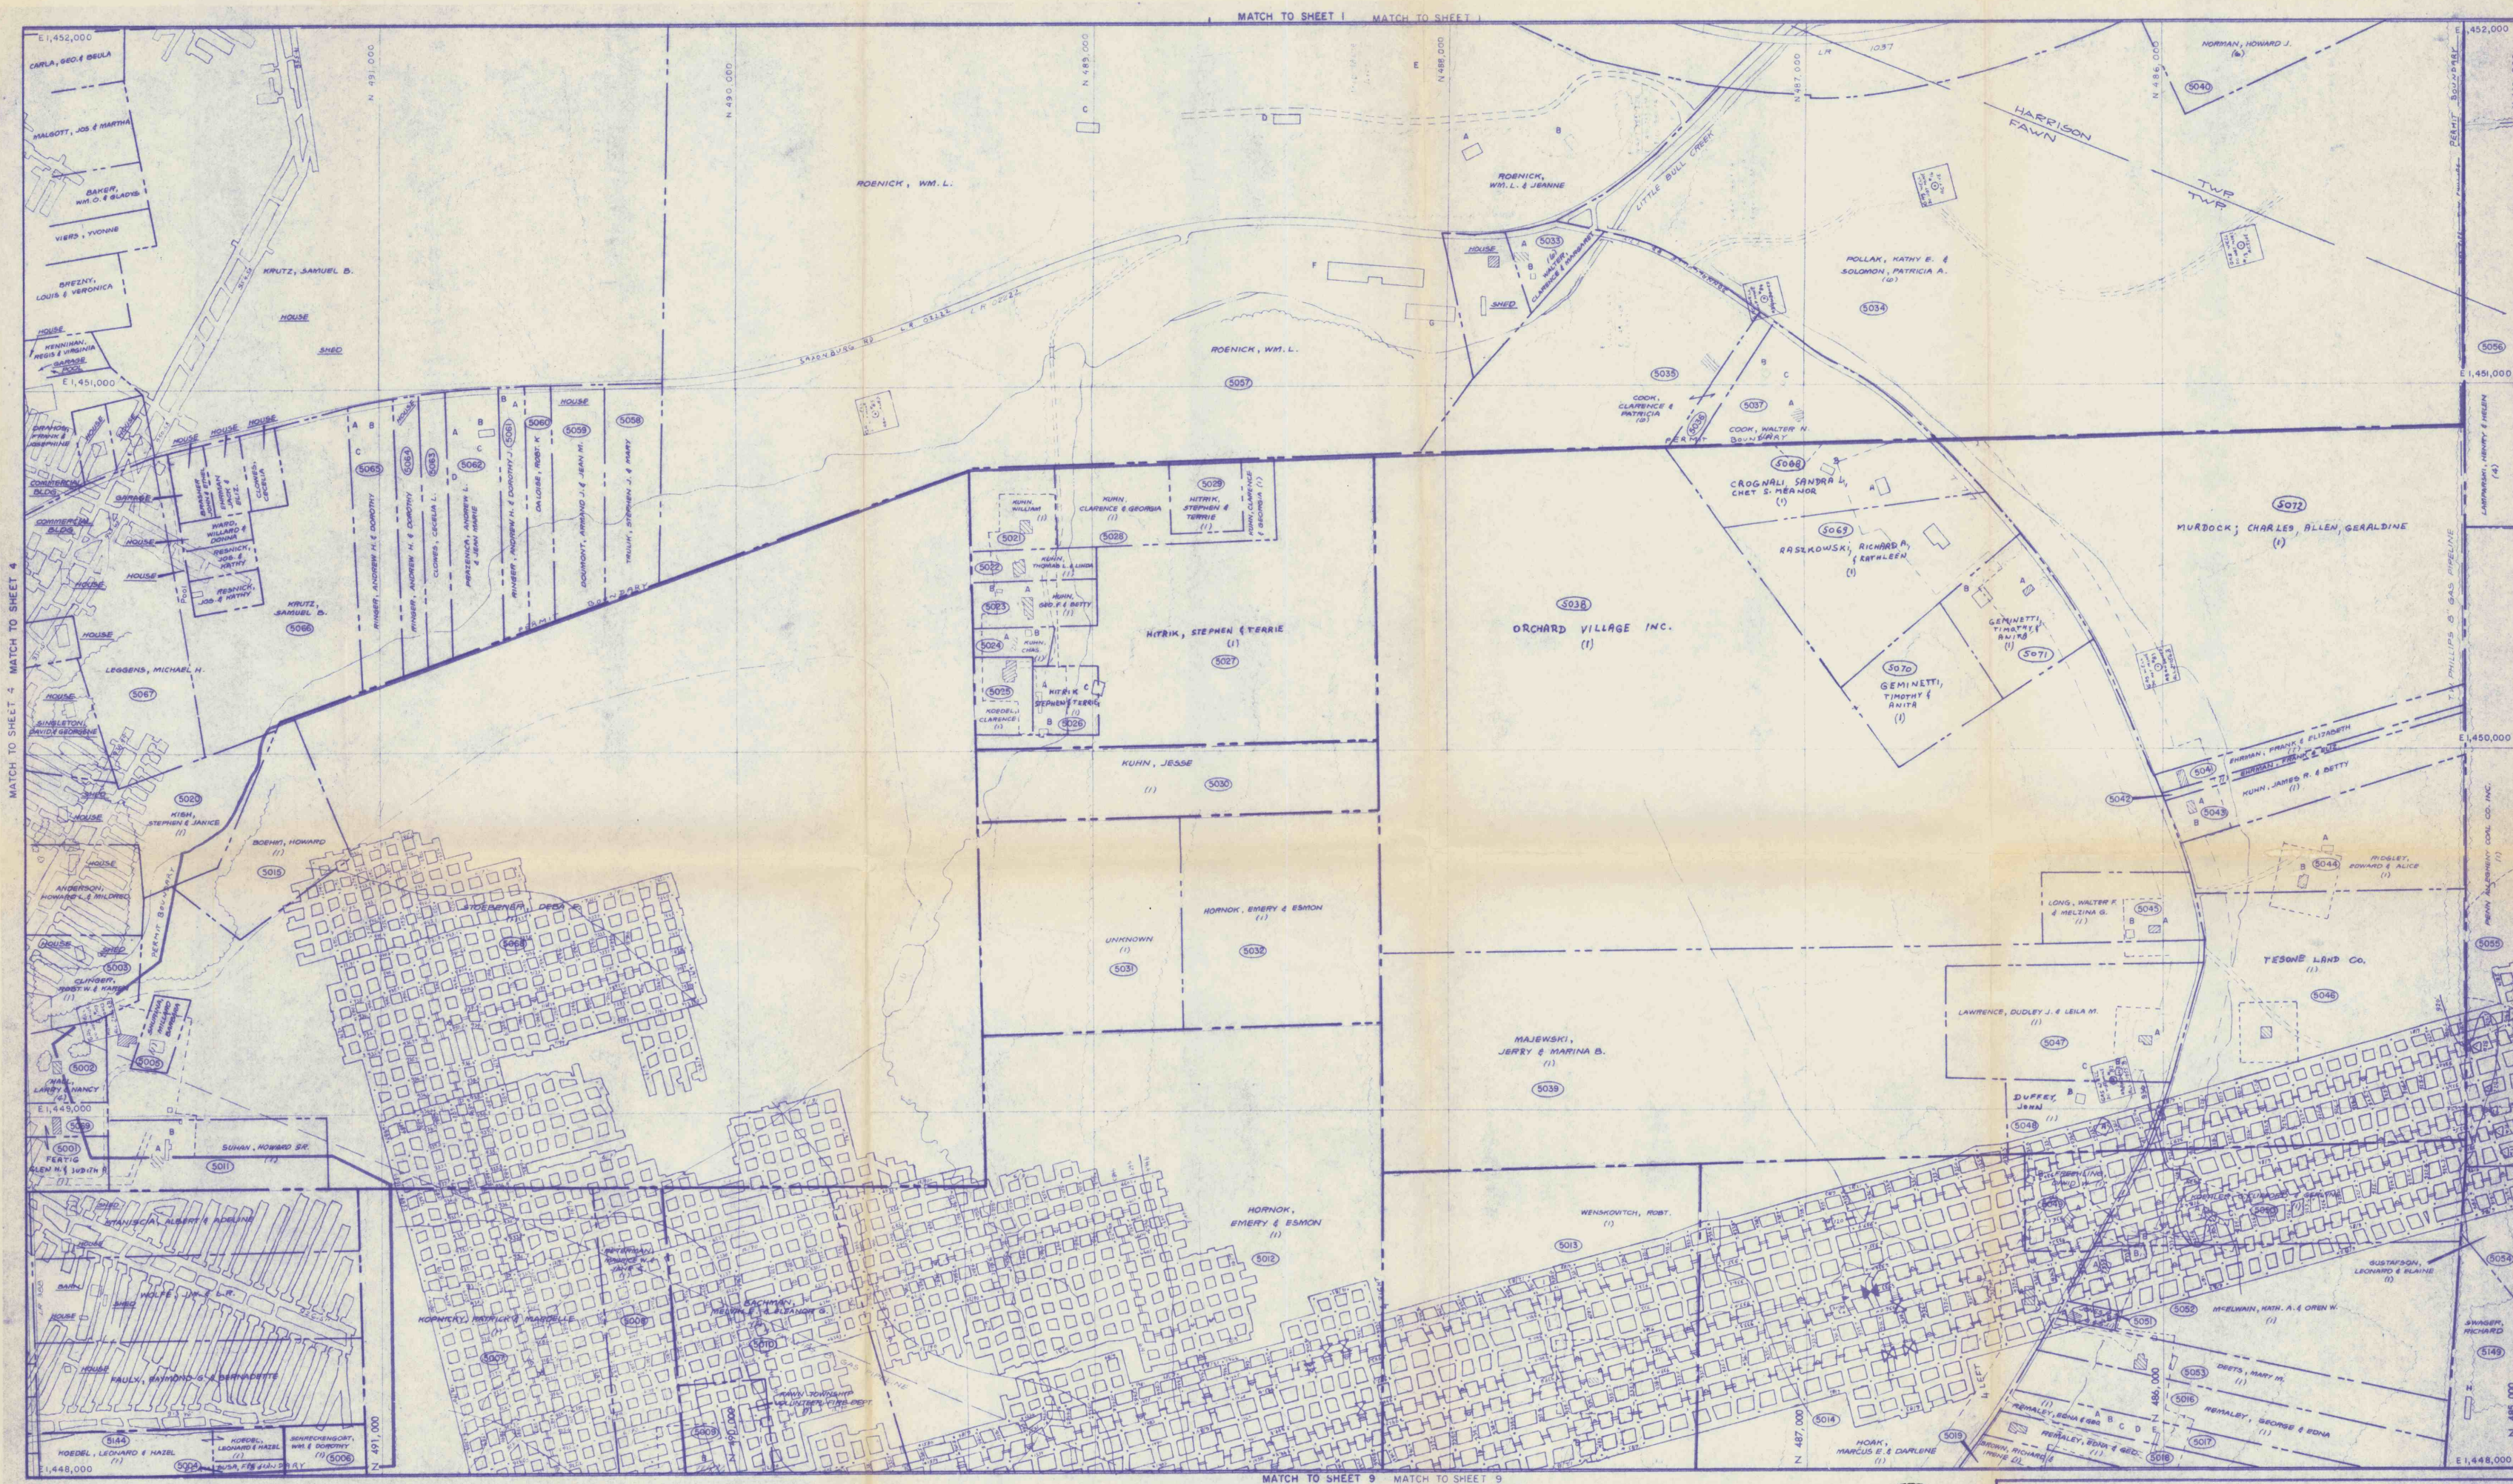


MATCH TO SHEET 4 MATCH TO SHEET 4

MATCH TO SHEET 1 MATCH TO SHEET 1

MATCH TO SHEET 6 MATCH TO SHEET 6

MATCH TO SHEET 9 MATCH TO SHEET 9

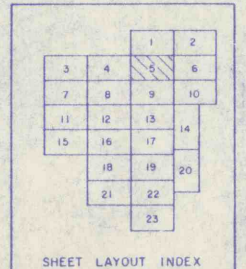

LEGEND FOR MINERAL OWNERSHIP	
(1)	WOOD COAL - LEASE
(2)	PILGRIM COAL - LEASE
(3)	MUSE COAL - LEASE
(4)	PENN ALLEGH COAL PROPERTY
(5)	FAWN DEVELOPMENT CORP. - LEASE
(6)	DO NOT OWN

LEGEND FOR THE 6 MONTH SURFACE SUPPORT PROJECTIONS	
AREA OF PROJECTED MINING FROM: TO:	SURVEY STATION
AREA OF 50% MINING	ELEVATION
PROTECTED STRUCTURE	SINGLE LINE PROJECTION OF ENTRIES & CROSSCUTS HAVING A MAXIMUM WIDTH OF 20 FEET
STRUCTURE	

NOTE: ANY PROJECTED COAL PILLAR FULLY OR PARTIALLY WITHIN AN AREA DESIGNATED FOR 50% MINING SHALL BE LEFT IN PLACE INTACT



Alfred Reisz

ALLEGHENY No. 2 & PORTAL No. 3 MINE
UPPER FREEPORT COAL SEAM
ALLEGHENY COUNTY: FAWN, FRAZER & HARRISON TOWNSHIPS
BUTLER COUNTY: BUFFALO & CLINTON TOWNSHIPS
PENN ALLEGH COAL CO., INC.
ADDRESS: BOX 238A, RD 2, TARENTUM, PA. 15084

SCALE 1" = 200'
SURVEY DATE: 7/31/72
SHEET No. 5