


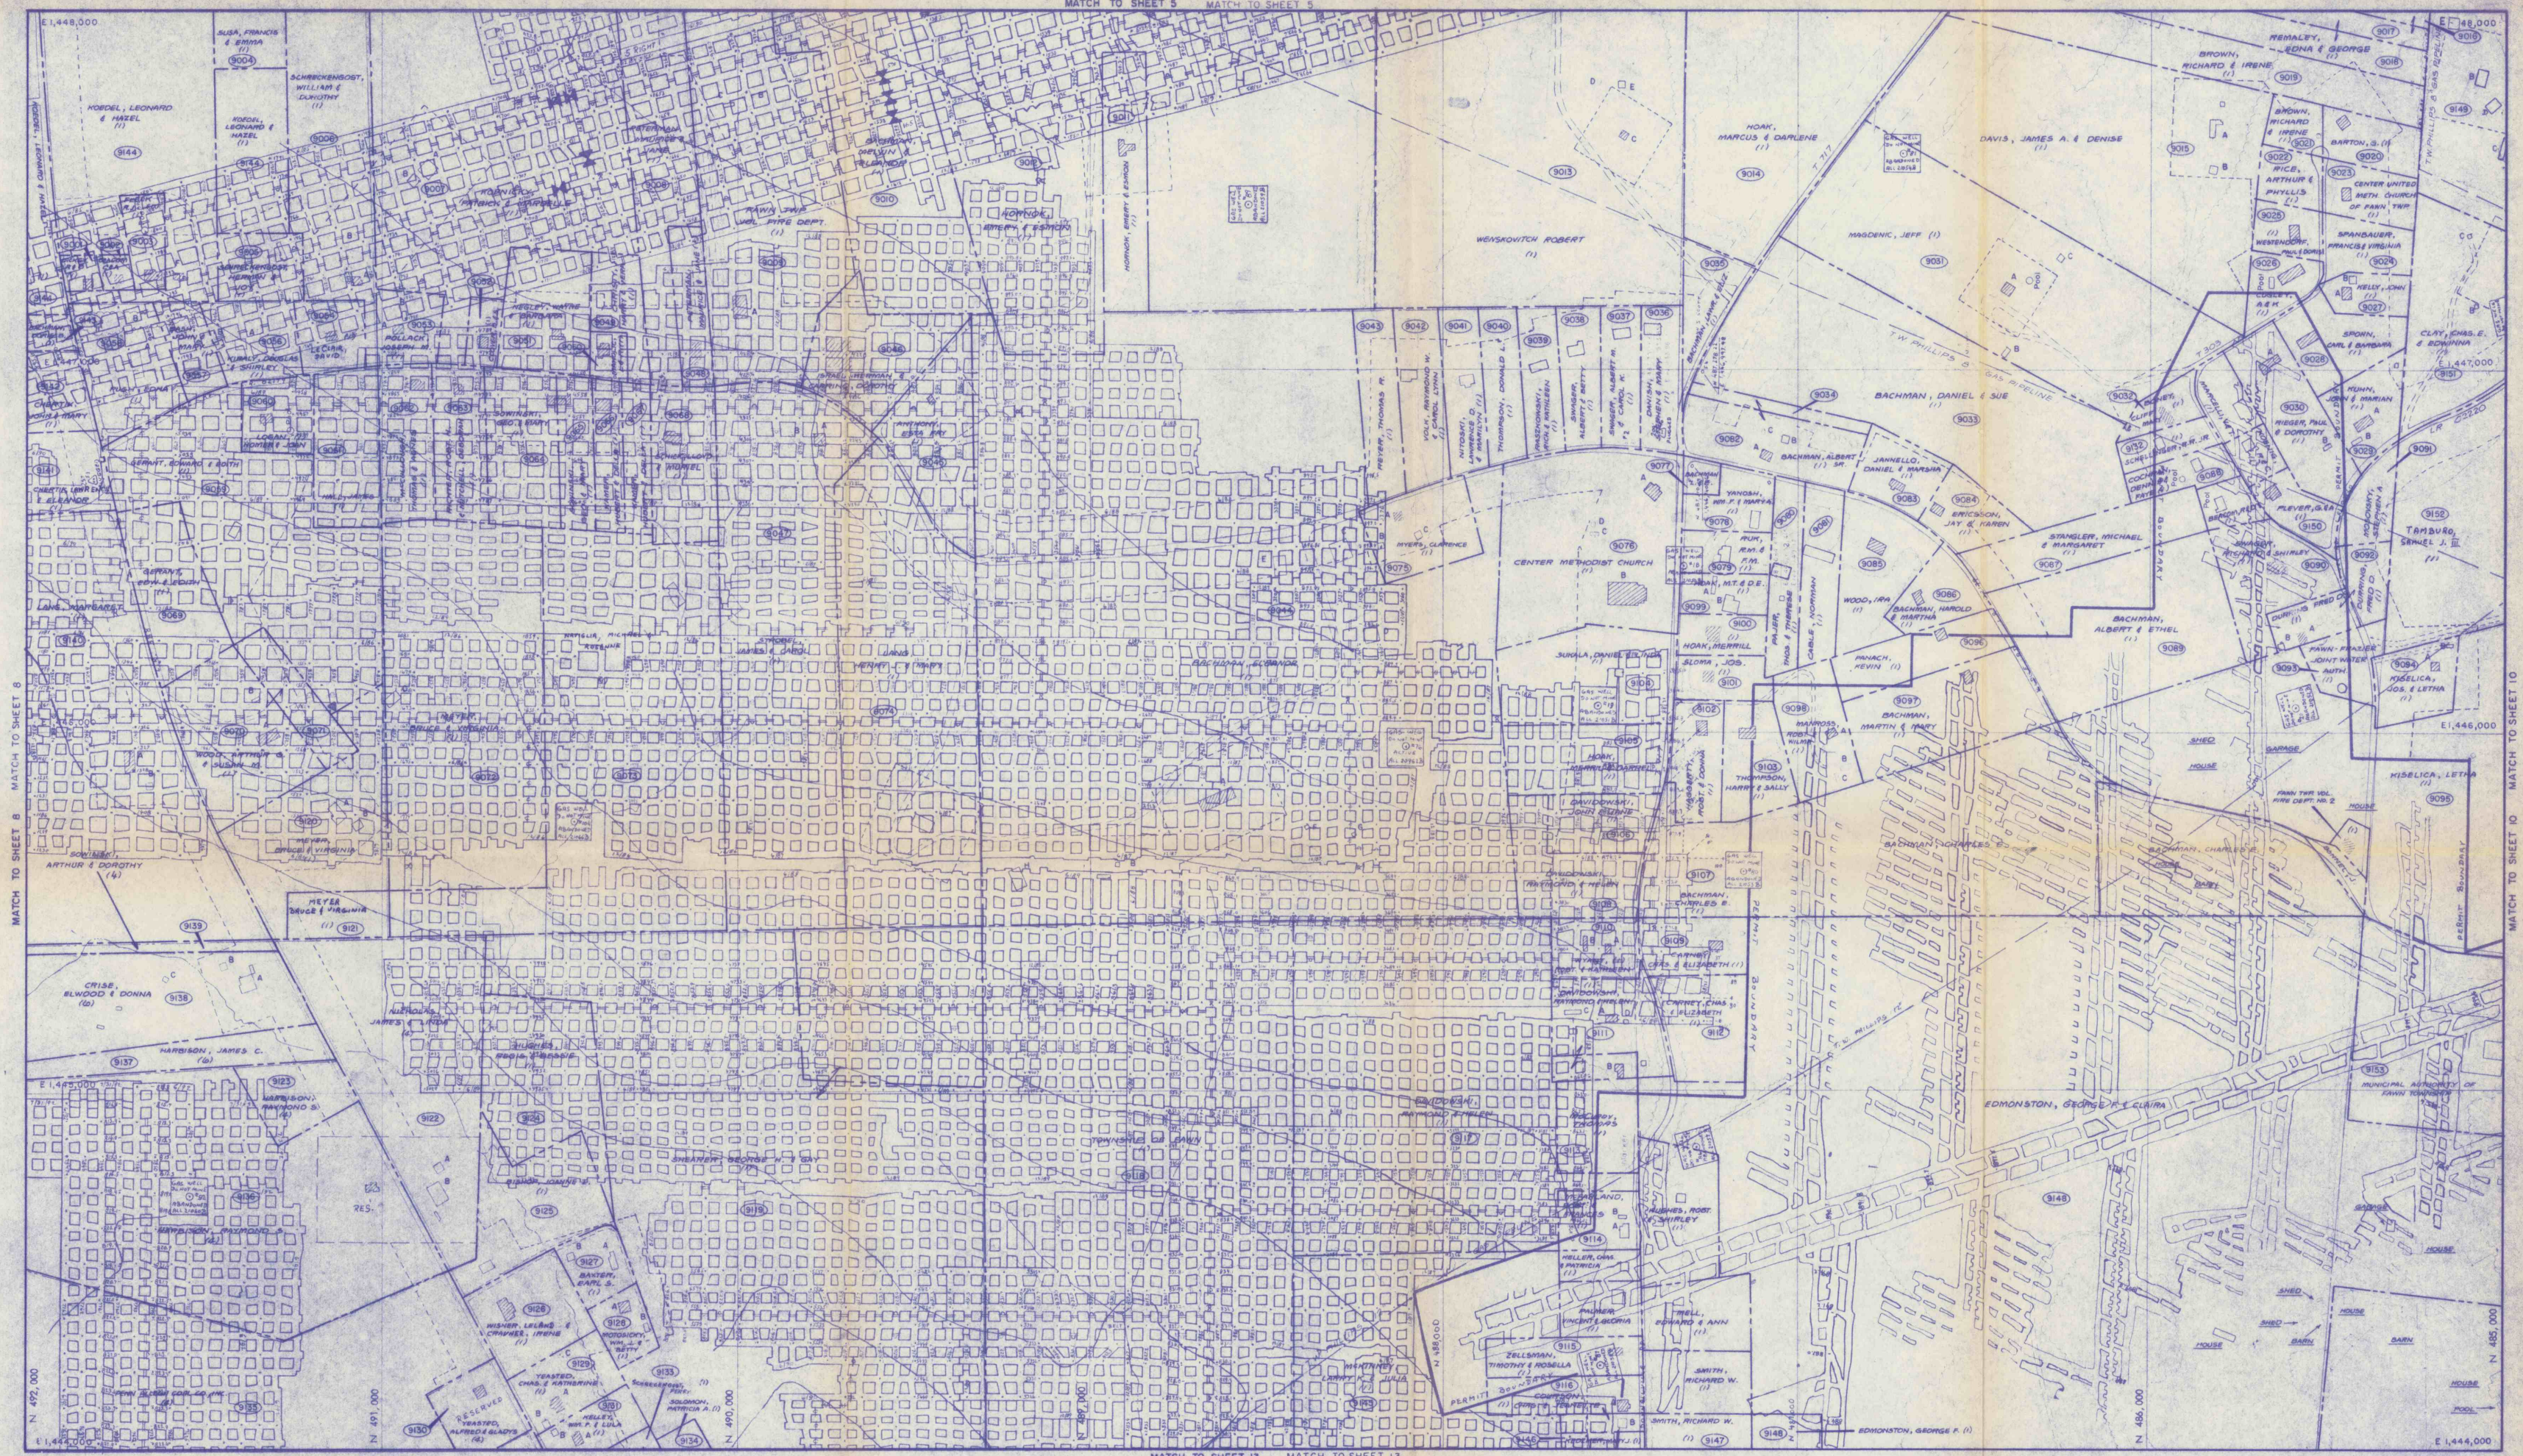

SHEET LAYOUT INDEX

3	4	5	6
7	8	9	10
11	12	13	14
15	16	17	18
19	20	21	22
23	24	25	26

- LEGEND FOR MINERAL OWNERSHIP
- (1) WOOD COAL - LEASE
 - (2) PILGRIM COAL - LEASE
 - (3) MUSE COAL - LEASE
 - (4) PENN ALLEGH COAL PROPERTY
 - (5) FAWN DEVELOPMENT CORP. - LEASE
 - (6) DO NOT OWN

- LEGEND FOR THE 6 MONTH SURFACE SUPPORT PROJECTIONS
- AREA OF PROJECTED MINING FROM: TO:
- AREA OF 50% MINING
- PROTECTED STRUCTURE
- STRUCTURE
- SURVEY STATION
- ELEVATION
- SINGLE LINE PROJECTION OF ENTRIES & CROSSCUTS HAVING A MAXIMUM WIDTH OF 20 FEET
- NOTE: ANY PROJECTED COAL PILLAR FULLY OR PARTIALLY WITHIN AN AREA DESIGNATED FOR 50% MINING SHALL BE LEFT IN PLACE INTACT



Alfred Reisz

ALLEGHENY No. 2 & PORTAL No. 3 MINE
UPPER FREEPORT COAL SEAM
ALLEGHENY COUNTY: FAWN, FRAZER & HARRISON TOWNSHIPS
BUTLER COUNTY: BUFFALO & CLINTON TOWNSHIPS
PENN ALLEGH COAL CO., INC.
ADDRESS: BOX 238A, RD 2, TARENTUM, PA. 15084
SCALE 1" = 200' SURVEY DATE: 7/31/92 SHEET No. 9