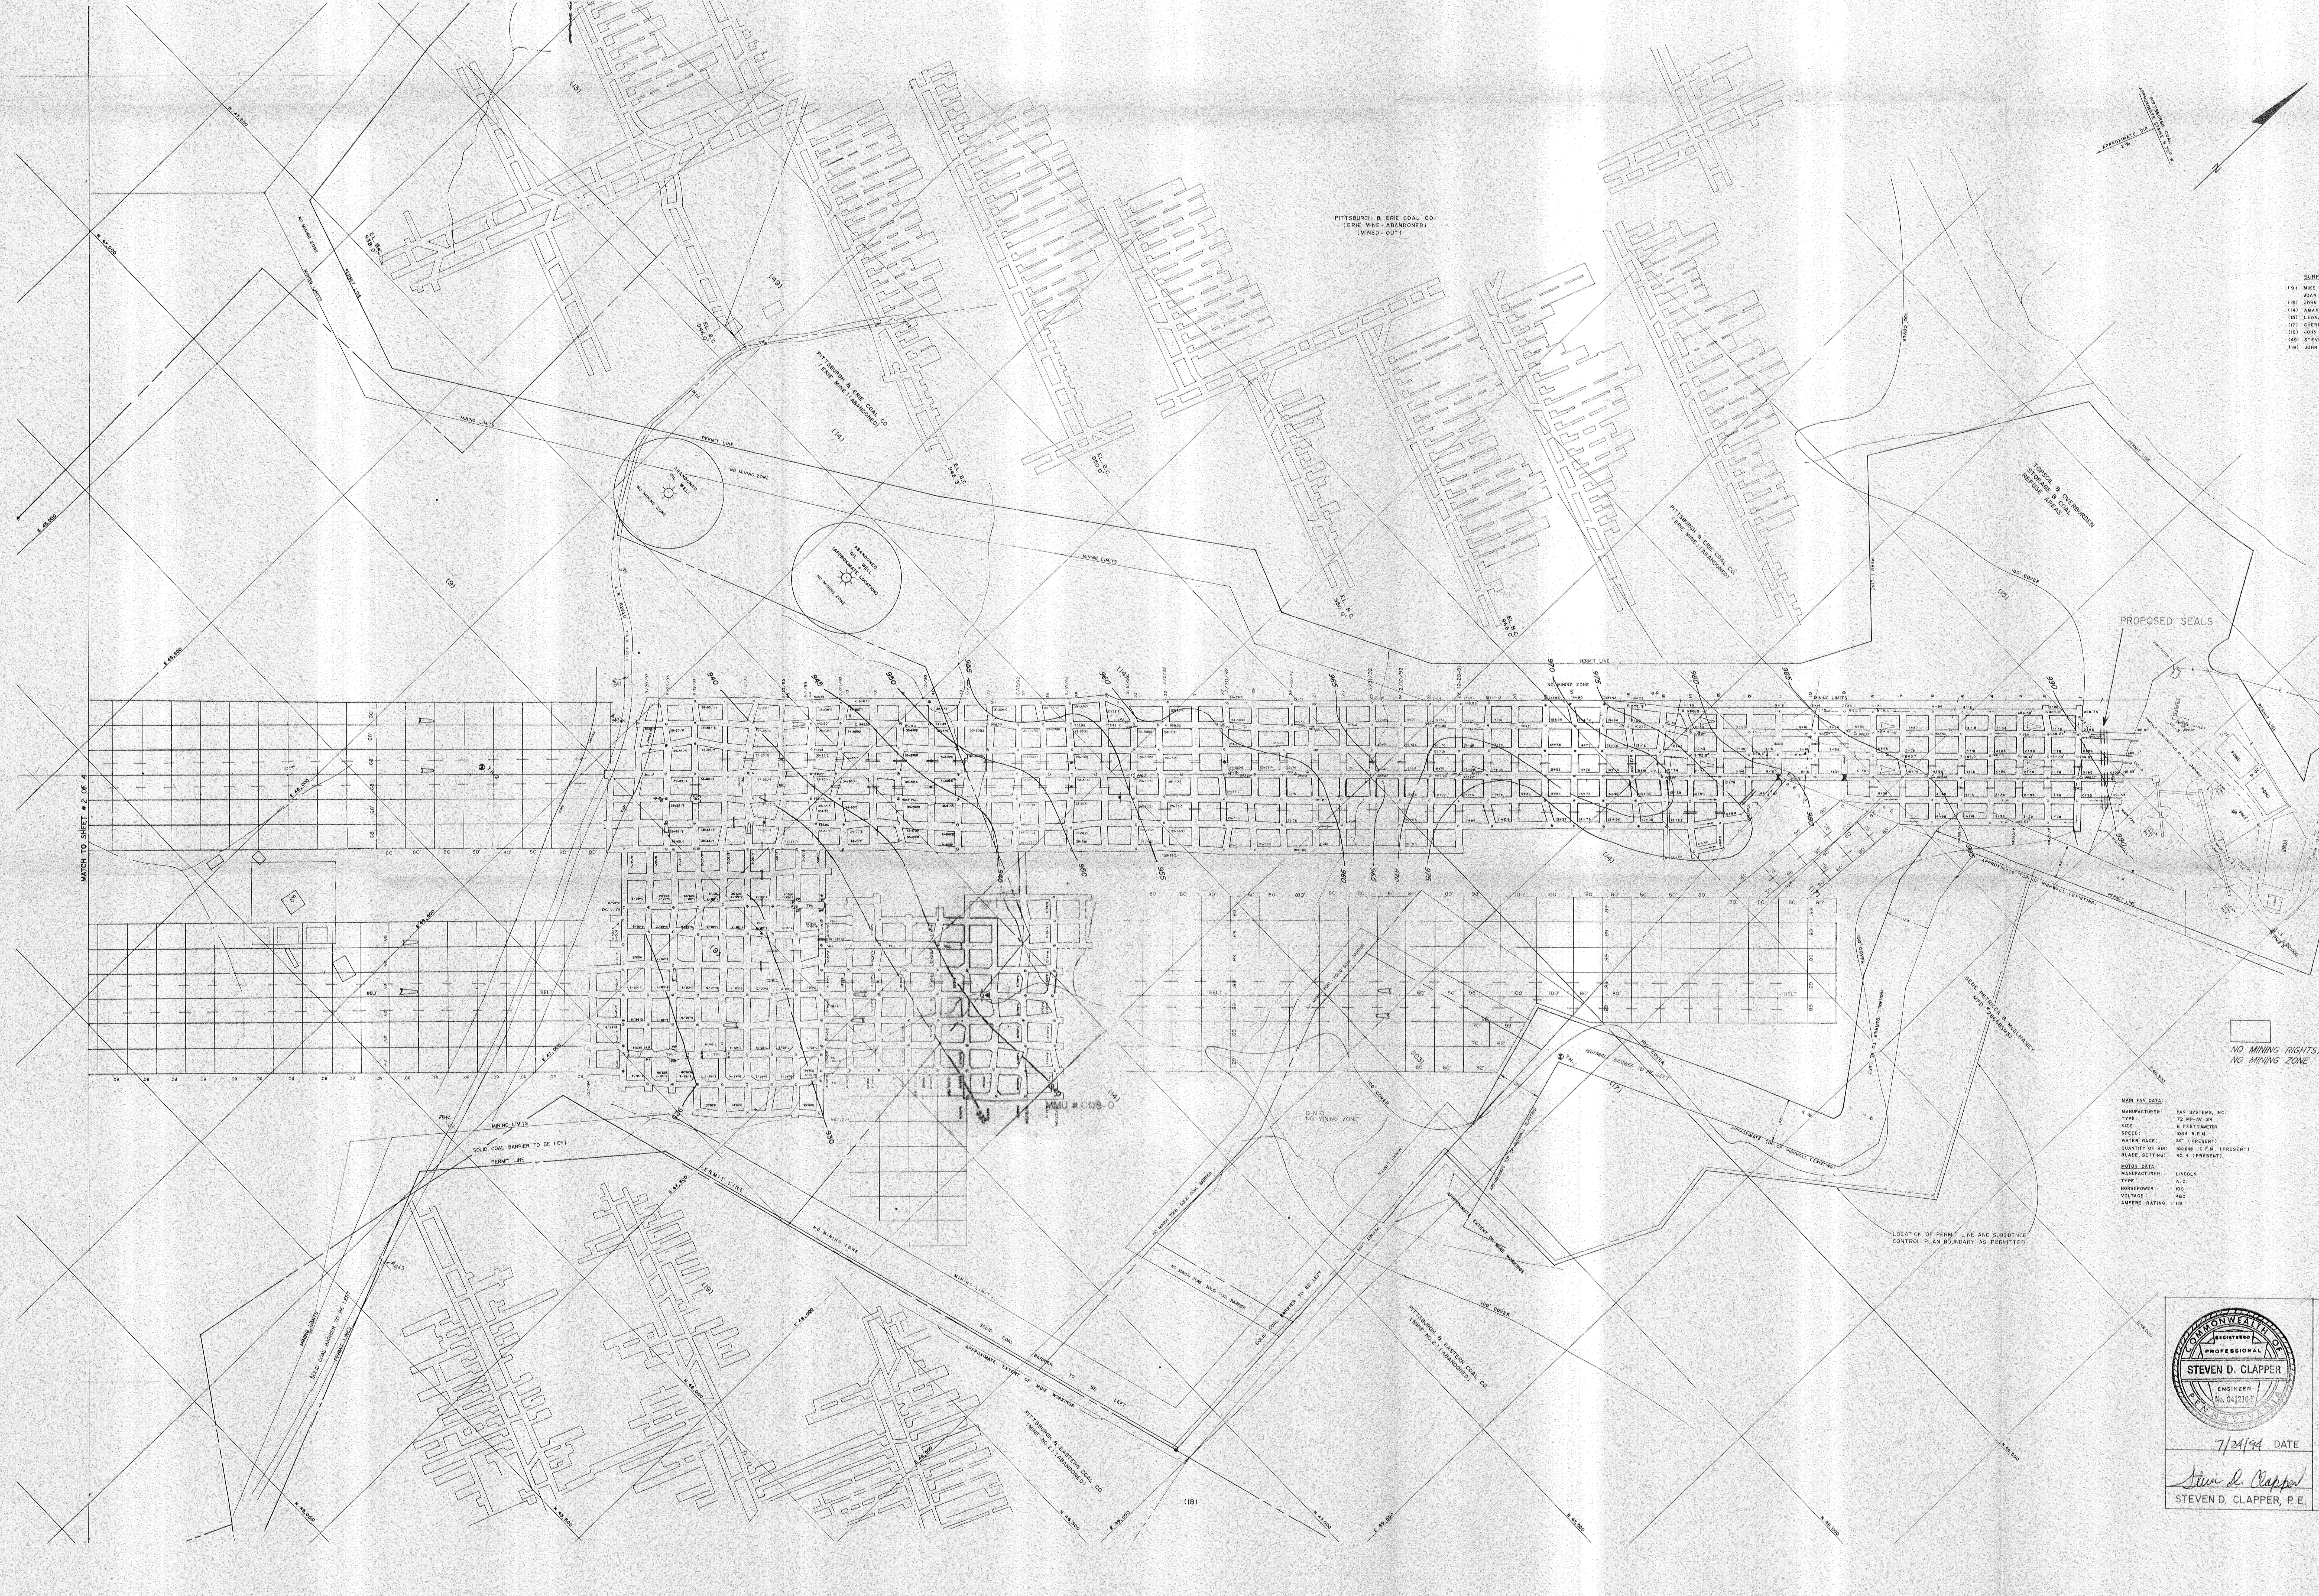
MATCH TO SHEET # 2 OF 4
PITTSBURGH & ERIE COAL CO. (ERIE MINE - ABANDONED) (MINED - OUT)
PITTSBURGH & ERIE COAL CO. (ERIE MINE) (ABANDONED)
PITTSBURGH & EASTERN COAL CO. (MINE NO. 2) (ABANDONED)
PITTSBURGH COAL APPROXIMATE STRIKE N 70° W
APPROXIMATE DIP 2%
N
EL. B.C. 938.0'
EL. B.C. 946.0'
EL. B.C. 943.3'
EL. B.C. 950.0'
EL. B.C. 966.0'
ABANDONED OIL WELL NO MINING ZONE
ABANDONED OIL WELL (APPROXIMATE LOCATION) NO MINING ZONE
TOPSOIL & OVERBURDEN STORAGE & COAL REFUSE AREAS
PROPOSED SEALS
PERMIT LINE
MINING LIMITS
NO MINING ZONE
100' COVER
SOLID COAL BARRIER TO BE LEFT
APPROXIMATE EXTENT OF MINE WORKINGS
APPROXIMATE TOP OF HIGHWALL (EXISTING)
HIGHWALL BARRIER TO BE LEFT
NO MINING ZONE - SOLID COAL BARRIER
D-N-O NO MINING ZONE
GENE PETRICCA & McELHANEY MPD #2666BSM37
LOCATION OF PERMIT LINE AND SUBSIDENCE CONTROL PLAN BOUNDARY AS PERMITTED
MMU # 008-0
L.R. 62220 (S.R. 4021)
L.R. 62031 (S.R. 4035)
BELT
TH-1
TH-2
PORTALS CONSTRUCTED AT ALL OPENINGS
SUBSTATION
OFFICE TRAILER
POND
CLEAN COAL PILE
WASH PLANT
REFUSE PILE
ACCESS ROAD
MAIN FAN
HIGHWALL
(9)
(13)
(14)
(15)
(17)
(18)
(19)
(49)
(103)

REVISIONS / UPDATES					
BY	BRIEF	DATE	BY	BRIEF	DATE
KLM	PROJECTIONS	9/05/90			
MA	PROJECTIONS	9/22/90			
	UPDATE	9/22/90			
WLP	UPDATE	5/26/92			
RRB	UPDATE	9/8/92			
RRB	UPDATE	10/6/92			
RRB	CONTOURS/ELEV.	10/20/92			
RRB	UPDATES	11/10/92			

ENGINEER

	SURFACE OWNER	MINERAL OWNER
(9)	MIKE A. ESNO, JR. JOAN M. SEIK	LEONARD SASSO
(13)	JOHN & ELEANOR DVORSAK	LEONARD SASSO
(14)	AMAX, INC.	LEONARD SASSO
(15)	LEONARD SASSO	LEONARD SASSO
(17)	CHERRY VALLEY COAL MINING CO.	EUGENE PETRICCA
(18)	JOHN JR. & EVELYN M. VERELST	EUGENE PETRICCA & LEONARD SASSO
(49)	STEVEN G. & JANICE R. OSTOP	LEONARD SASSO
(19)	JOHN JR. & EVELYN M. VERELST	EUGENE PETRICCA & LEONARD SASSO

PM #1
N 50,154.8762
E 49,696.1046
EL. 1,000.21'

PM #2
N 50,015.6855
E 49,205.8501

PM #3
N 49,995.1742
E 50,003.3285
EL. 998.43'

NOTES

(1) THIS MAP SATISFIES THE REQUIREMENTS OF 30 CFR 75.1200 AND 75.372
(2) PERSONS RESPONSIBLE FOR INFORMATION ON THIS MAP: WAYNE KOZAK & STEVE CLAPPER
(3) SURVEY BY CLOSED LOOP METHOD WITH AN ACCURACY OF AT LEAST 1 IN 5000
(4) NO UNDERLYING OR OVERLYING UNDERGROUND MINING ACTIVITY IS PRESENT
(5) SEE EXHIBIT I FOR ADJACENT PITTSBURGH SEAM DEEP MINES
(6) ALL THREE PERMANENT MONUMENTS ARE CONCRETE MONUMENTS WITH AN IRON PIN
(7) THE CONTINUOUS MINER'S MMU # IS 008-0

NOTE:
ABANDONED MINE WORKINGS AS SHOWN WERE TAKEN FROM READILY AVAILABLE INFORMATION AND DOES NOT DEPICT THE SURVEYED LOCATION, BY CHARBEL ENGINEERING SERVICES, OF SAME

NO MINING RIGHTS/
NO MINING ZONE

MAIN FAN DATA:

MANUFACTURER:	FAN SYSTEMS, INC.
TYPE:	72 MP-AV-2R
SIZE:	6 FEET DIAMETER
SPEED:	1054 R.P.M.
WATER GAGE:	3.6" (PRESENT)
QUANTITY OF AIR:	100,648 C.F.M. (PRESENT)
BLADE SETTING:	NO. 4 (PRESENT)

MOTOR DATA:

MANUFACTURER:	LINCOLN
TYPE:	A.C.
HORSEPOWER:	100
VOLTAGE:	480
AMPERE RATING:	119

LEGEND:

- PERMIT LINE
- SUBSIDENCE CONTROL BOUNDARY
- FRAMED CHECK CURTAIN
- LINE CURTAIN
- INTAKE
- RETURN
- BLEEDER
- PERMANENT STOPPING
- REGULATOR
- BOXCHECK
- MANDOOR
- OVERCAST (PROPOSED)
- CHECK CURTAIN
- LOADING POINT
- BELT
- PRIMARY ESCAPEWAY
- SECONDARY ESCAPEWAY
- SURVEY STATION (UNDERGROUND)
- COAL CONTOUR
- SUPPORT BLOCK (50 % MINING)
- PILLARED AREA
- STRUCTURE INVENTORY NUMBER
- PRE - 1966 STRUCTURE
- BELT OVER TRACK
- DOOR
- COMPLETED OVERCAST
- AVERAGE ENTRY WIDTH - 19' HEIGHT - 16'
- PERMANENT MONUMENT
- GAS OR OIL WELL
- DRAIN
- SURFACE SURVEY STATION
- PROPERTY LINE
- APPROXIMATE BOREHOLE LOCATION
- PROPOSED BELT TRANSFER
- 6 MONTH PROJECTION LIMITS

PITTSBURGH MINING COMPANY
P.O. BOX 47
JOFFRE, PENNSYLVANIA 15053

STEVEN D. CLAPPER
No. 041210-E

7/24/94 DATE

Steven D. Clapper
STEVEN D. CLAPPER, P.E.

PENN BALT #1

FINAL MAP

SMITH TOWNSHIP
WASHINGTON COUNTY
MSHA ID # 36-08028
PA. M.A.P. NUMBER 63871301
SHEET #1 OF 4 SCALE 1" = 200'

RECEIVED
JUL 26 1994
Dept. of Environmental Resources
McMurray District Office

PREPARED BY:
CHARBEL ENGINEERING SERVICES
P.O. BOX 4A
LEMONT FURNACE, PA 15456
PHONE (412) 439 1313

PERMITTEE:
PENN BALT, INC.
P.O. BOX 287
JOFFRE, PENNSYLVANIA 15053 0287

DMS