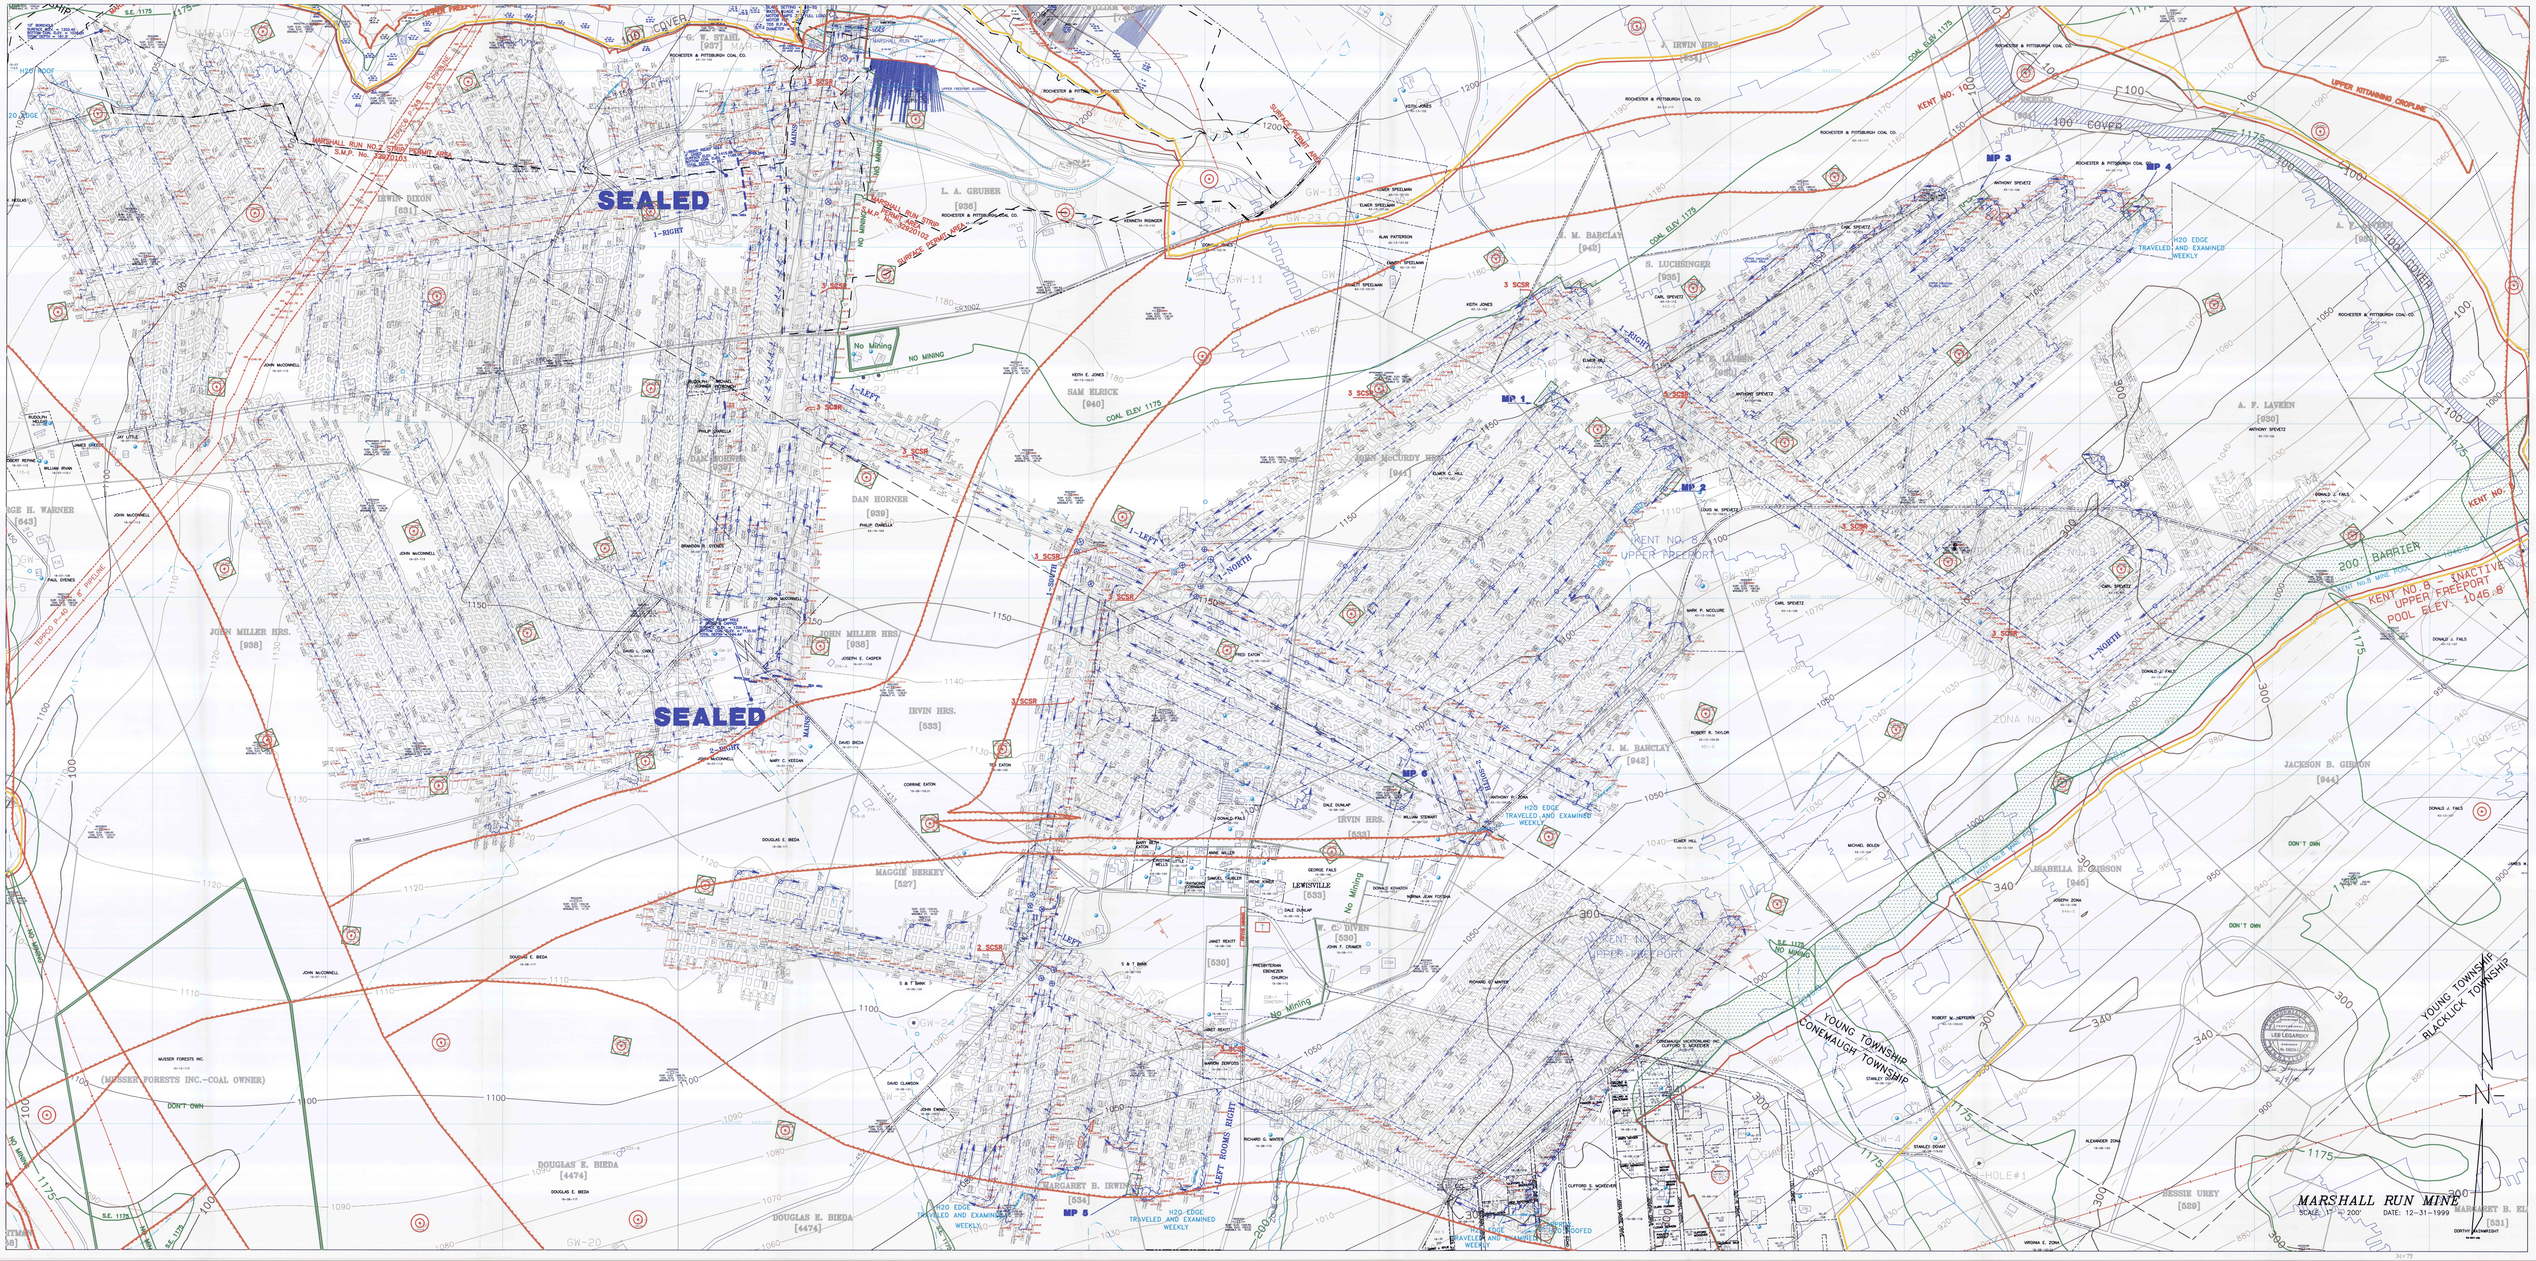

SEALED
SEALED
MAINS
1-RIGHT
2-RIGHT
1-LEFT
1-NORTH
1-SOUTH
2-SOUTH
1-LEFT ROOMS RIGHT
3 SCSR
2 SCSR
MP 1
MP 2
MP 3
MP 4
MP 5
MP 6
No Mining
NO MINING
DON'T OWN
H2O EDGE TRAVELED AND EXAMINED WEEKLY
H2O ROOF
MARSHALL RUN NO.2 STRIP PERMIT AREA S.M.P. No. 32970103
MARSHALL RUN STRIP S.M.P. PERMIT AREA No. 32920102
SURFACE PERMIT AREA
TEPPCO P-40 8" PIPELINE
COAL ELEV 1175
S.E. 1175
100 COVER
UPPER KITTANNING CROPLINE
KENT No. 10
KENT NO. 8 UPPER FREEPORT
KENT NO.8 - INACTIVE UPPER FREEPORT POOL ELEV. 1046.8
KENT No.8 MINE POOL
200' BARRIER
ZONE OF INFLUENCE
LEWISVILLE
PRESBYTERIAN EBENEZER CHURCH
CEMETERY
YOUNG TOWNSHIP
CONEMAUGH TOWNSHIP
YOUNG TOWNSHIP
BLACKLICK TOWNSHIP
IRWIN DIXON [631]
JOHN MILLER HRS. [938]
DAN HORNER [939]
IRVIN HRS. [533]
MAGGIE BERKEY [527]
DOUGLAS E. BIEDA [4474]
MARGARET B. IRWIN [534]
W. C. DIVEN [530]
[530]
J. M. BARCLAY [942]
JOHN McCURDY HRS. [941]
S. LUCHSINGER [935]
A. F. LAVEEN [930]
SAM ELRICK [940]
L. A. GRUBER [936]
G. W. STAHL [937]
J. IRWIN HRS. [934]
ISABELLA B. GIBSON [945]
JACKSON B. GIBSON [944]
BESSIE UREY [529]
MARGARET B. EL [531]
GEORGE H. WARNER [643]
(MUSSER FORESTS INC.-COAL OWNER)
MUSSER FORESTS INC.
ROCHESTER & PITTSBURGH COAL CO.
JOHN McCONNELL
DOUGLAS E. BIEDA
S & T BANK
DAVID CLAWSON
JOHN EWING
RICHARD G. MINTER
MARTON ZERFOSS
JANET REKITT
JOHN F. CRAMER
DALE DUNLAP
GEORGE FAILS
DONALD KOVATCH
NORMA JEAN FORSHA
WILLIAM STEWART
ANTHONY P. ZONA
FRED EATON
TED EATON
CORRINE EATON
DAVID BIEDA
MARY C. KEEGAN
JOSEPH E. CASPER
DAVID L. CABLE
BRANDON R. GYENES
PHILIP CIARELLA
RUDOLPH MICHAEL KUHNER PETROVICH
KEITH E. JONES
KENNETH RISINGER
ELMER SPEELMAN
ALAN PATTERSON
EMMETT SPEELMAN
KEITH JONES
ELMER C. HILL
ELMER HILL
CARL SPEVETZ
ANTHONY SPEVETZ
LOUIS M. SPEVETZ
MARK P. McCLURE
ROBERT R. TAYLOR
DONALD J. FAILS
MICHAEL BOLEN
JOSEPH ZONA
ROBERT M. HEFFERIN
STANLEY DONAT
ALEXANDER ZONA
VIRGINIA E. ZONA
CLIFFORD S. McKEEVER
CONEMAUGH VACATIONLAND, INC. CLIFFORD S. McKEEVER
PAUL GYENES
WILLIAM IRVAN
ROBERT REPINE
JAMES GREECE
JAY LITTLE
RUDOLPH HELGEN
DORTHY WAINWRIGHT
ZONA No
GW-9
GW-11
GW-12
GW-13
GW-20
GW-21
GW-23
GW-24
SR3002
SR3009
N

MARSHALL RUN MINE

SCALE: 1" = 200' DATE: 12-31-1999

LEE LEGARSKY
No. 038234

36x73