



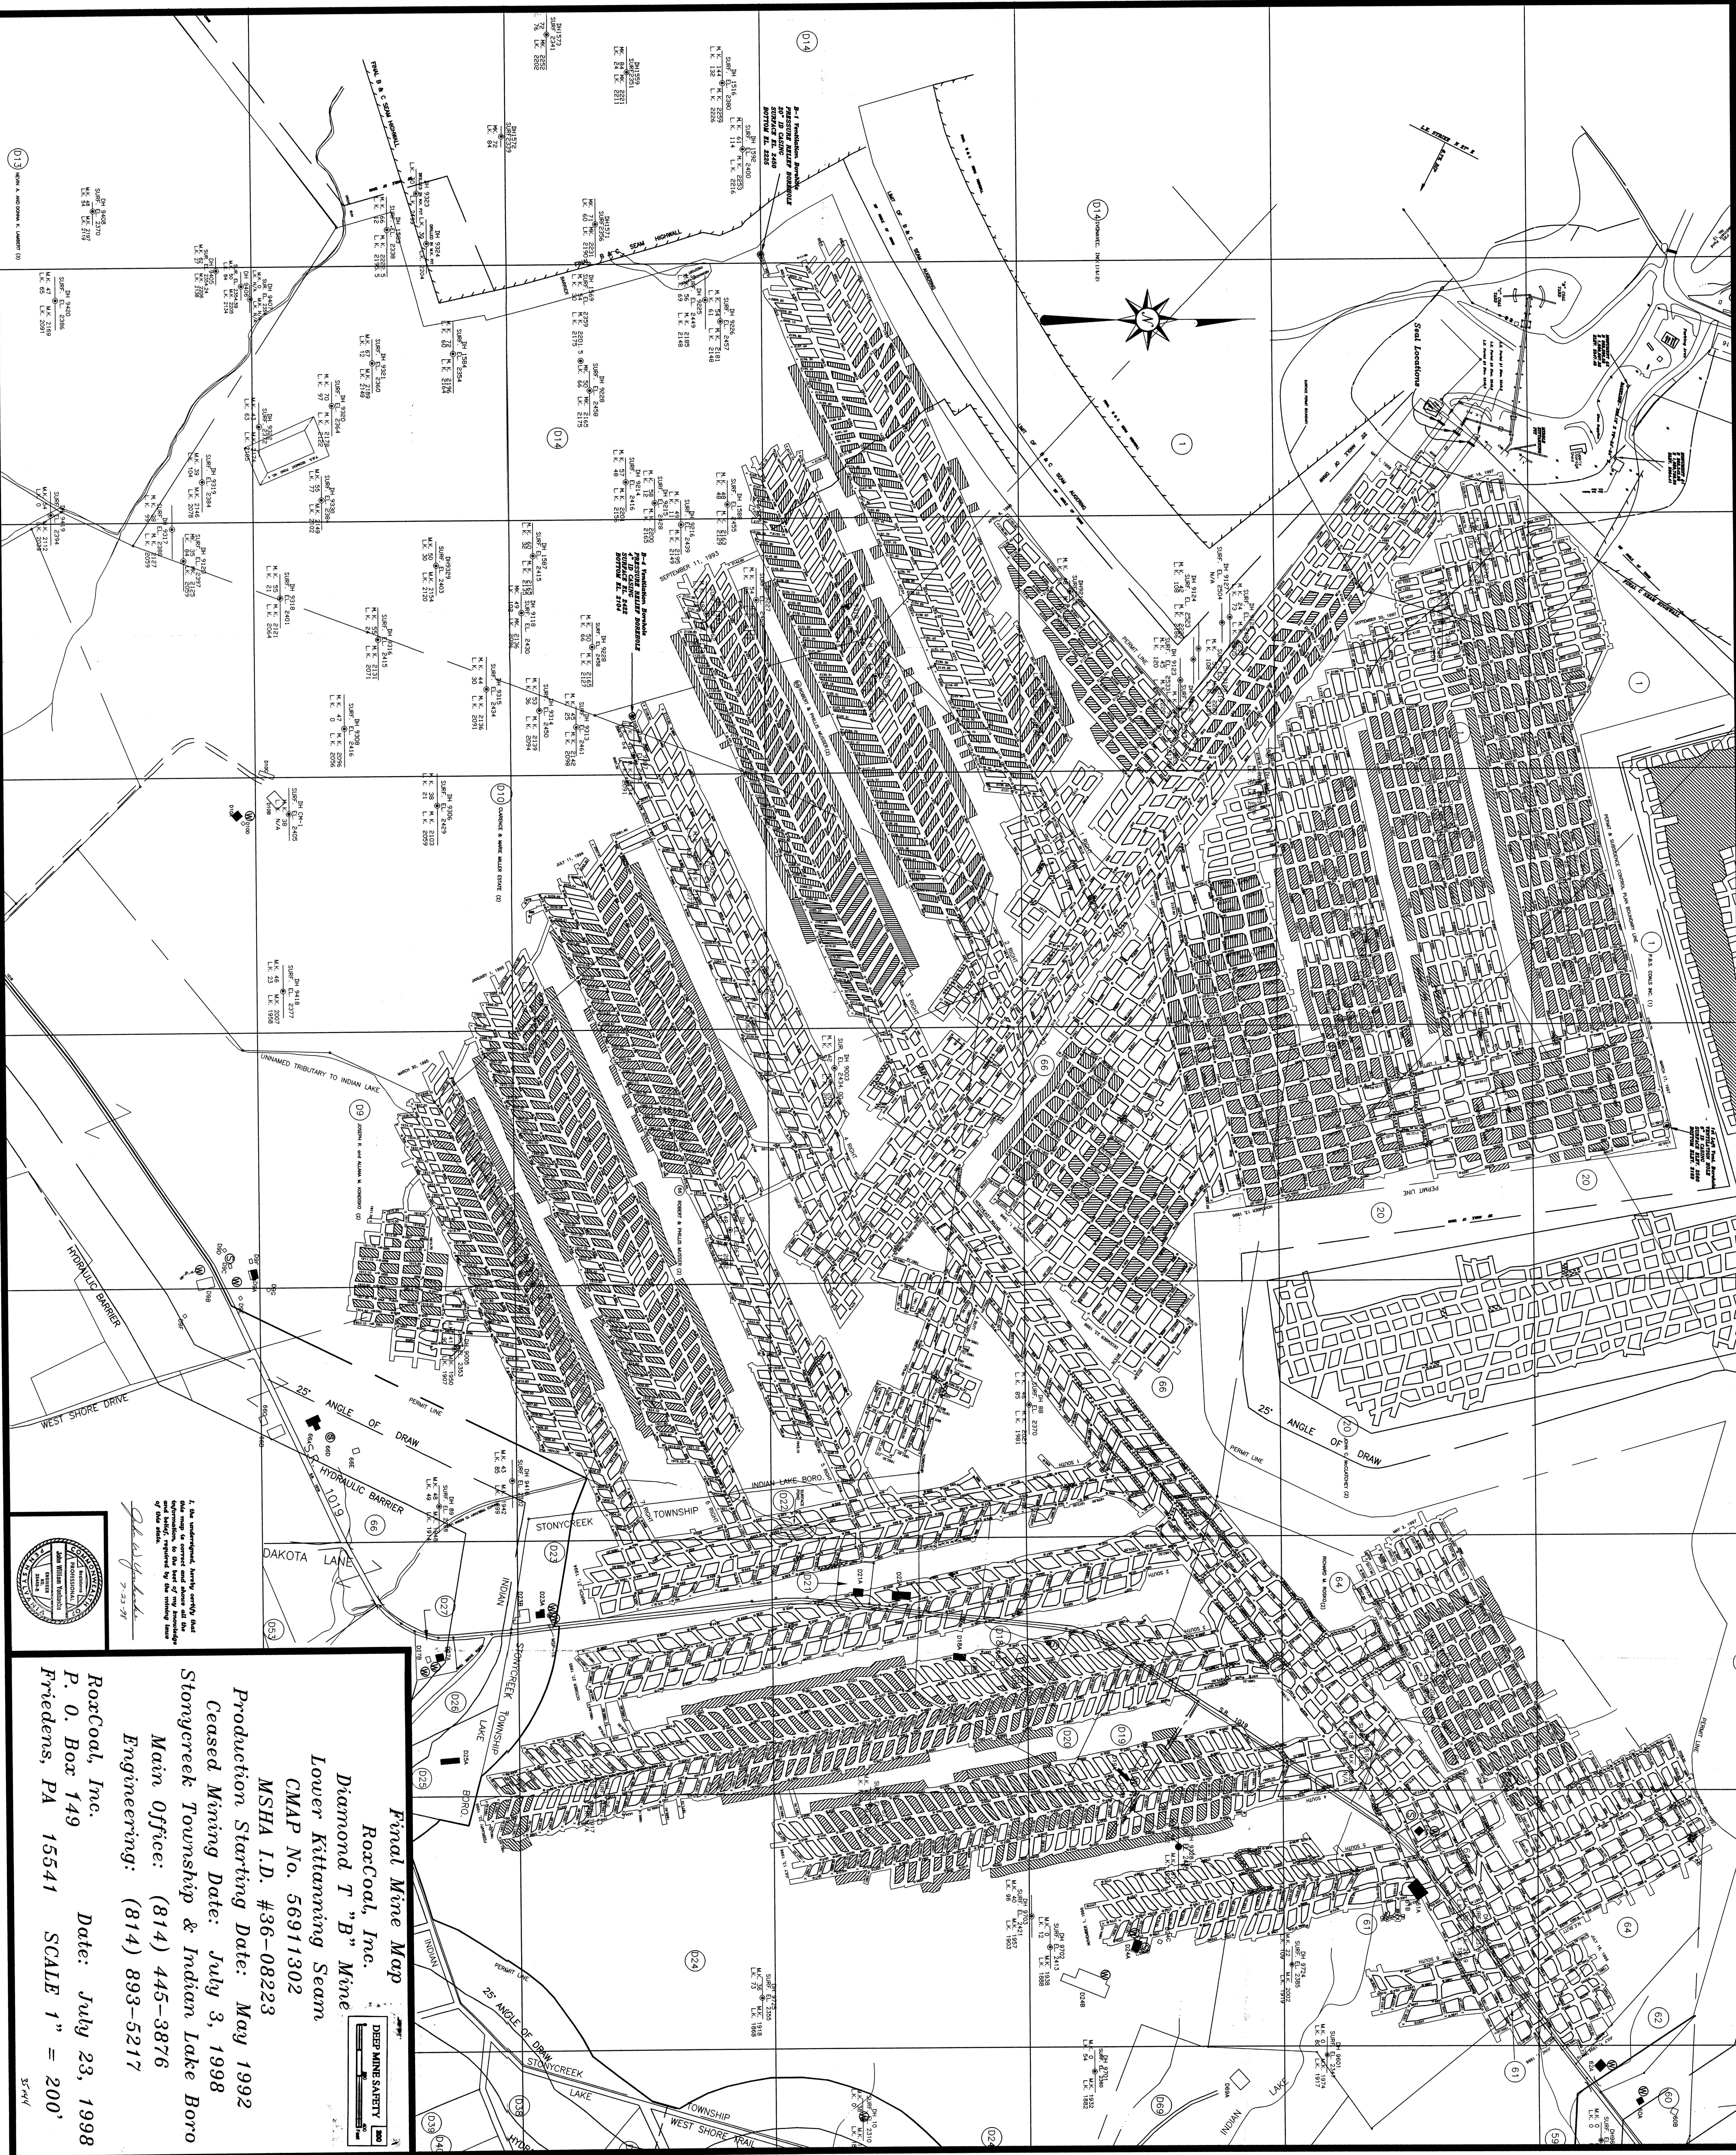

I, the undersigned, hereby certify that this map is correct and shows all the information, to the best of my knowledge and belief, required by the mining laws of this state.

Fatal Mine Map
RoxCoal, Inc.
Diamond T "B" Mine
Lower Kittanning Seam
CMAAP No. 56911302
MSHA I.D. #36-08223
Production Starting Date: May 1992
Ceased Mining Date: July 3, 1998
Stongcreek Township & Indian Lake Boro
Main Office: (814) 445-3876
Engineering: (814) 893-5217
RoxCoal, Inc.
P. O. Box 149
Friedens, PA 15541
Date: July 23, 1998
SCALE 1" = 200'

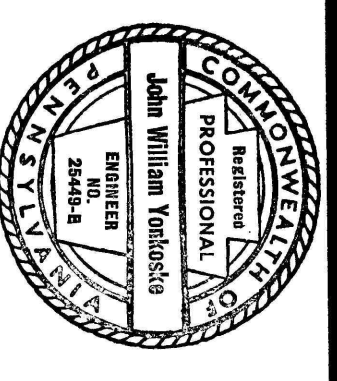

DEEP MINE SAFETY

200