


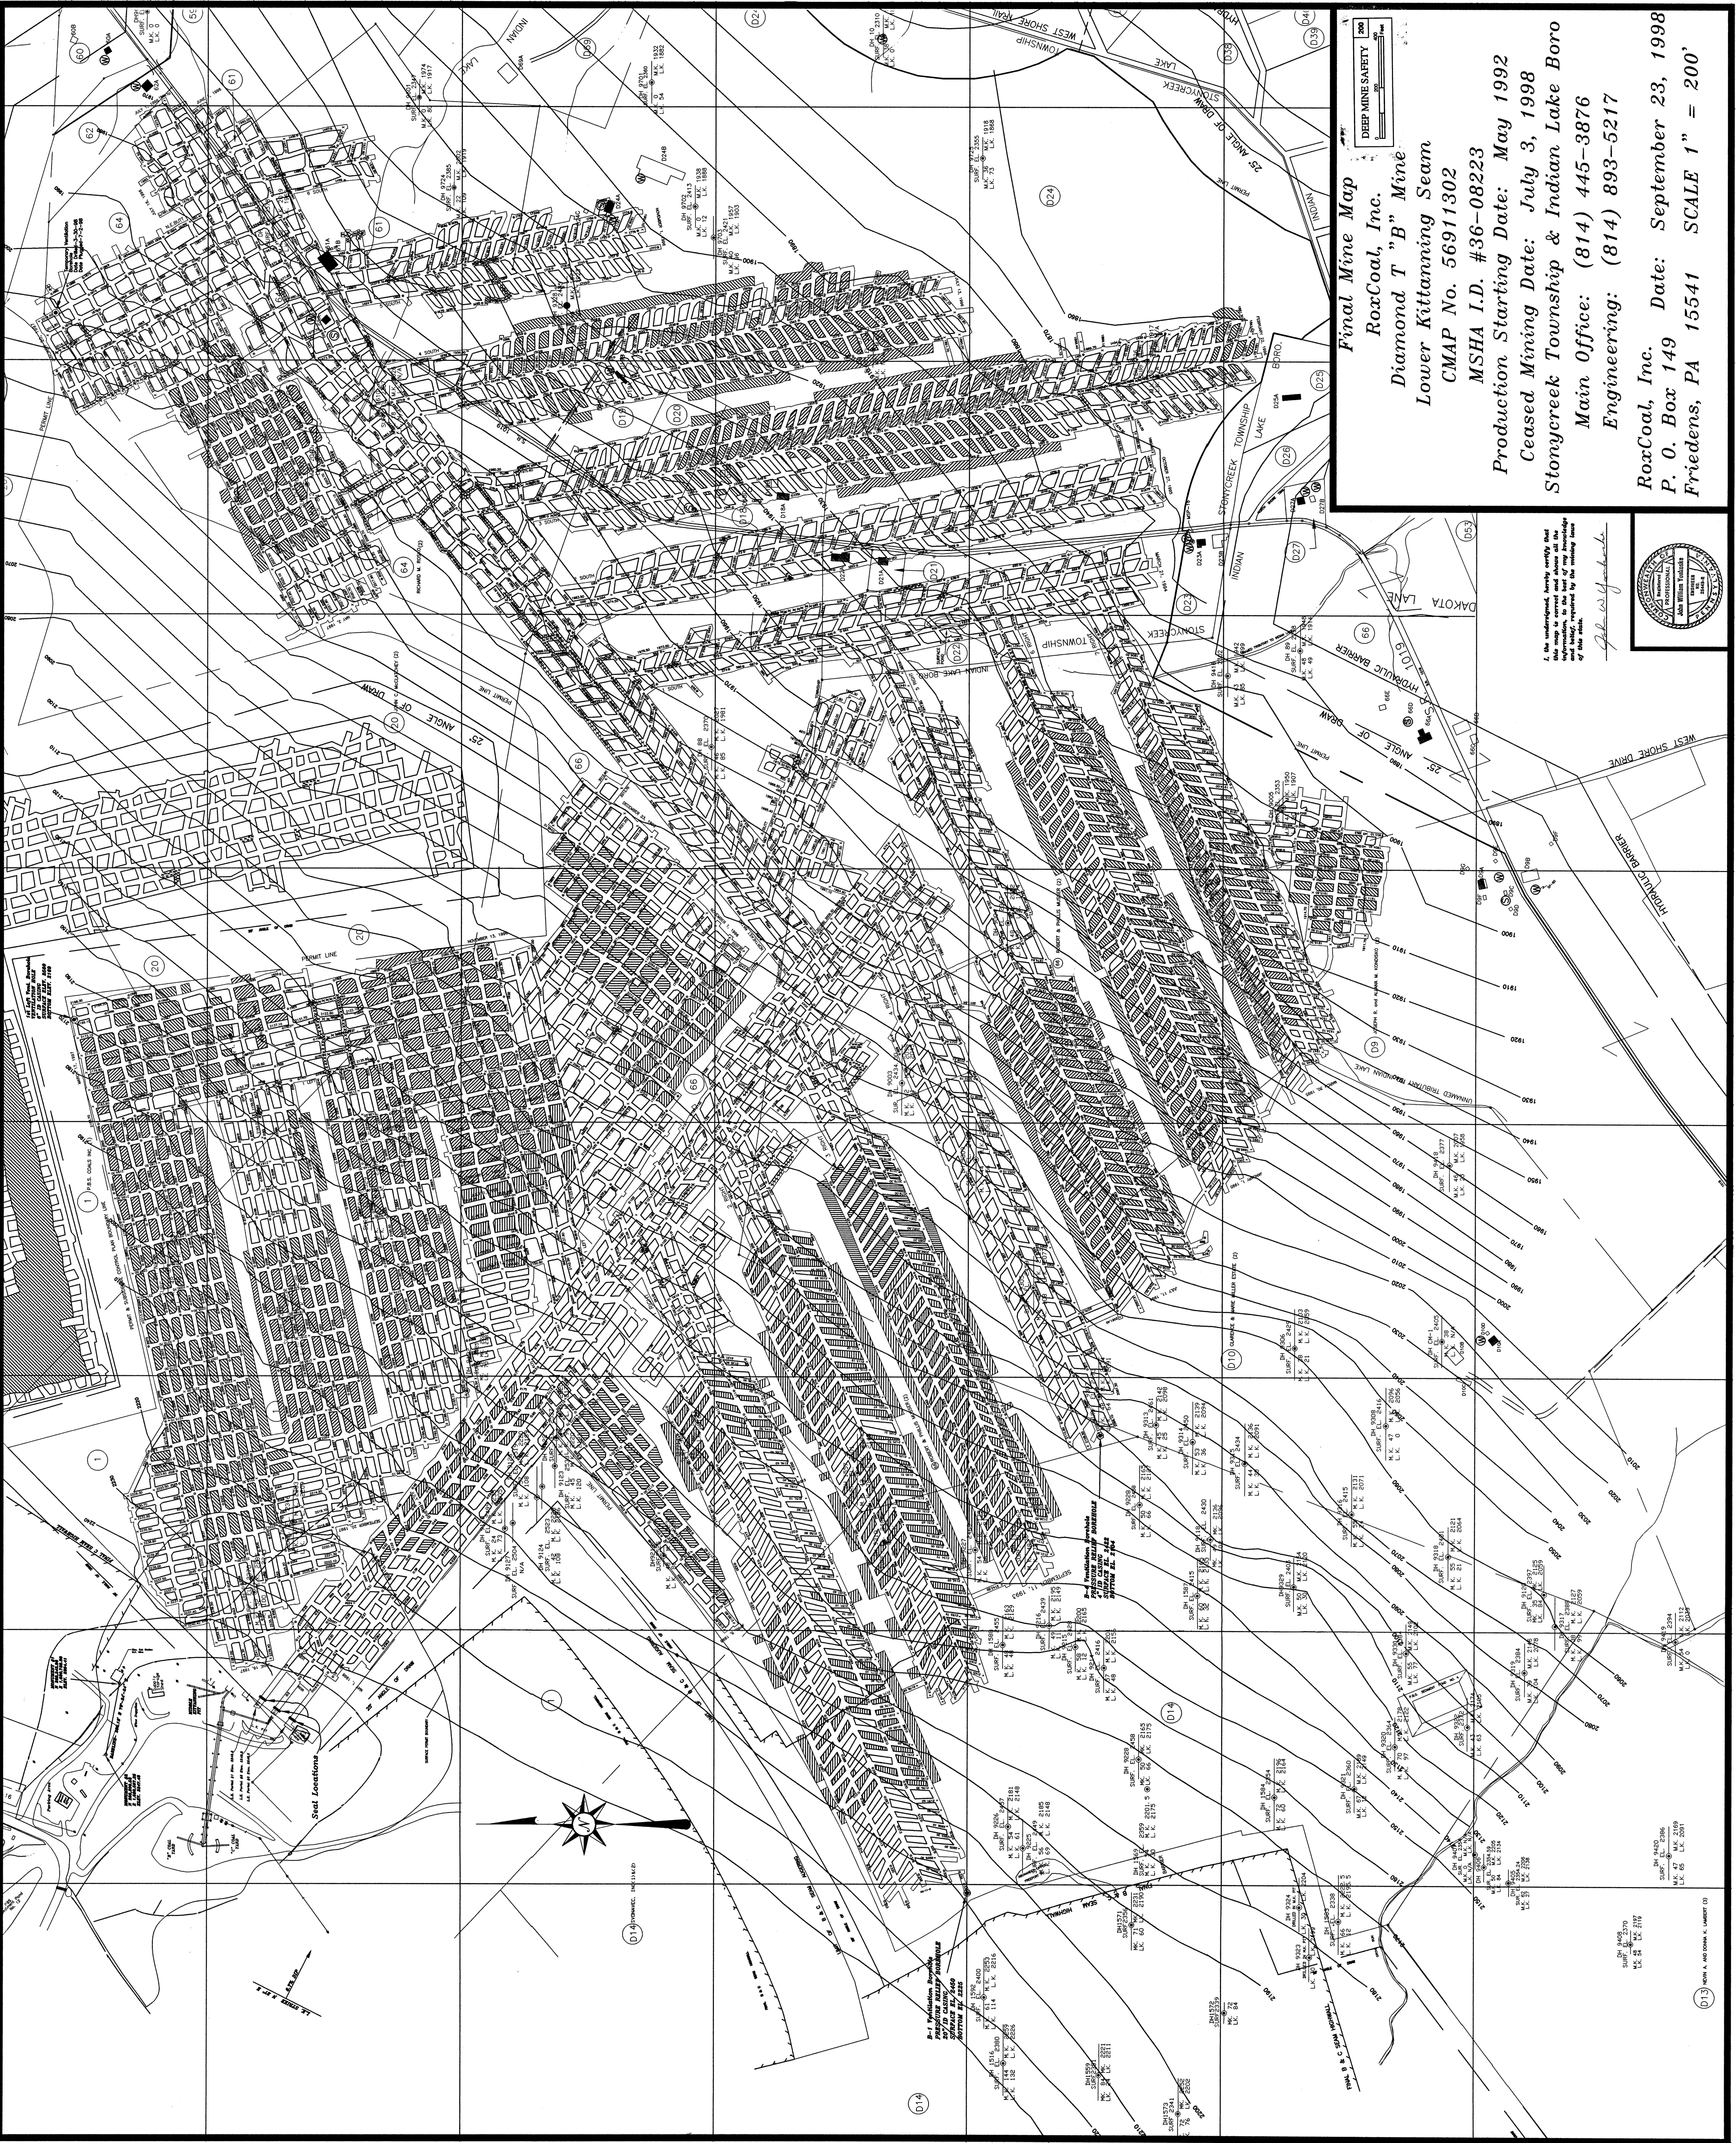

Final Mine Map
RoxCoal, Inc.
Diamond T "B" Mine
Lower Kittanning Seam
CMAP No. 56911302
MSHA I.D. #36-08223
Production Starting Date: May 1992
Ceased Mining Date: July 3, 1998
Stonycreek Township & Indian Lake Boro
Main Office: (814) 445-3876
Engineering: (814) 893-5217
RoxCoal, Inc. Date: September 23, 1998
P. O. Box 149
Friedens, PA 15541
SCALE 1" = 200'


John W. Fink

