


EMILIE No. 4 MINE
FINAL MAP
1" = 400'

4-10-96
RTA

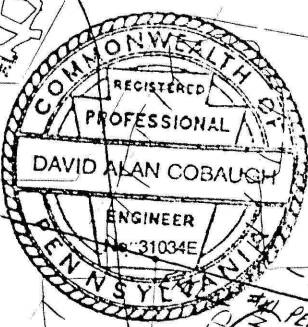

David A. Corbush



SLOPE -
SEALED/BACKFILLED

No. 1 SHAFT
2 COMPARTMENT - INTAKE/RETURN
SEALED

COAL TRANSFER SHAFT
SEALED

No. 3 SHAFT
INTAKE
SEALED

COAL TRANSFER SHAFT
SEALED

No. 4 SHAFT
2 COMPARTMENT - INTAKE/RETURN
SEALED

No. 2 SHAFT
1 COMPARTMENT - INTAKE
SEALED

EMILIE #4 MINE
UPDATED AS OF 12-27-95
SCALE 1" = 400'
FINAL POSTING

