


#326
6-14-99
C.C.

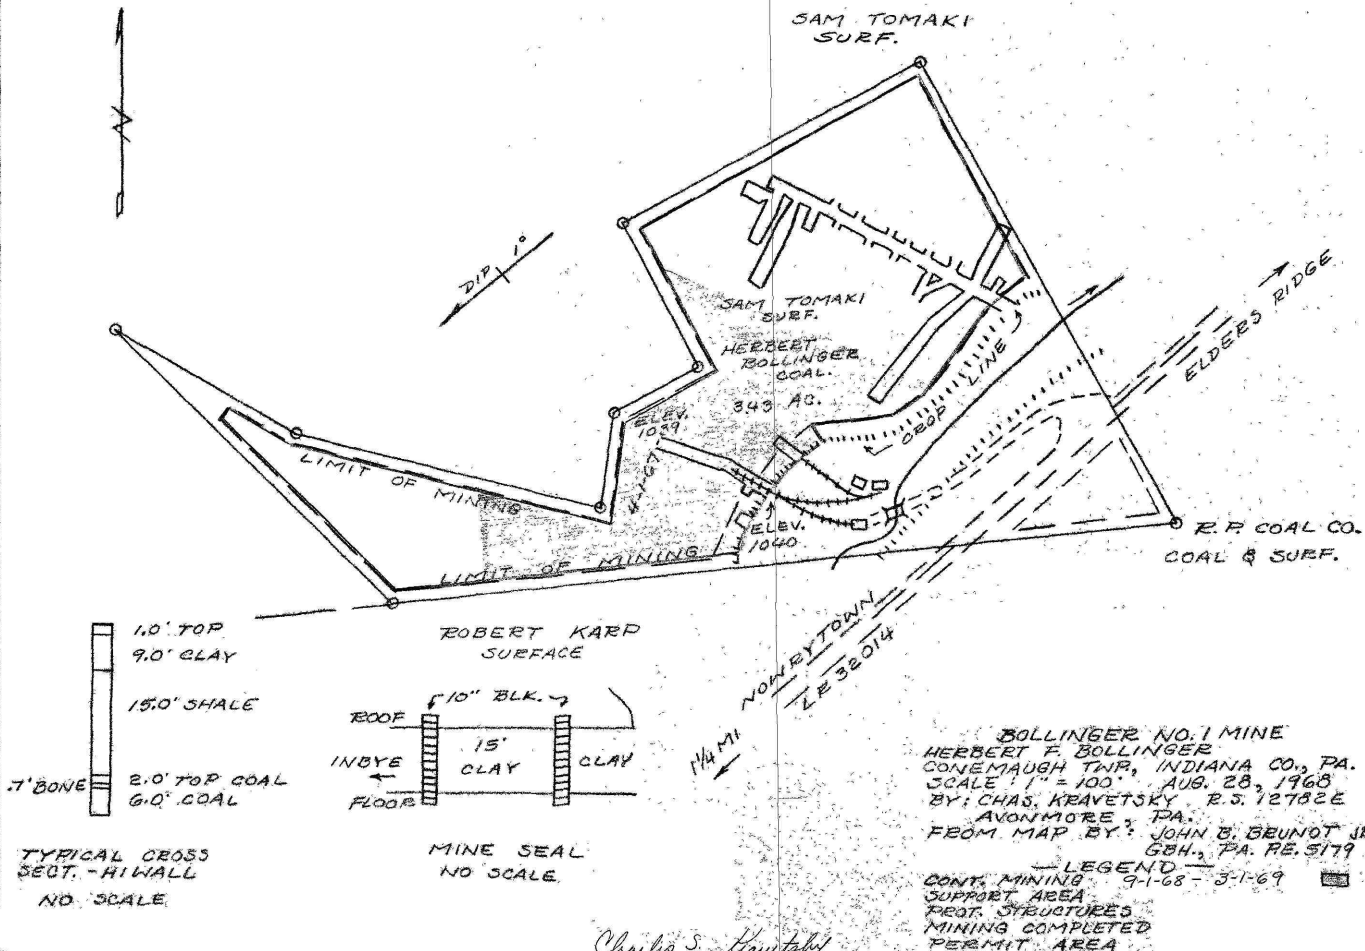

Charles S. Hantelky