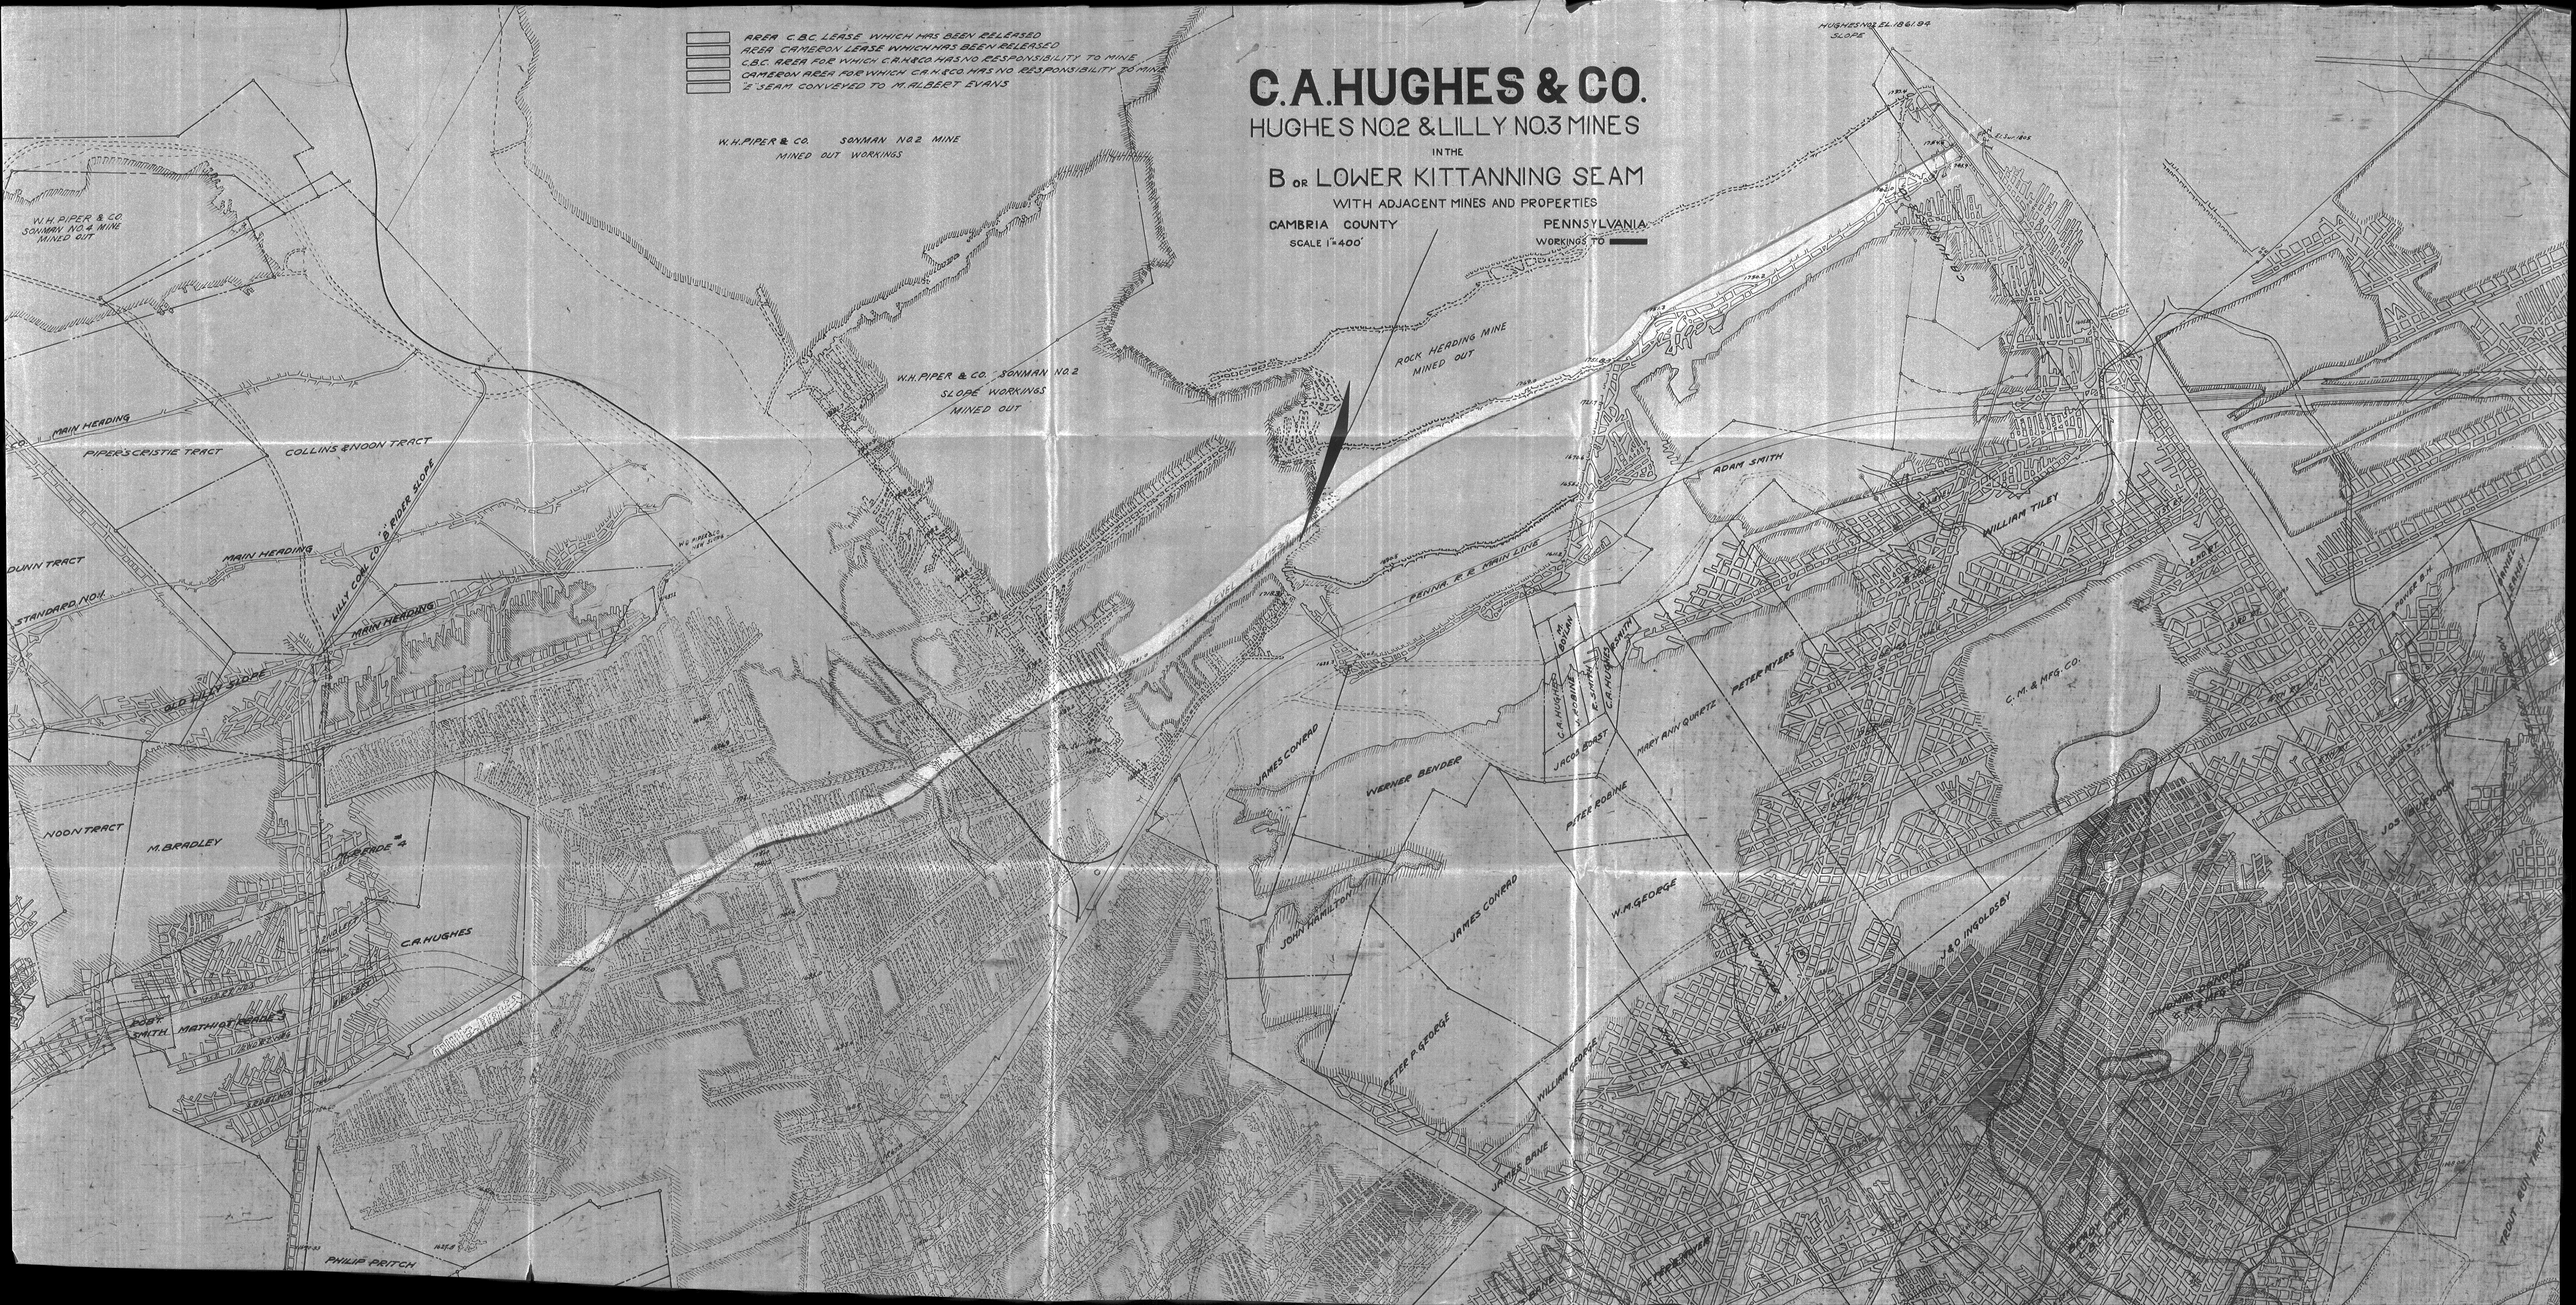

AREA C.B.C. LEASE WHICH HAS BEEN RELEASED
AREA CAMERON LEASE WHICH HAS BEEN RELEASED
C.B.C. AREA FOR WHICH C.A.H.&CO. HAS NO RESPONSIBILITY TO MINE
CAMERON AREA FOR WHICH C.A.H.&CO. HAS NO RESPONSIBILITY TO MINE
'Z' SEAM CONVEYED TO M. ALBERT EVANS
C.A. HUGHES & CO.
HUGHES NO.2 & LILLY NO.3 MINES
IN THE
B OR LOWER KITTANNING SEAM
WITH ADJACENT MINES AND PROPERTIES
CAMBRIA COUNTY
PENNSYLVANIA
SCALE 1"=400'
WORKINGS TO
W.H. PIPER & CO. SONMAN NO.2 MINE
MINED OUT WORKINGS
W.H. PIPER & CO. SONMAN NO.4 MINE
MINED OUT
W.H. PIPER & CO. SONMAN NO.2
SLOPE WORKINGS
MINED OUT
ROCK HERDING MINE
MINED OUT
HUGHES NO.2 EL. 1861.94
SLOPE
MAIN HEADING
PIPER'S CRISTIE TRACT
COLLINS & NOON TRACT
DUNN TRACT
STANDARD NO.4
LILLY COAL CO. 8° RISE SLOPE
MAIN HEADING
MAIN HEADING
OLD LILLY SLOPE
NOON TRACT
M. BRADLEY
C.A. HUGHES
PENNA. R.R. MAIN LINE
ADAM SMITH
WILLIAM TILEY
PETER AYERS
MARY ANN QUARTZ
C.M. & MFG. CO.
JAMES CONARD
WERNER BENDER
PETER ROBINE
JOHN HAMILTON
JAMES CONARD
W.M. GEORGE
J. & O. INGOLDSBY
PETER A. GEORGE
WILLIAM GEORGE
JAMES BAILE
PHILIP PRITCH
TROUT RUN TRACT