


5.

Alfred W Wagner

NOTARY PUBLIC
My Commission Expires January 4, 1959

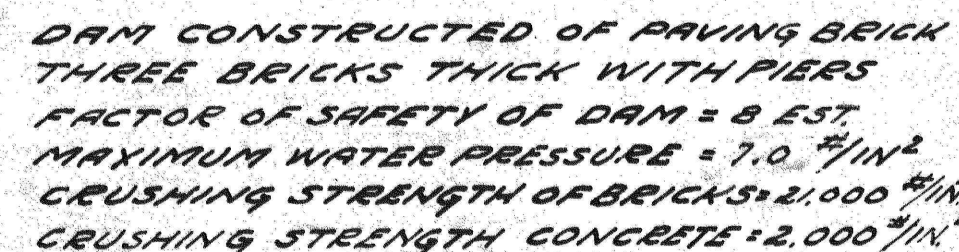


[Signature]
ENGINEER



W. R. Cunningham
W. R. CUNNINGHAM, INSPECTOR
27TH BITUMINOUS DISTRICT.

Richard E. George
RICHARD E. GEORGE, INSPECTOR
18TH BITUMINOUS DISTRICT.

Charles E. Fisher
CHARLES E. FISHER, INSPECTOR
10TH BITUMINOUS DISTRICT

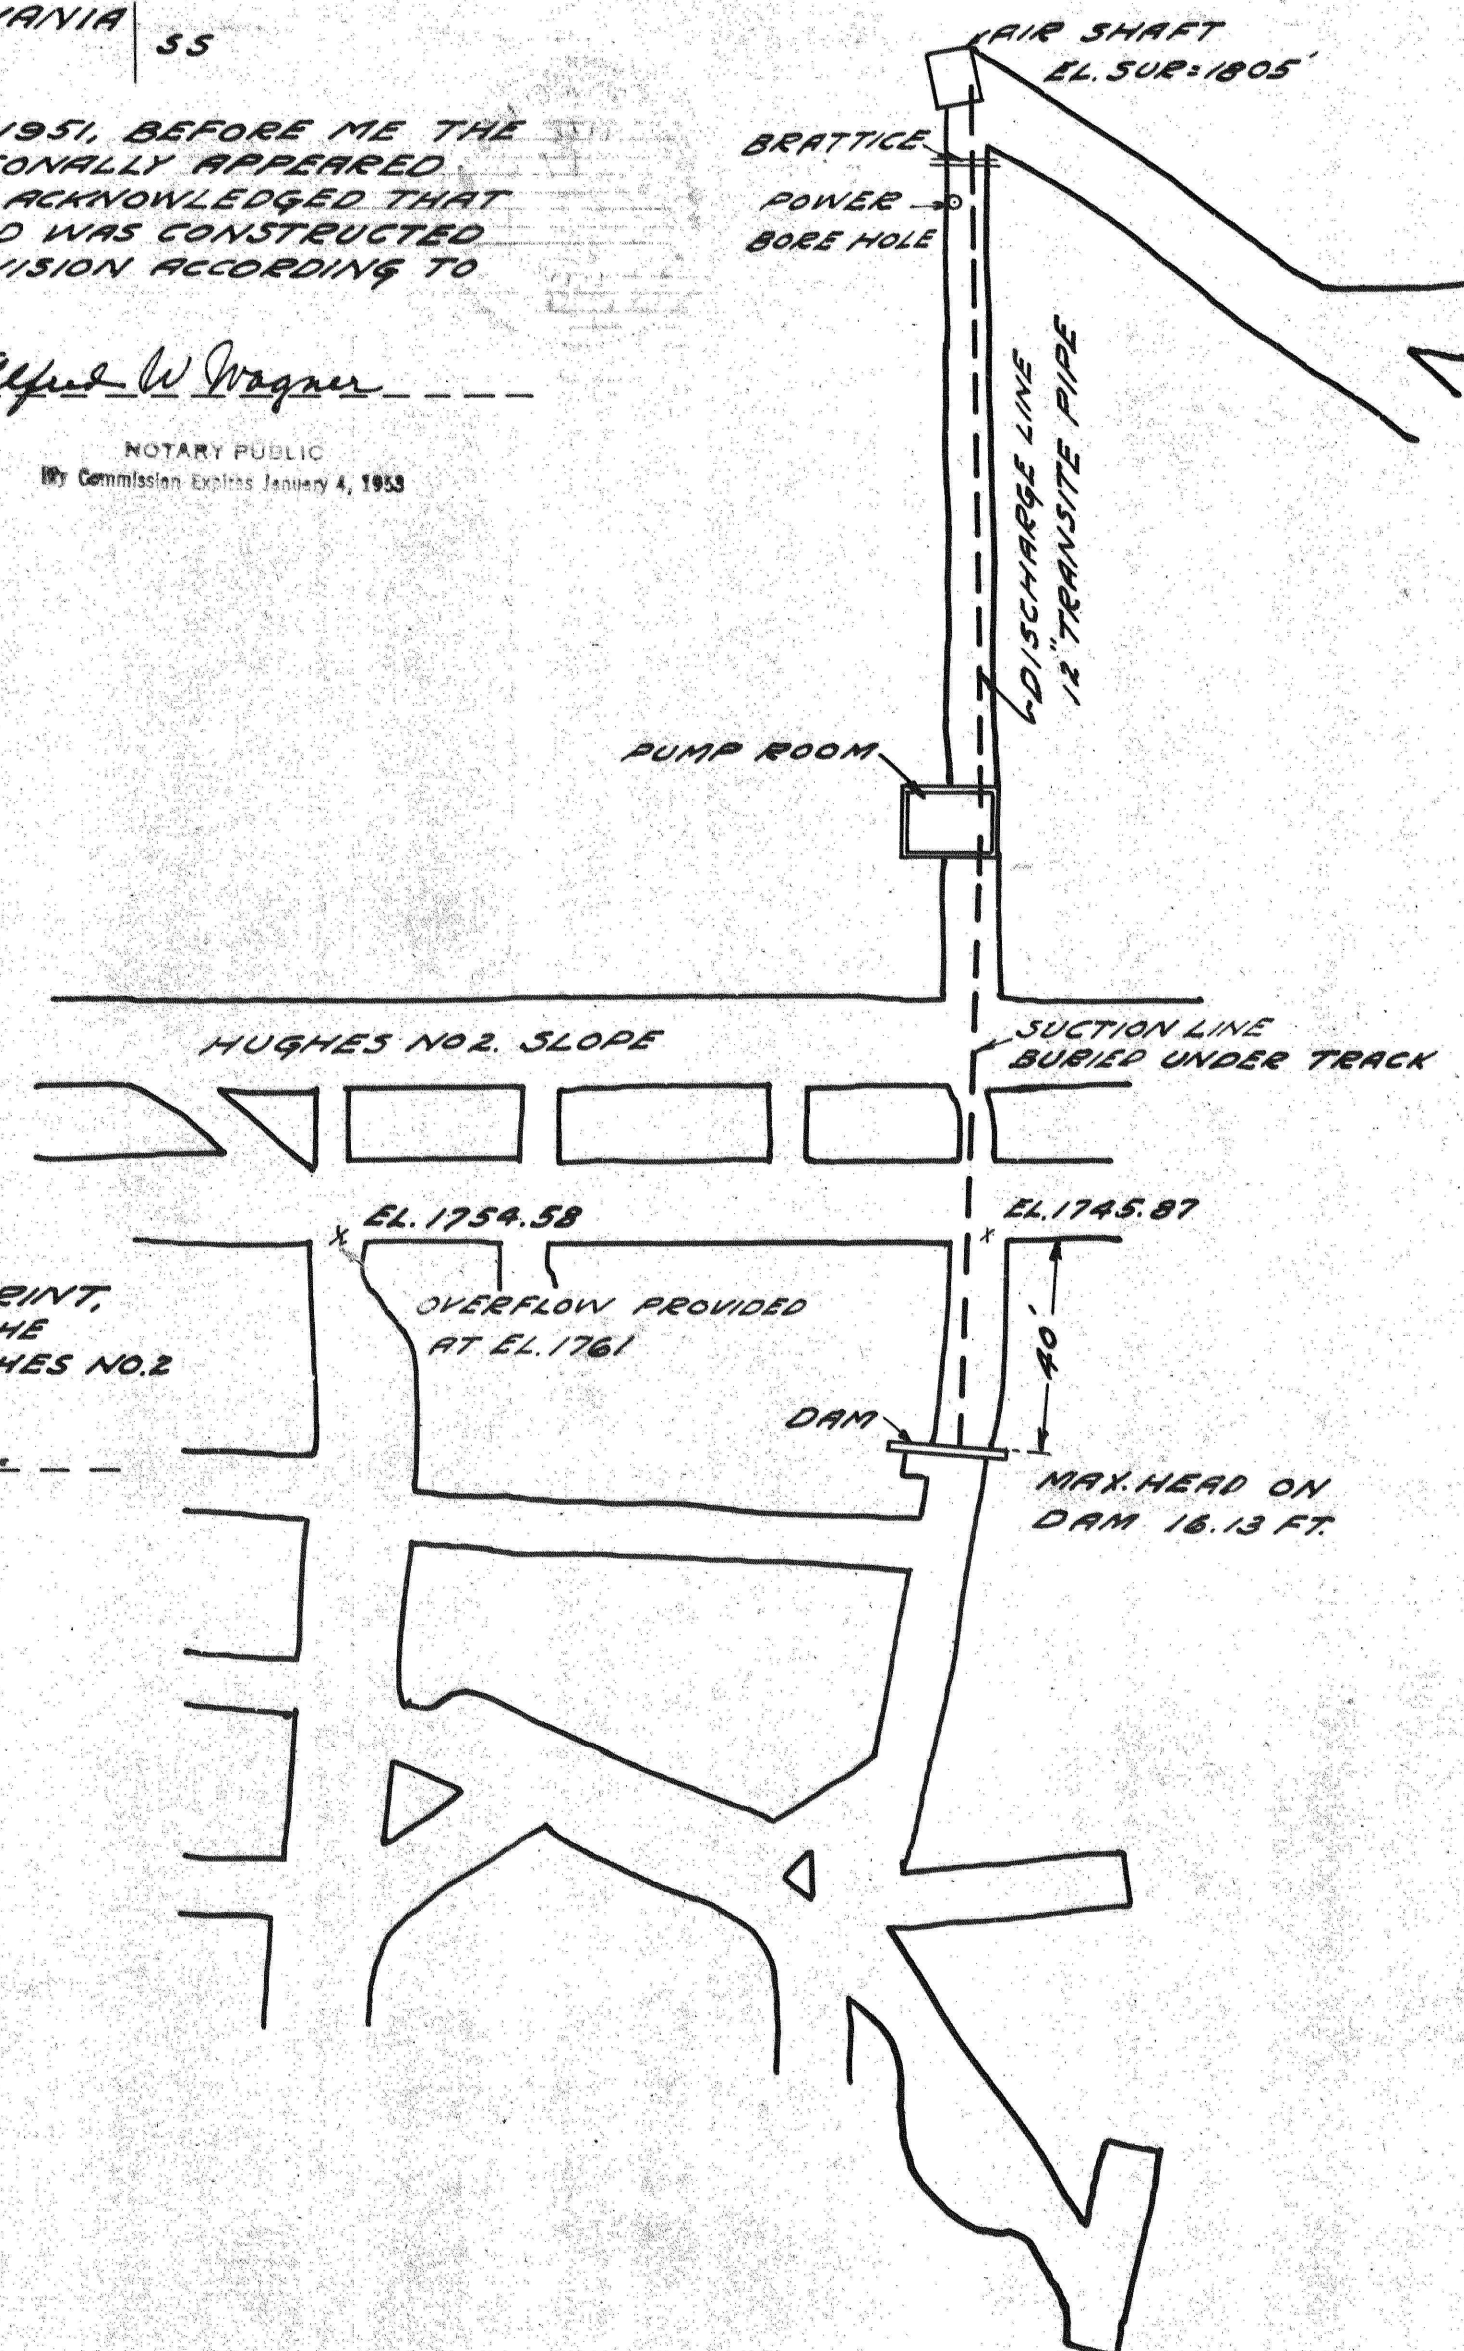

C. A. HUGHES & CO.
CRESSON, PA.

HUGHES NO.2 MINE
SUMP AND DAM
ROCK HEADING CUTTHROUGH

SCALE <i>3/8" = 1 FT. 1" = 40 FT.</i>	APPROVED
DRAWN BY <i>B.P.J.</i>	<i>K-4-21</i>
CHECKED BY <i>B.P.J.</i>	
DATE <i>3-12-51</i>	