




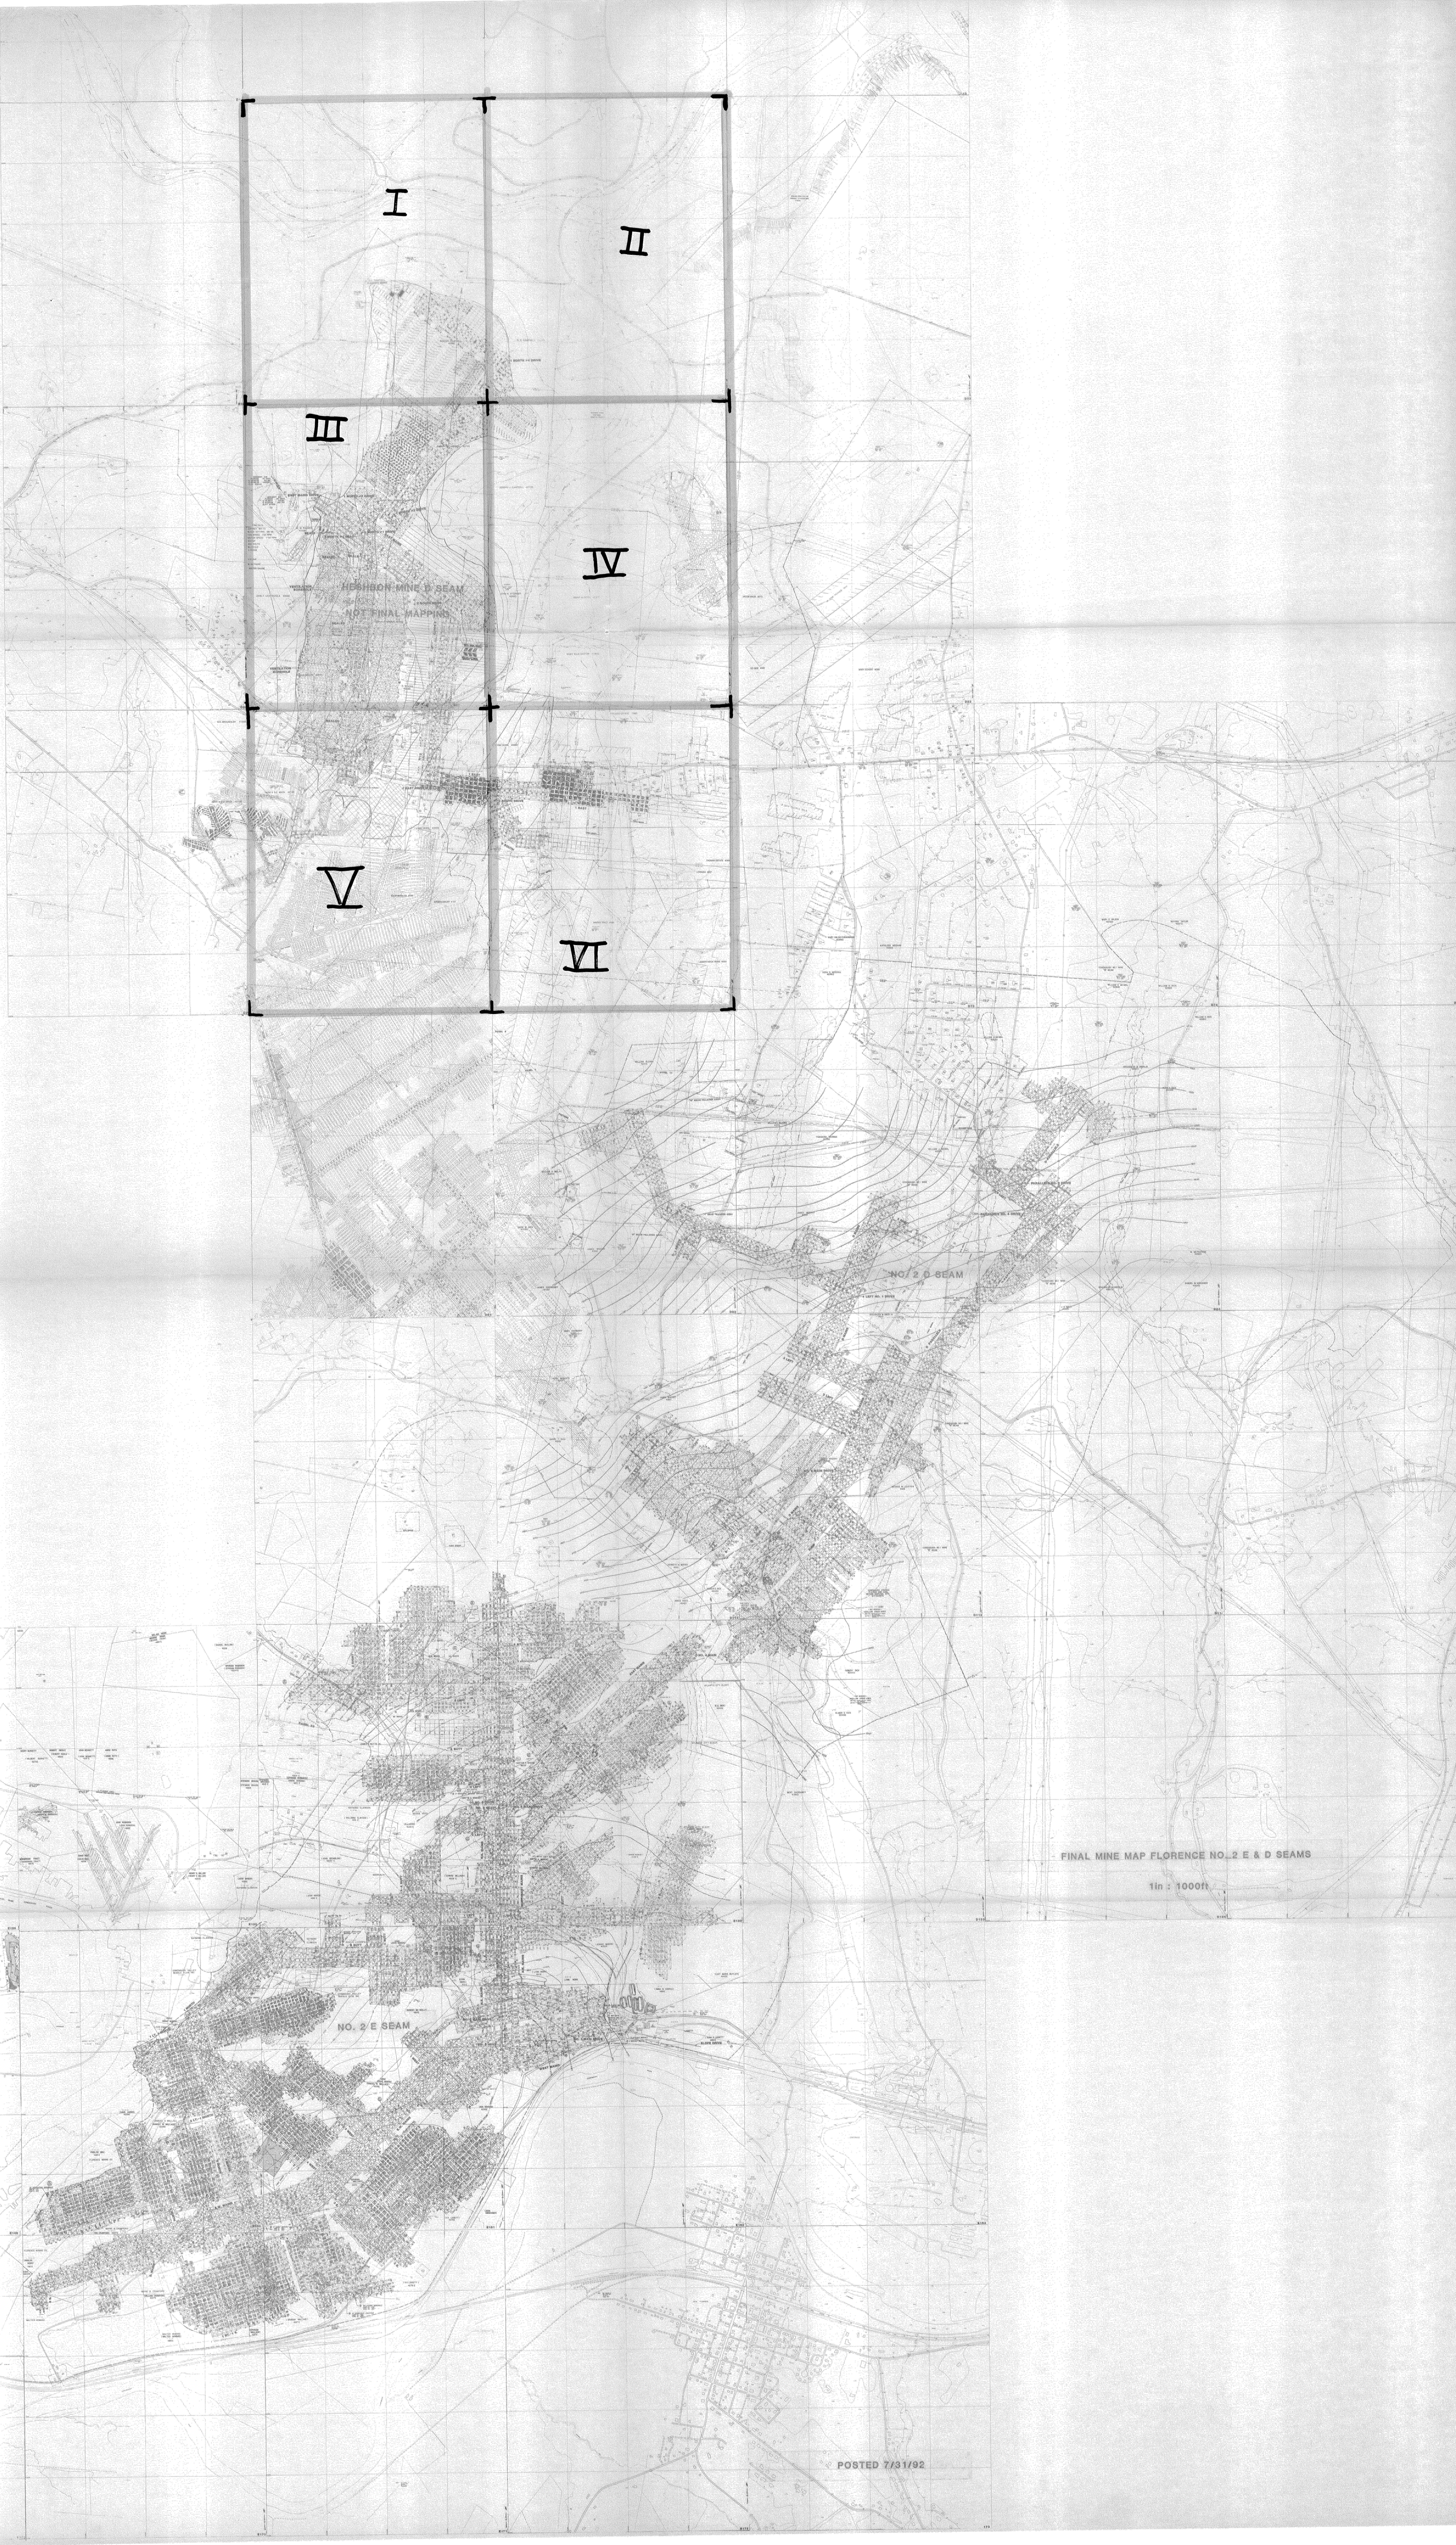

FINAL MINE MAP FLORENCE NO. 2 E & D SEAMS

1 in = 1000 ft

POSTED 7/31/92