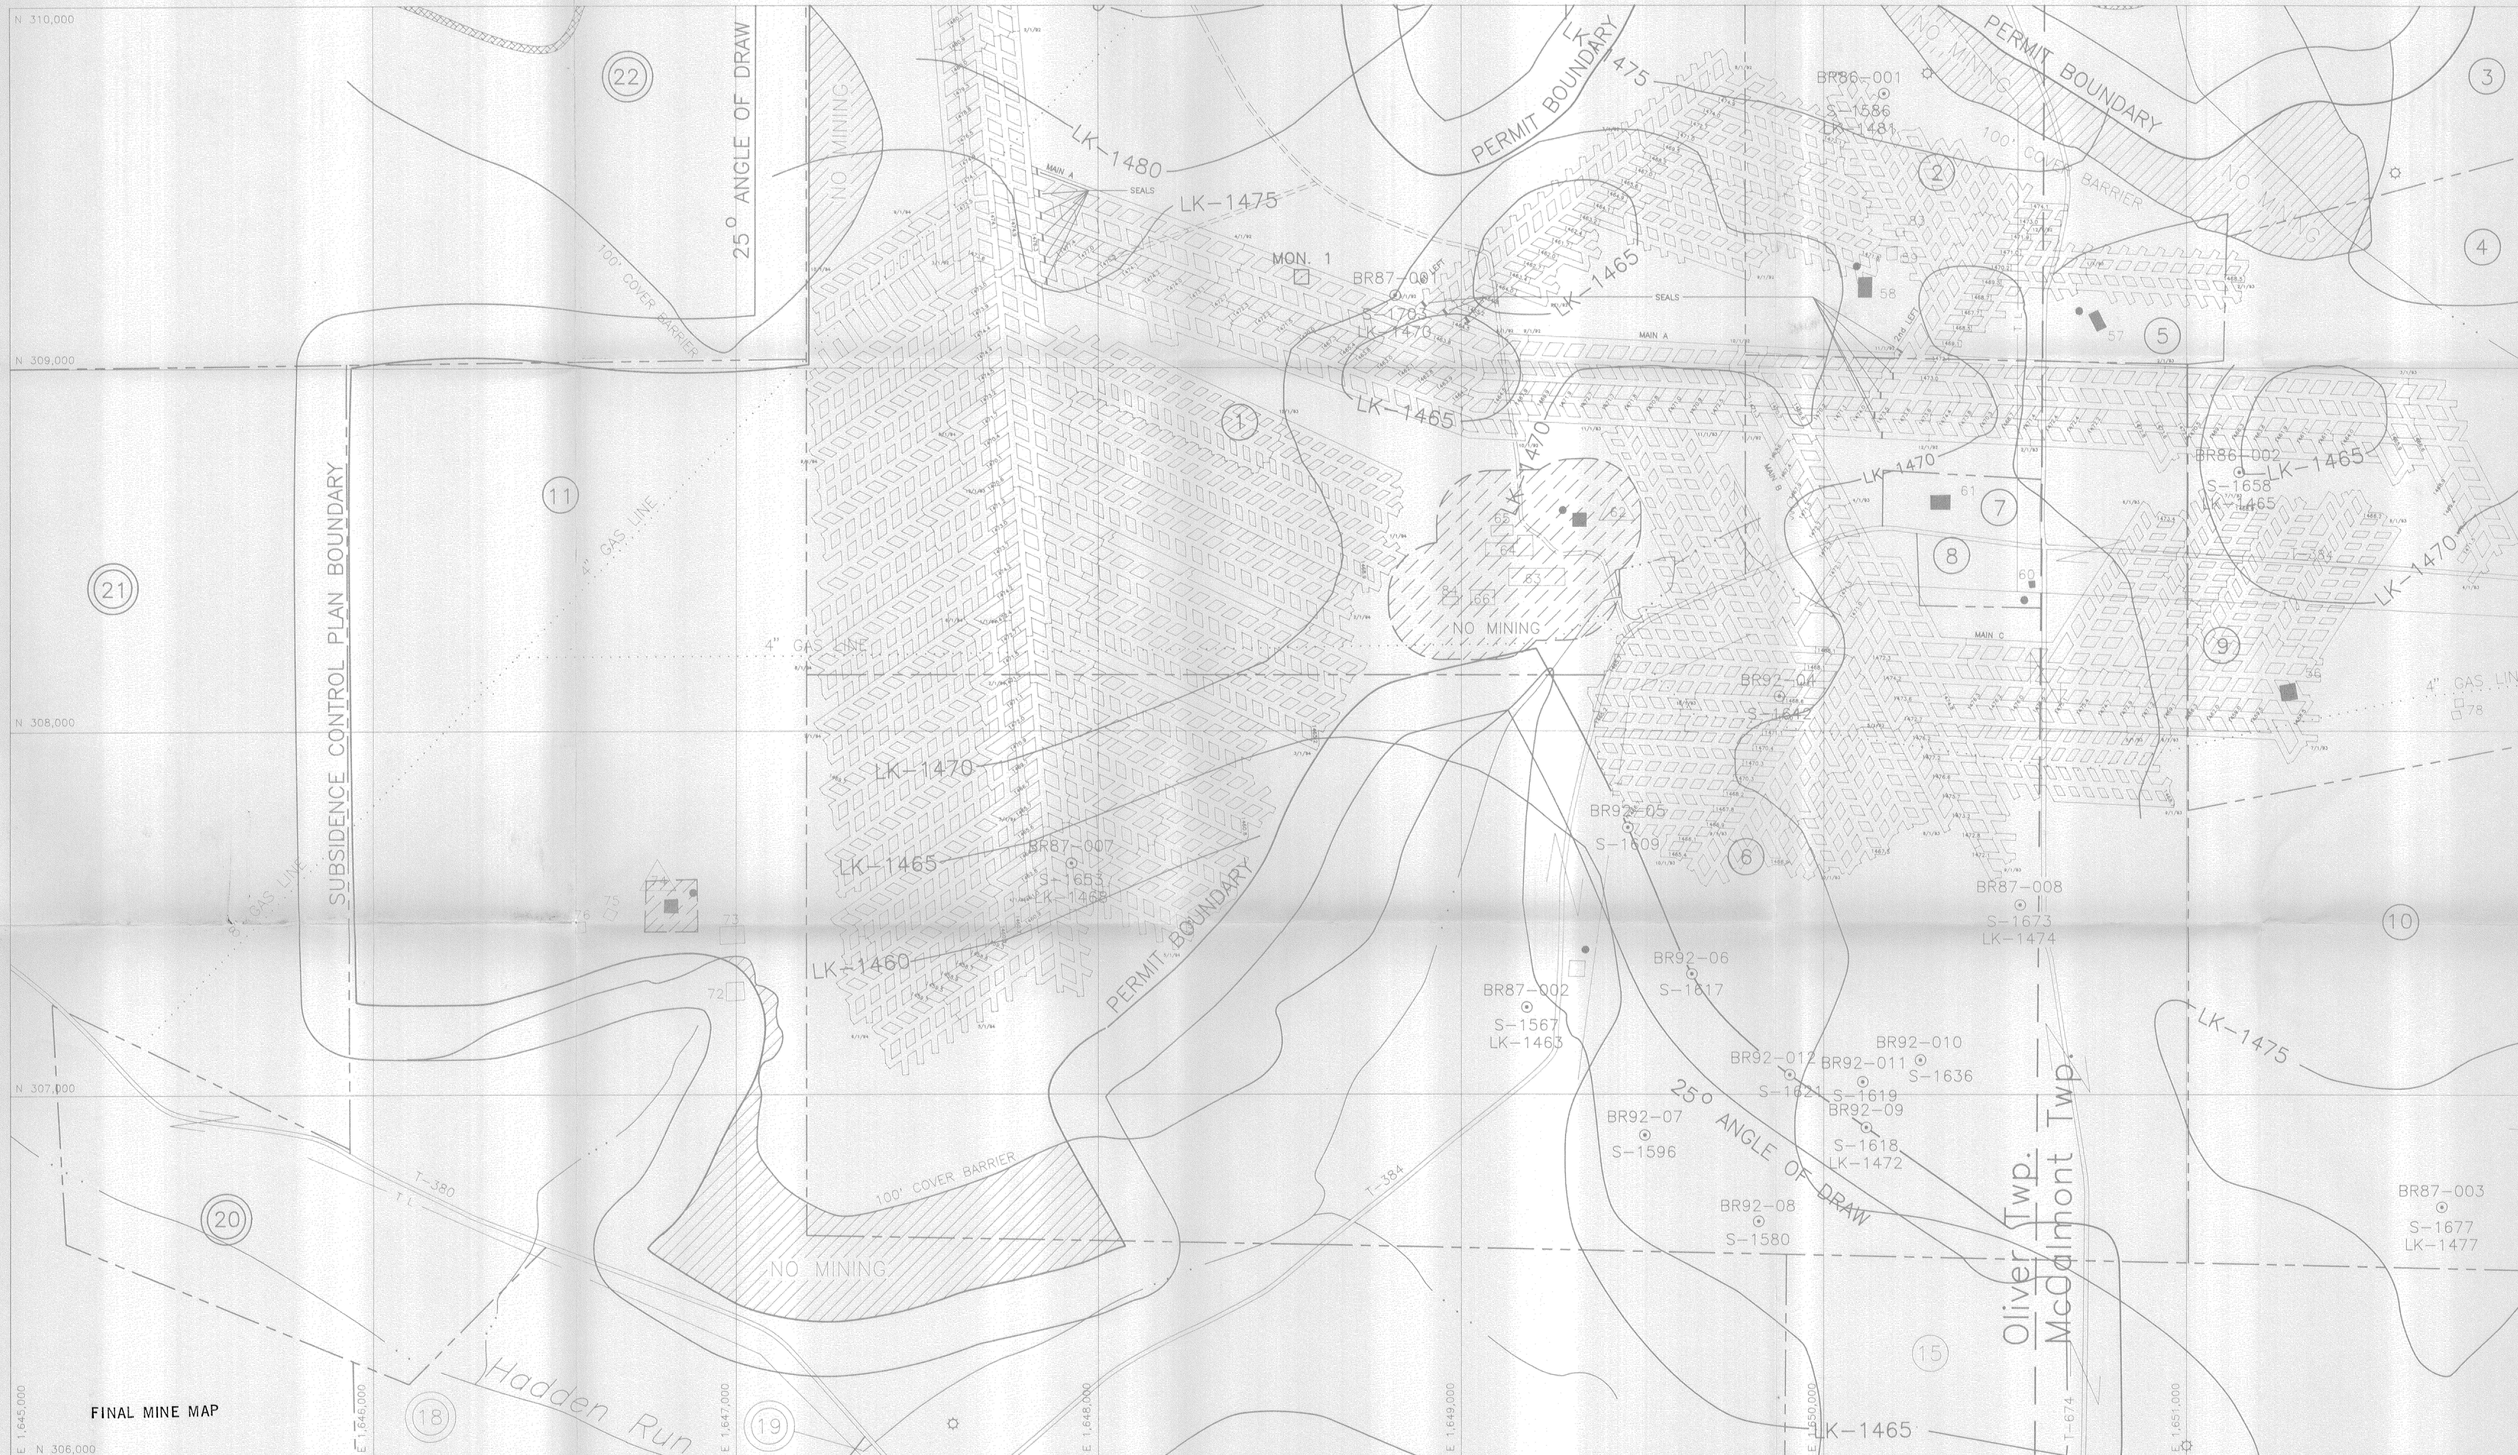

FINAL MINE MAP

CMAP No. 33911301

Stanford

Doverspike Bros. Coal Co.
R.D. #4, Box 271, Punxsutawney, PA 15767
McCalmont, Oliver & Young Twps., Jefferson County

CLUTCH RUN MINE

SCALE: 1" = 200' | SHEET 3 of 6

MODULE 19.5

- PERMIT AREA
- PROPERTY LINES
- (31) PROPERTY OWNERS
- (9) CONT. PROPERTY OWNERS
- PRE-66 DWELLINGS
- DWELLINGS, STRUCTURES
- PUBLIC BUILDINGS
- —LK-1480— L.K. COAL CONTOURS
- L.K. COAL OUTCROP
- GAS LINE
- GAS WELL
- —T L— TELE./ELEC. LINES
- WATER WELL
- SPRING
- DRILL HOLE
- IMPOUNDMENT
- CEMETERY
- MINE OPENINGS, NOT SEALED
- MINE OPENINGS, SEALED
- STREAMS
- SURVEY STATION
- SUPPORT AREA(No Second Mining)
- IMPOUNDED WATER (In Mine)
- CONTEMPLATED MINING 8/1/94 TO 2/1/95
- 6 MONTH PROJECTIONS
- GAS WELL BARRIER (No Mining Within Barrier Unless Approved)

COMMONWEALTH OF PENNSYLVANIA
REGISTERED PROFESSIONAL
JOSEPH P. KALYNCHUK
ENGINEER
PE 040523 E

SIGNATURE Joseph P. Kalynchuk

DATE 11-3-94