


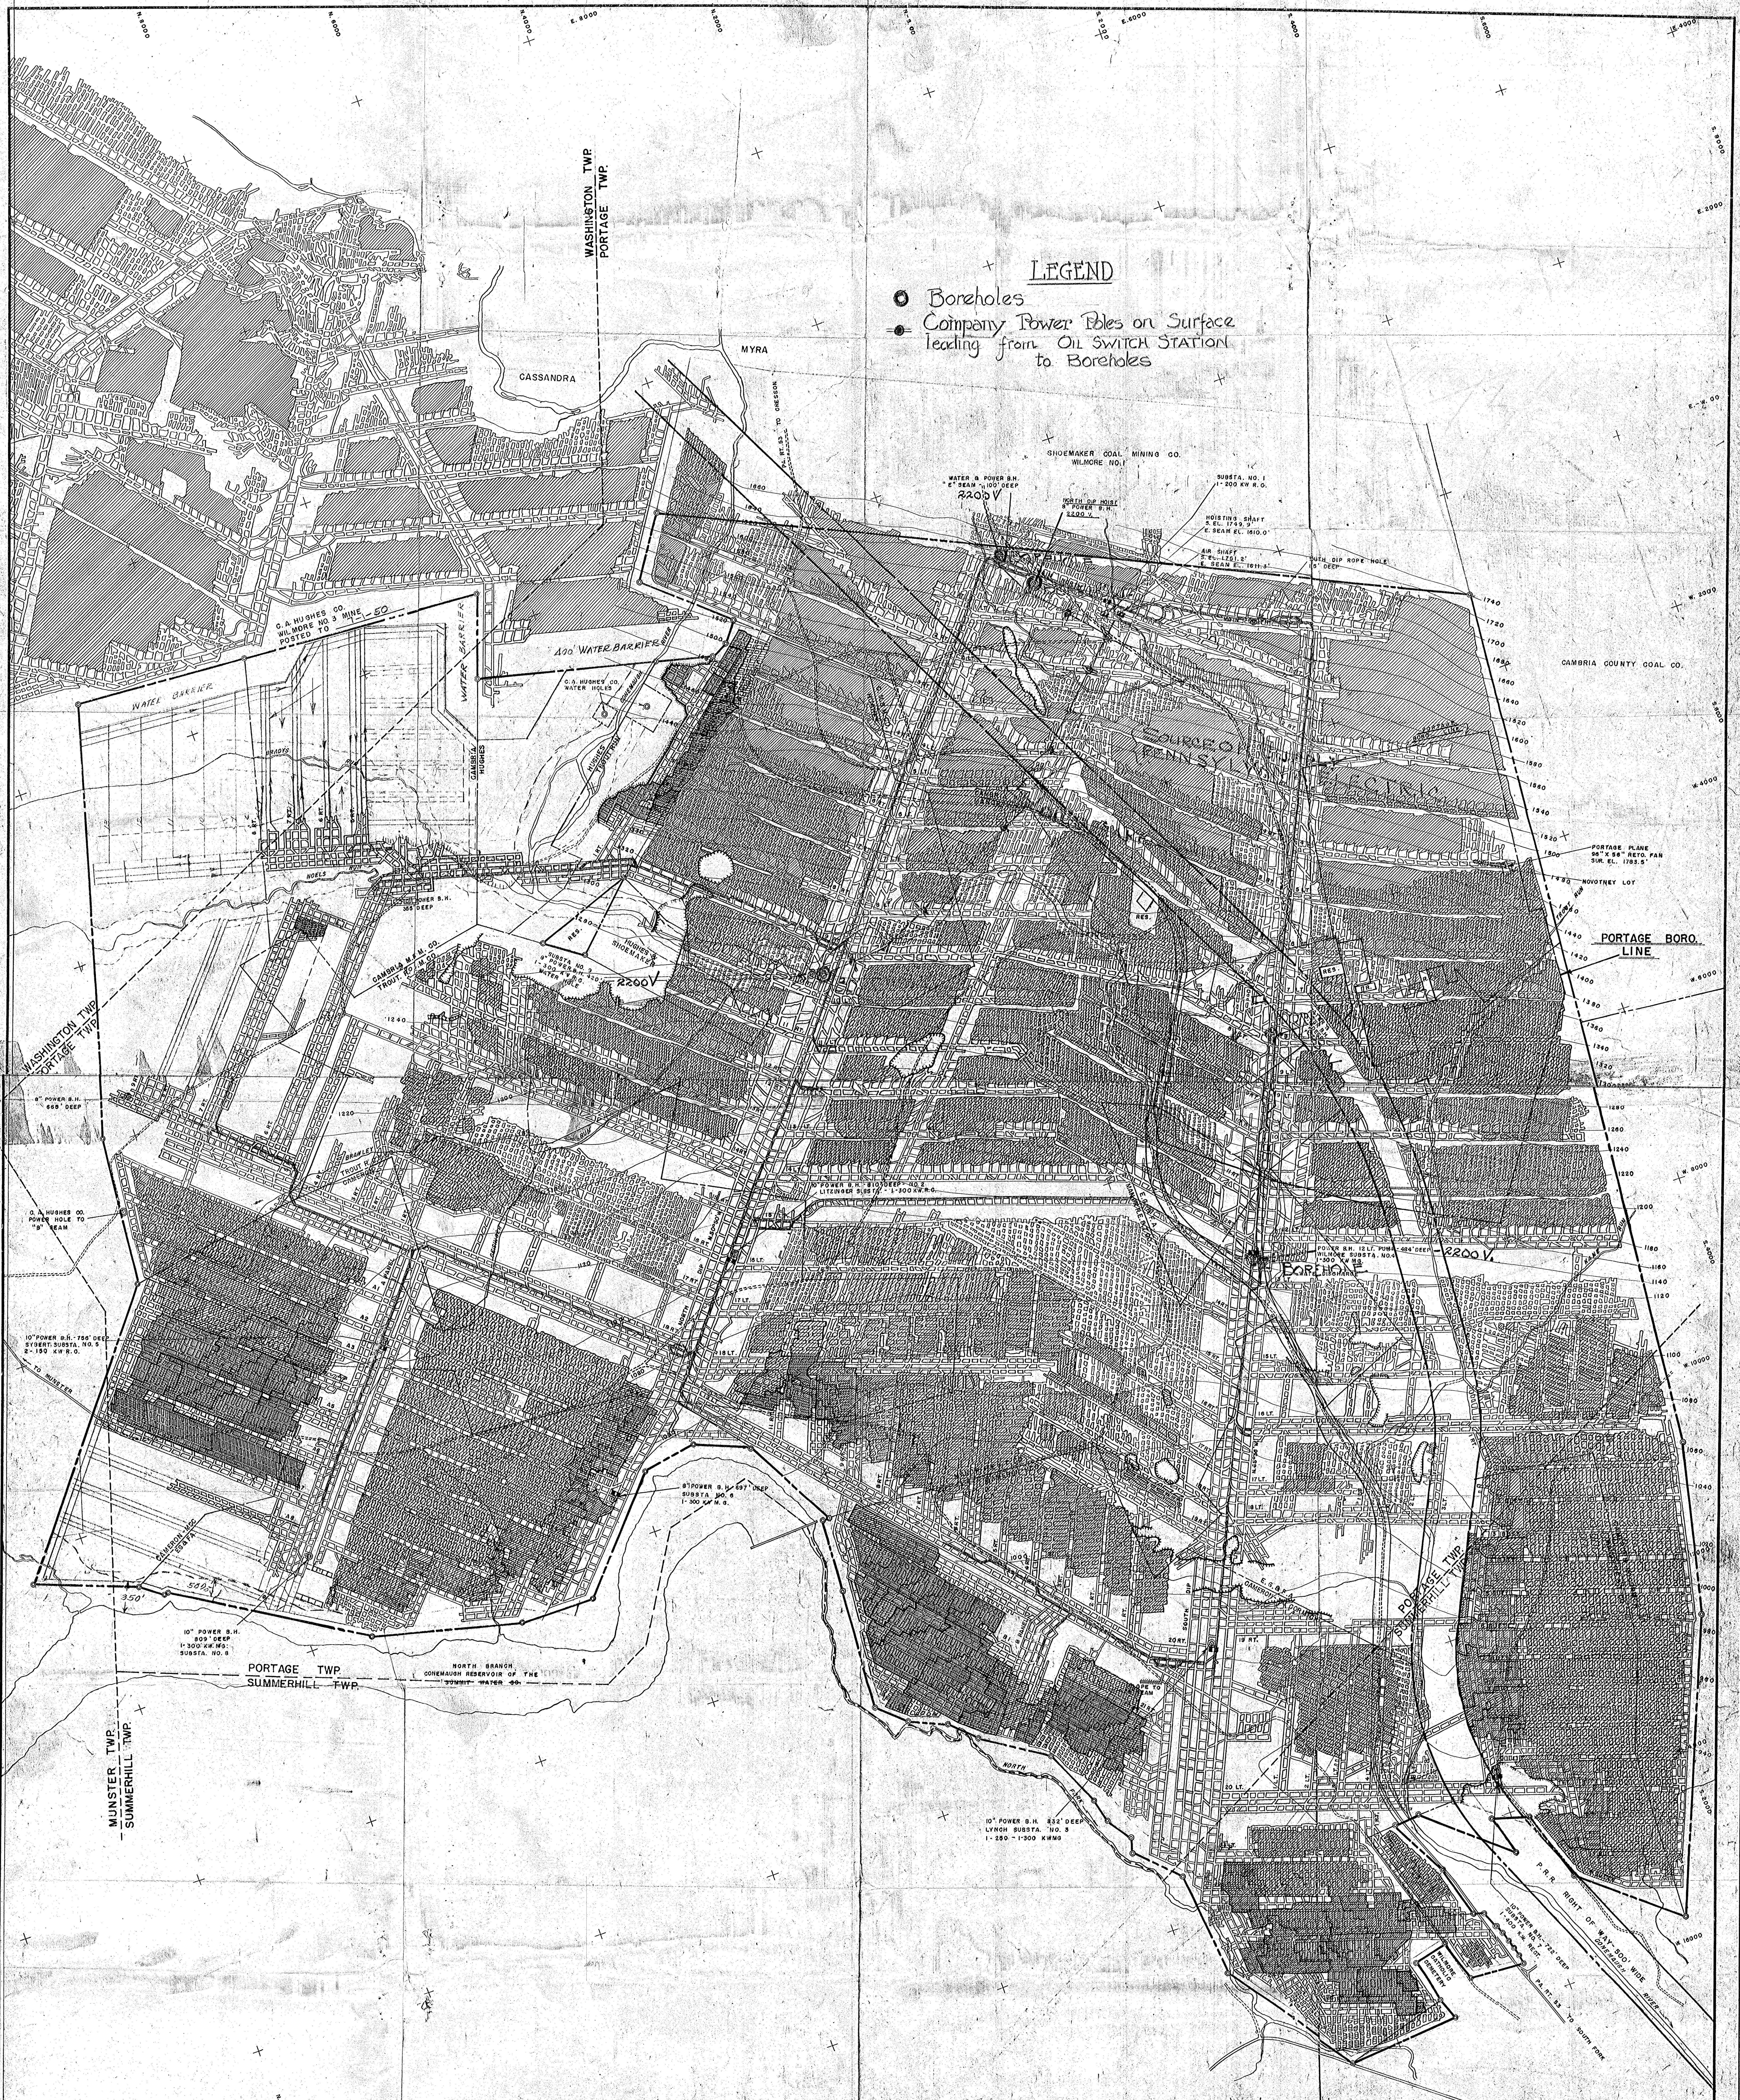

LEGEND

- Boreholes
- Company Power Poles on Surface leading from OIL SWITCH STATION to Boreholes