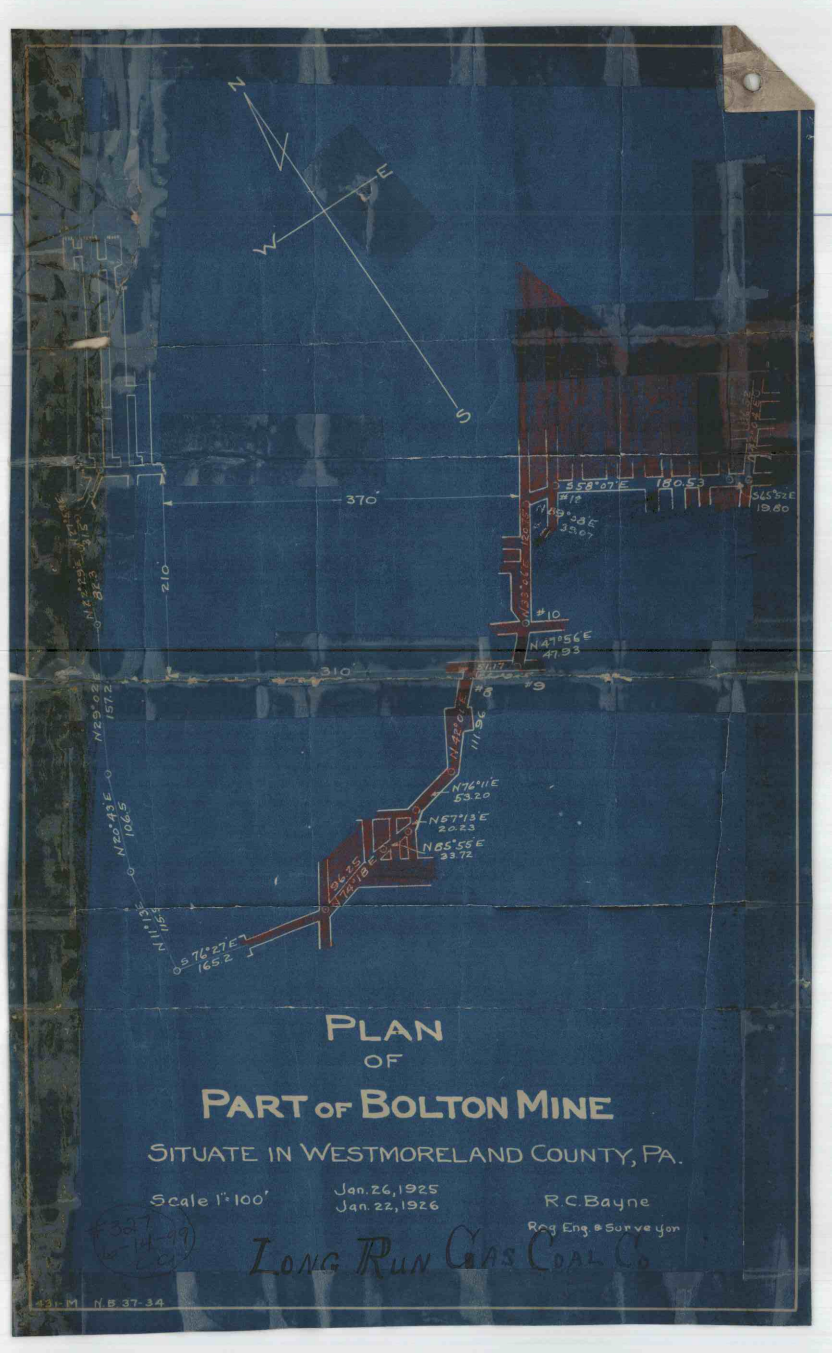
N
E
W
S
370'
210'
310'
S58°07'E
180.53
S65°52'E
19.80
#12
N89°38'E
39.07
#10
N47°56'E
47.93
#9
#8
N42°01'E
111.96
N76°11'E
53.20
N57°13'E
20.23
N85°55'E
33.72
96.25
N74°18'E
S76°27'E
165.2
N11°13'E
115.5
N20°43'E
106.5
N29°02'E
157.2
N22°29'E
82.3
N27°51'E
315
PLAN
OF
PART OF BOLTON MINE
SITUATE IN WESTMORELAND COUNTY, PA.
Scale 1" = 100'
Jan. 26, 1925
Jan. 22, 1926
R.C. Bayne
Reg Eng. & Surveyor
LONG RUN GAS COAL CO
431-M N.B. 37-34