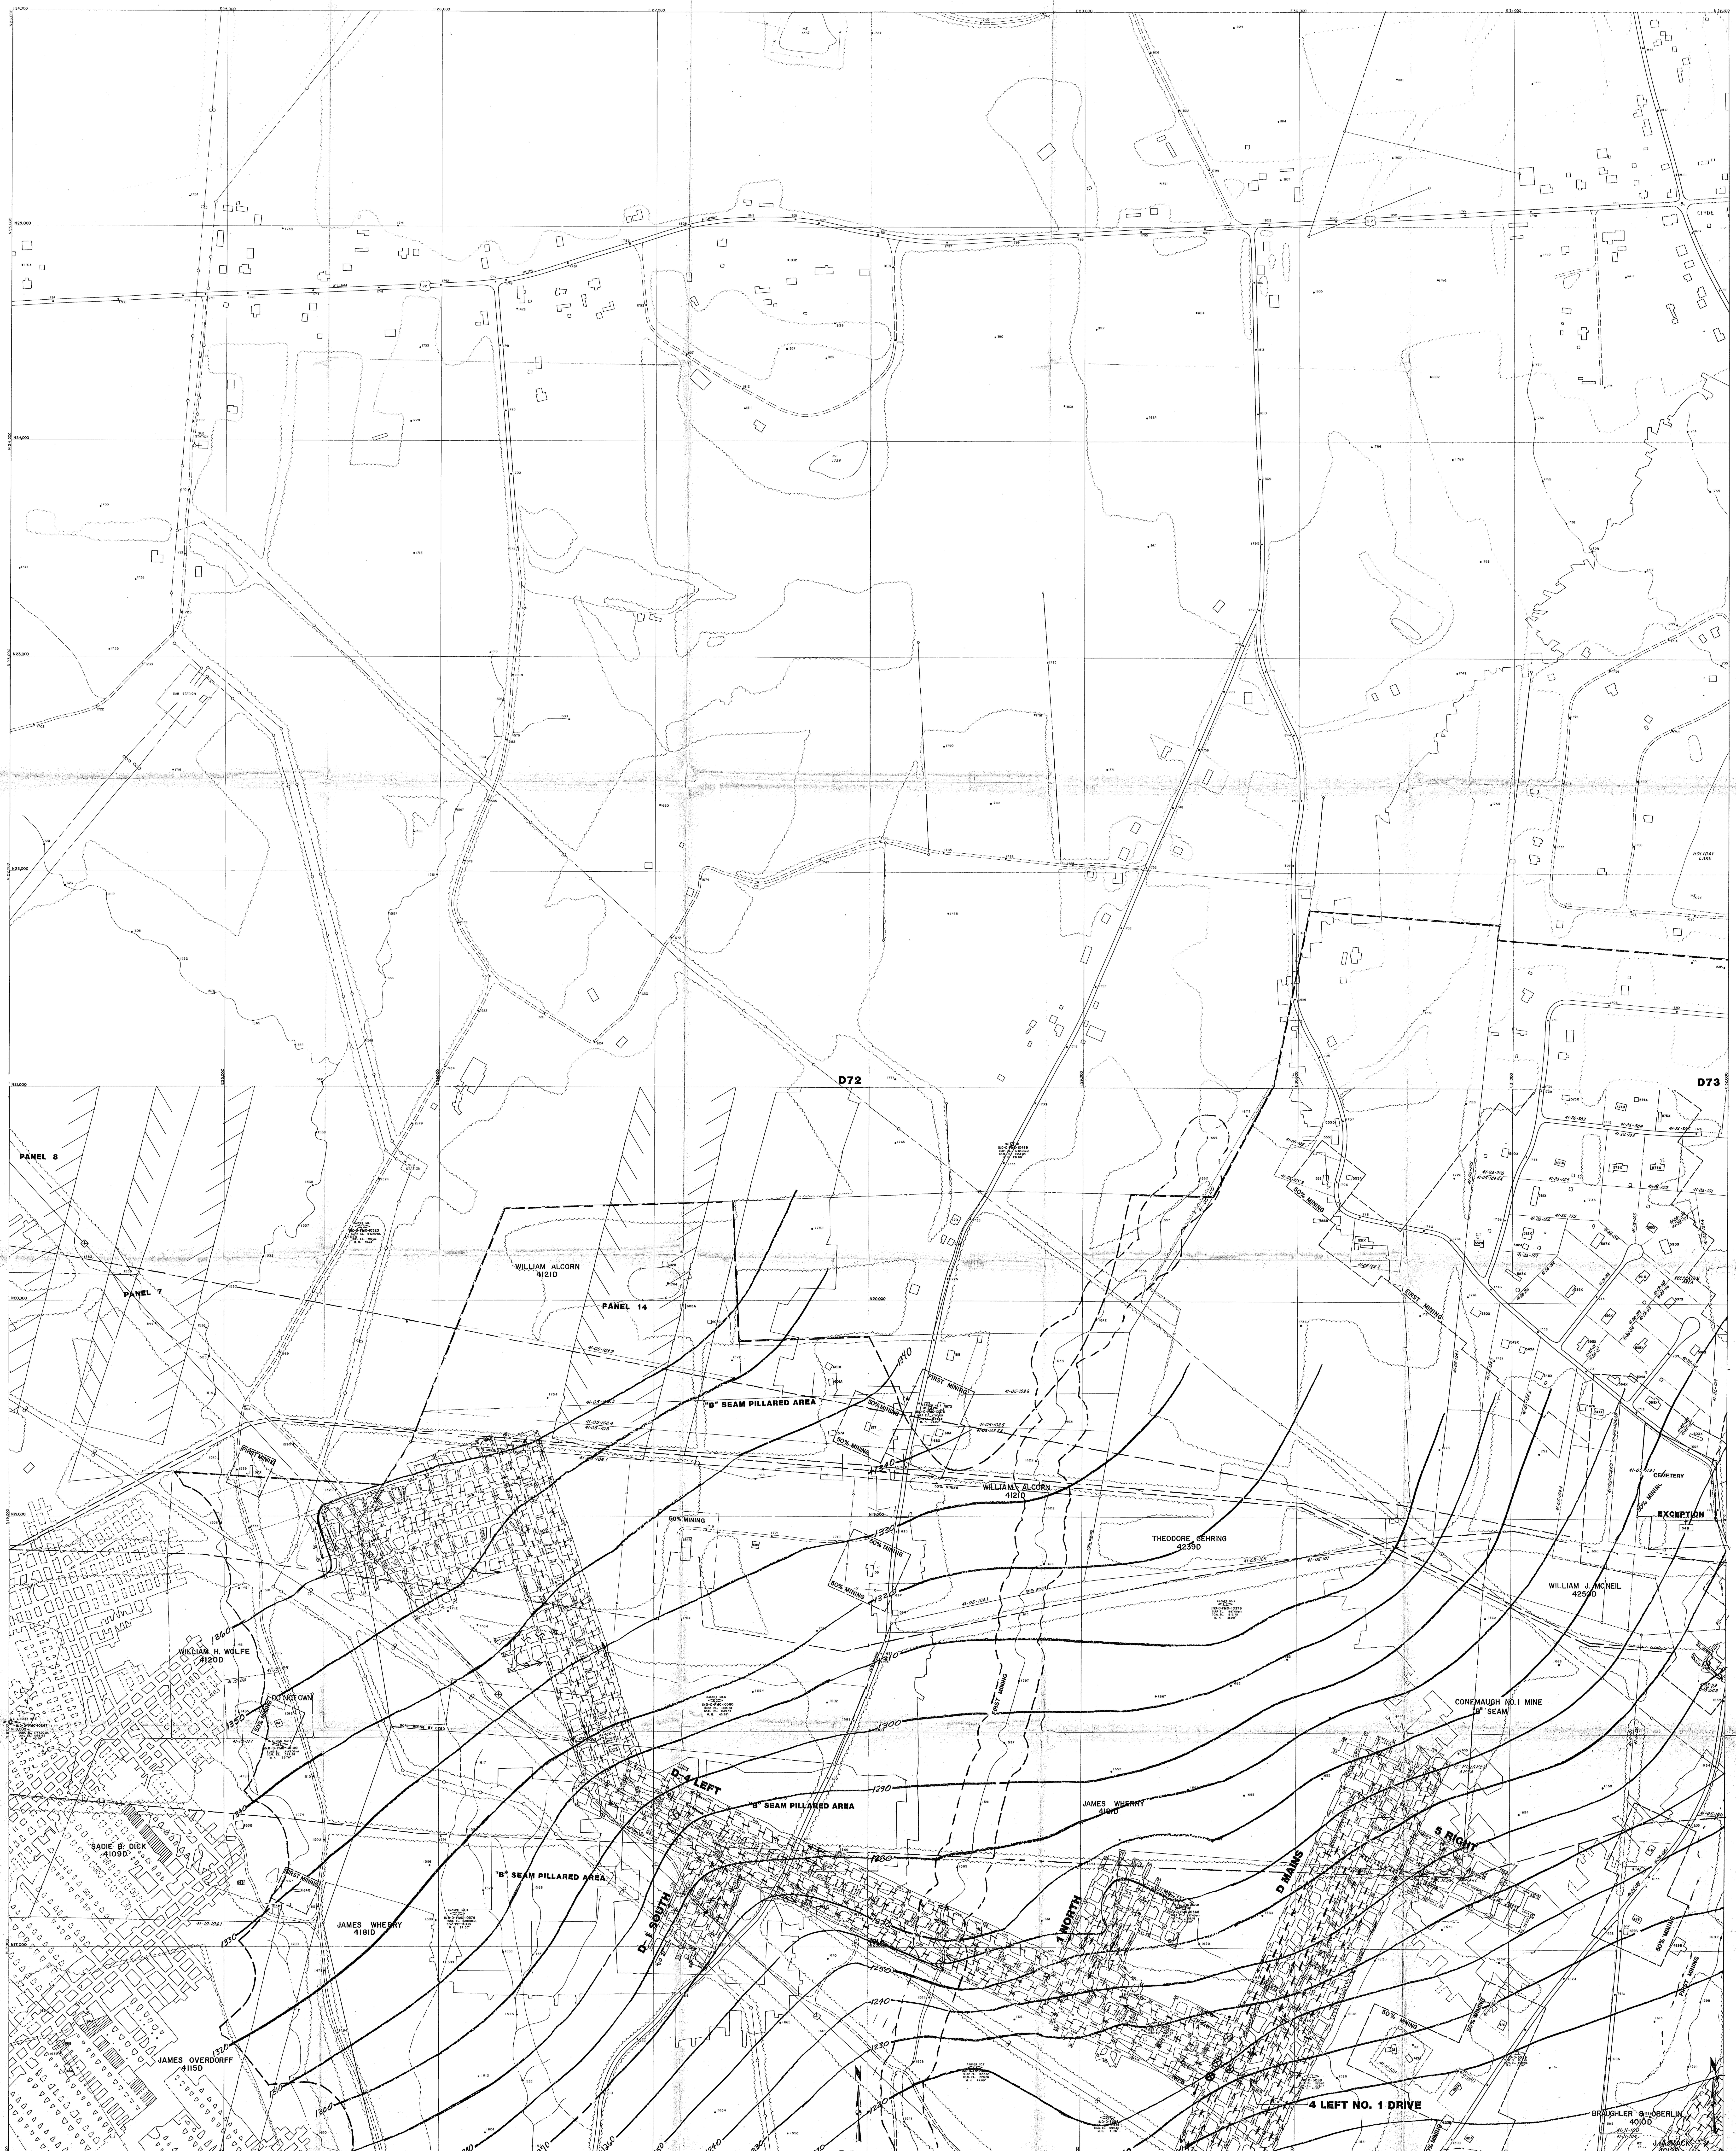
E 24,000
E 25,000
E 26,000
E 27,000
E 29,000
E 30,000
E 31,000
N 26,000
N 25,000
N 24,000
N 23,000
N 22,000
N 21,000
N 20,000
N 19,000
N 18,000
N 17,000
N 16,000
WILLIAM PENN HIGHWAY
22
CLYDE
SUB STATION
WE 1719
WE 1738
HOLIDAY LAKE
D72
D73
D92
D93
PANEL 8
PANEL 7
PANEL 14
WILLIAM ALCORN 4121D
"B" SEAM PILLARED AREA
FIRST MINING
50% MINING
50% MINING BY DEED
DO NOT OWN
WILLIAM H. WOLFE 4120D
SADIE B. DICK 4109D
JAMES WHERRY 4181D
JAMES OVERDORFF 4115D
THEODORE GEHRING 4239D
WILLIAM J. MCNEIL 4250D
CEMETERY
EXCEPTION
RECREATION AREA
CONEMAUGH NO.1 MINE "B" SEAM
D-4 LEFT
D-1 SOUTH
1 NORTH
D MAINS
5 RIGHT
4 LEFT NO. 1 DRIVE
BRAUGHLER & OBERLIN 4010D
J. A. MACK 4012D
1360
1350
1340
1330
1320
1310
1300
1290
1280
1270
1260
1250
1240
1230
1220
1210
1200
1190

FINAL MINE MAP

POSTED
7/31/92

CLOSURE MAP

FINAL MINE MAP

THE FLORENCE MINING COMPANY
FLORENCE NO. 2 MINE
LOWER FREEPORT "D" SEAM
WEST WHEATFIELD TOWNSHIP
INDIANA COUNTY
PERMIT NO. 32831308
SCALE:1"= 200'