


CopySystems Demo - Evaluation Version

MINE MAP
KENNEDY COAL COMPANY
MINE N° 4 PORTAL N° 2
NORTHWEST OF HAMILTON
PORTER TWP & PERRY TWP
JEFFERSON CO. PENNSYLVANIA
SCALE 1"=100' MARCH 1, 1974

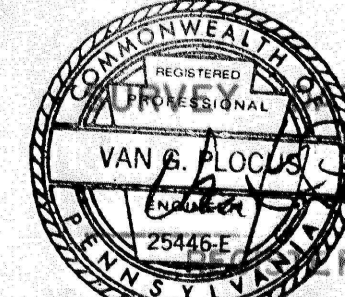

FINAL CLOSURE MAP

CATHERINE GRANDY
(SURFACE)
KENNEDY COAL COMPANY

CopySystems Demo - Evaluation Version

CopySystems Demo - Evaluation Version

CopySystems Demo - Evaluation Version

CopySystems Demo - Evaluation Version

CopySystems Demo - Evaluation Version

CopySystems Demo - Evaluation Version

CopySystems Demo - Evaluation Version

L. W. DINGER
(SURFACE)
KENNEDY COAL COMPANY

ALVIN KENNEDY HEIRS
(FEE)

- LEGEND
- INTAKE AIR
 - RETURN AIR
 - INTAKE ESCAPEWAY
 - ALTERNATE ESCAPEWAY
 - BELT AIRFLOW
 - BELT HAULAGE
 - LINE CURTAIN
 - CHECK CURTAIN
 - REGULATOR
 - PERMANENT STOPPING
 - TEMPORARY STOPPING
 - PERMANENT STOPPING WITH MAN DOOR
 - BELT AIR LOCK +
 - ACTIVE ROOM PANELS
 - WILCOX CONTINUOUS MINER
 - PROPOSED SEALS
 - BLEEDER EVALUATION POINTS
 - PROJECTED MINING
 - GAS WELL

CopySystems Demo - Evaluation Version

NOTE:
Coal elevations prior to 7-1-89
are 57 feet higher than USGS datum.
Coal Structure lines have been
adjusted accordingly. Entry Elevations
have not been adjusted

KENNEDY COAL COMPANY
MINE N° 4 PORTAL N° 2
LOWER FREEPORT COAL SEAM

OFFICE
BATH HOUSE
GARAGE
REPAIR SHOP
STORAGE BUILDING

CopySystems Demo - Evaluation Version

CopySystems Demo - Evaluation Version

CopySystems Demo - Evaluation Version

CopySystems Demo - Evaluation Version

CopySystems Demo - Evaluation Version

CopySystems Demo - Evaluation Version

SHEET N° 2

TO NOV 7, 1992

N-5000