


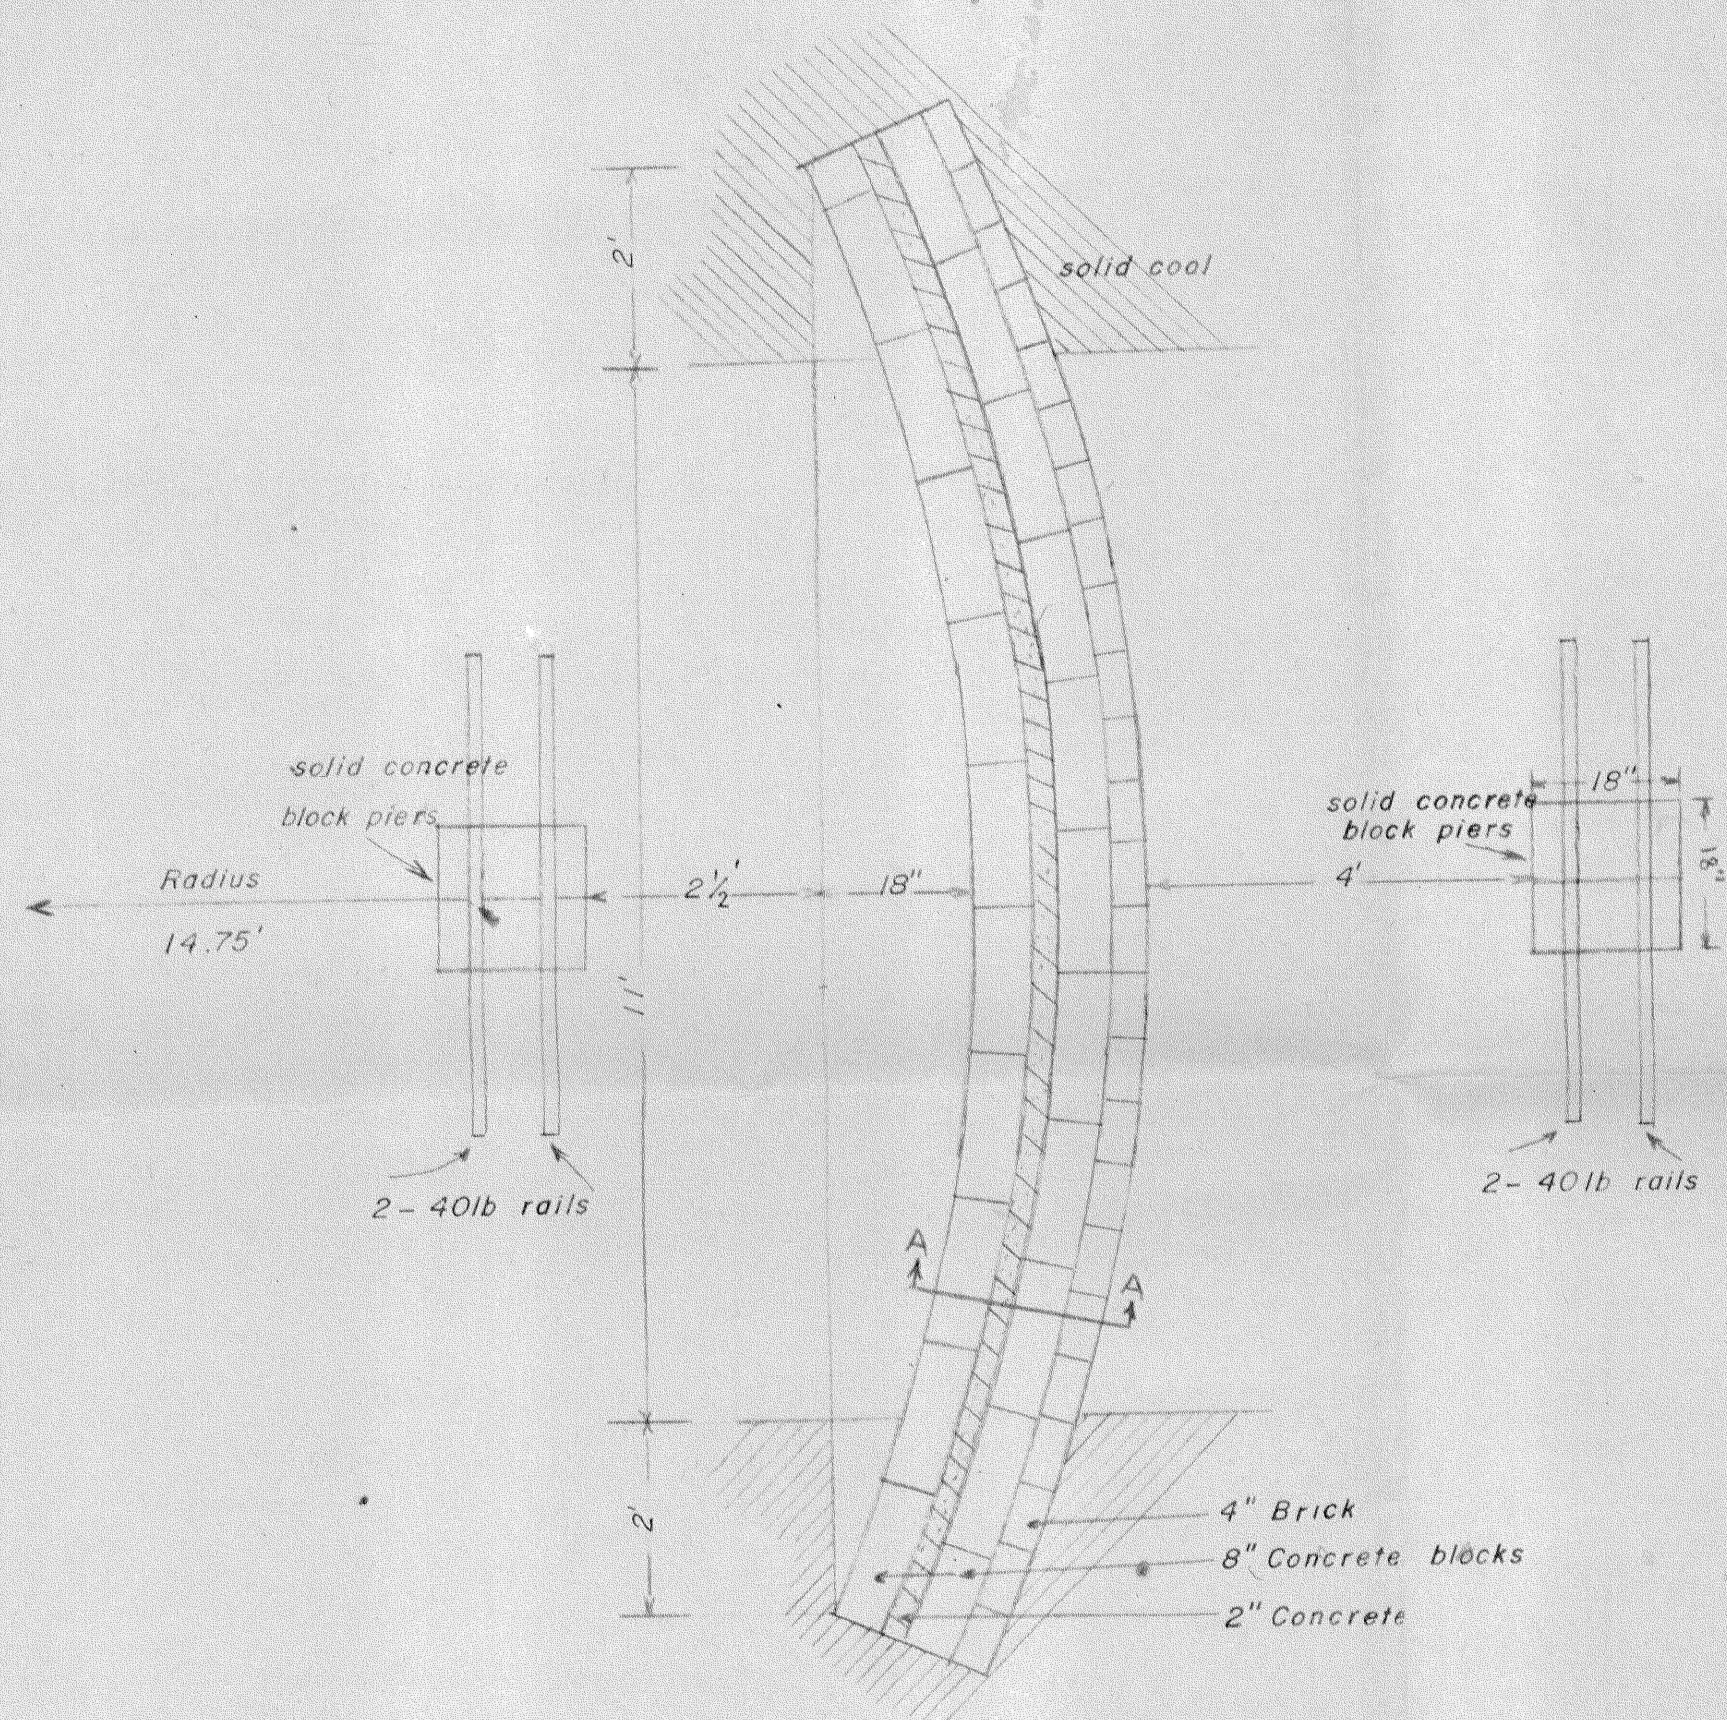

MONTOUR 4 SCALE 1"=2' NOVEMBER 1952



PITTSBURGH COAL COMPANY
Division of Pittsburgh Consolidation Coal Co.

CROSS SECTION OF 14 BULKHEADS

FOR LOCATIONS SEE ATTACHED PLAN

Supervisor of construction

Halter Jack
John Furlong
Frank Campbell

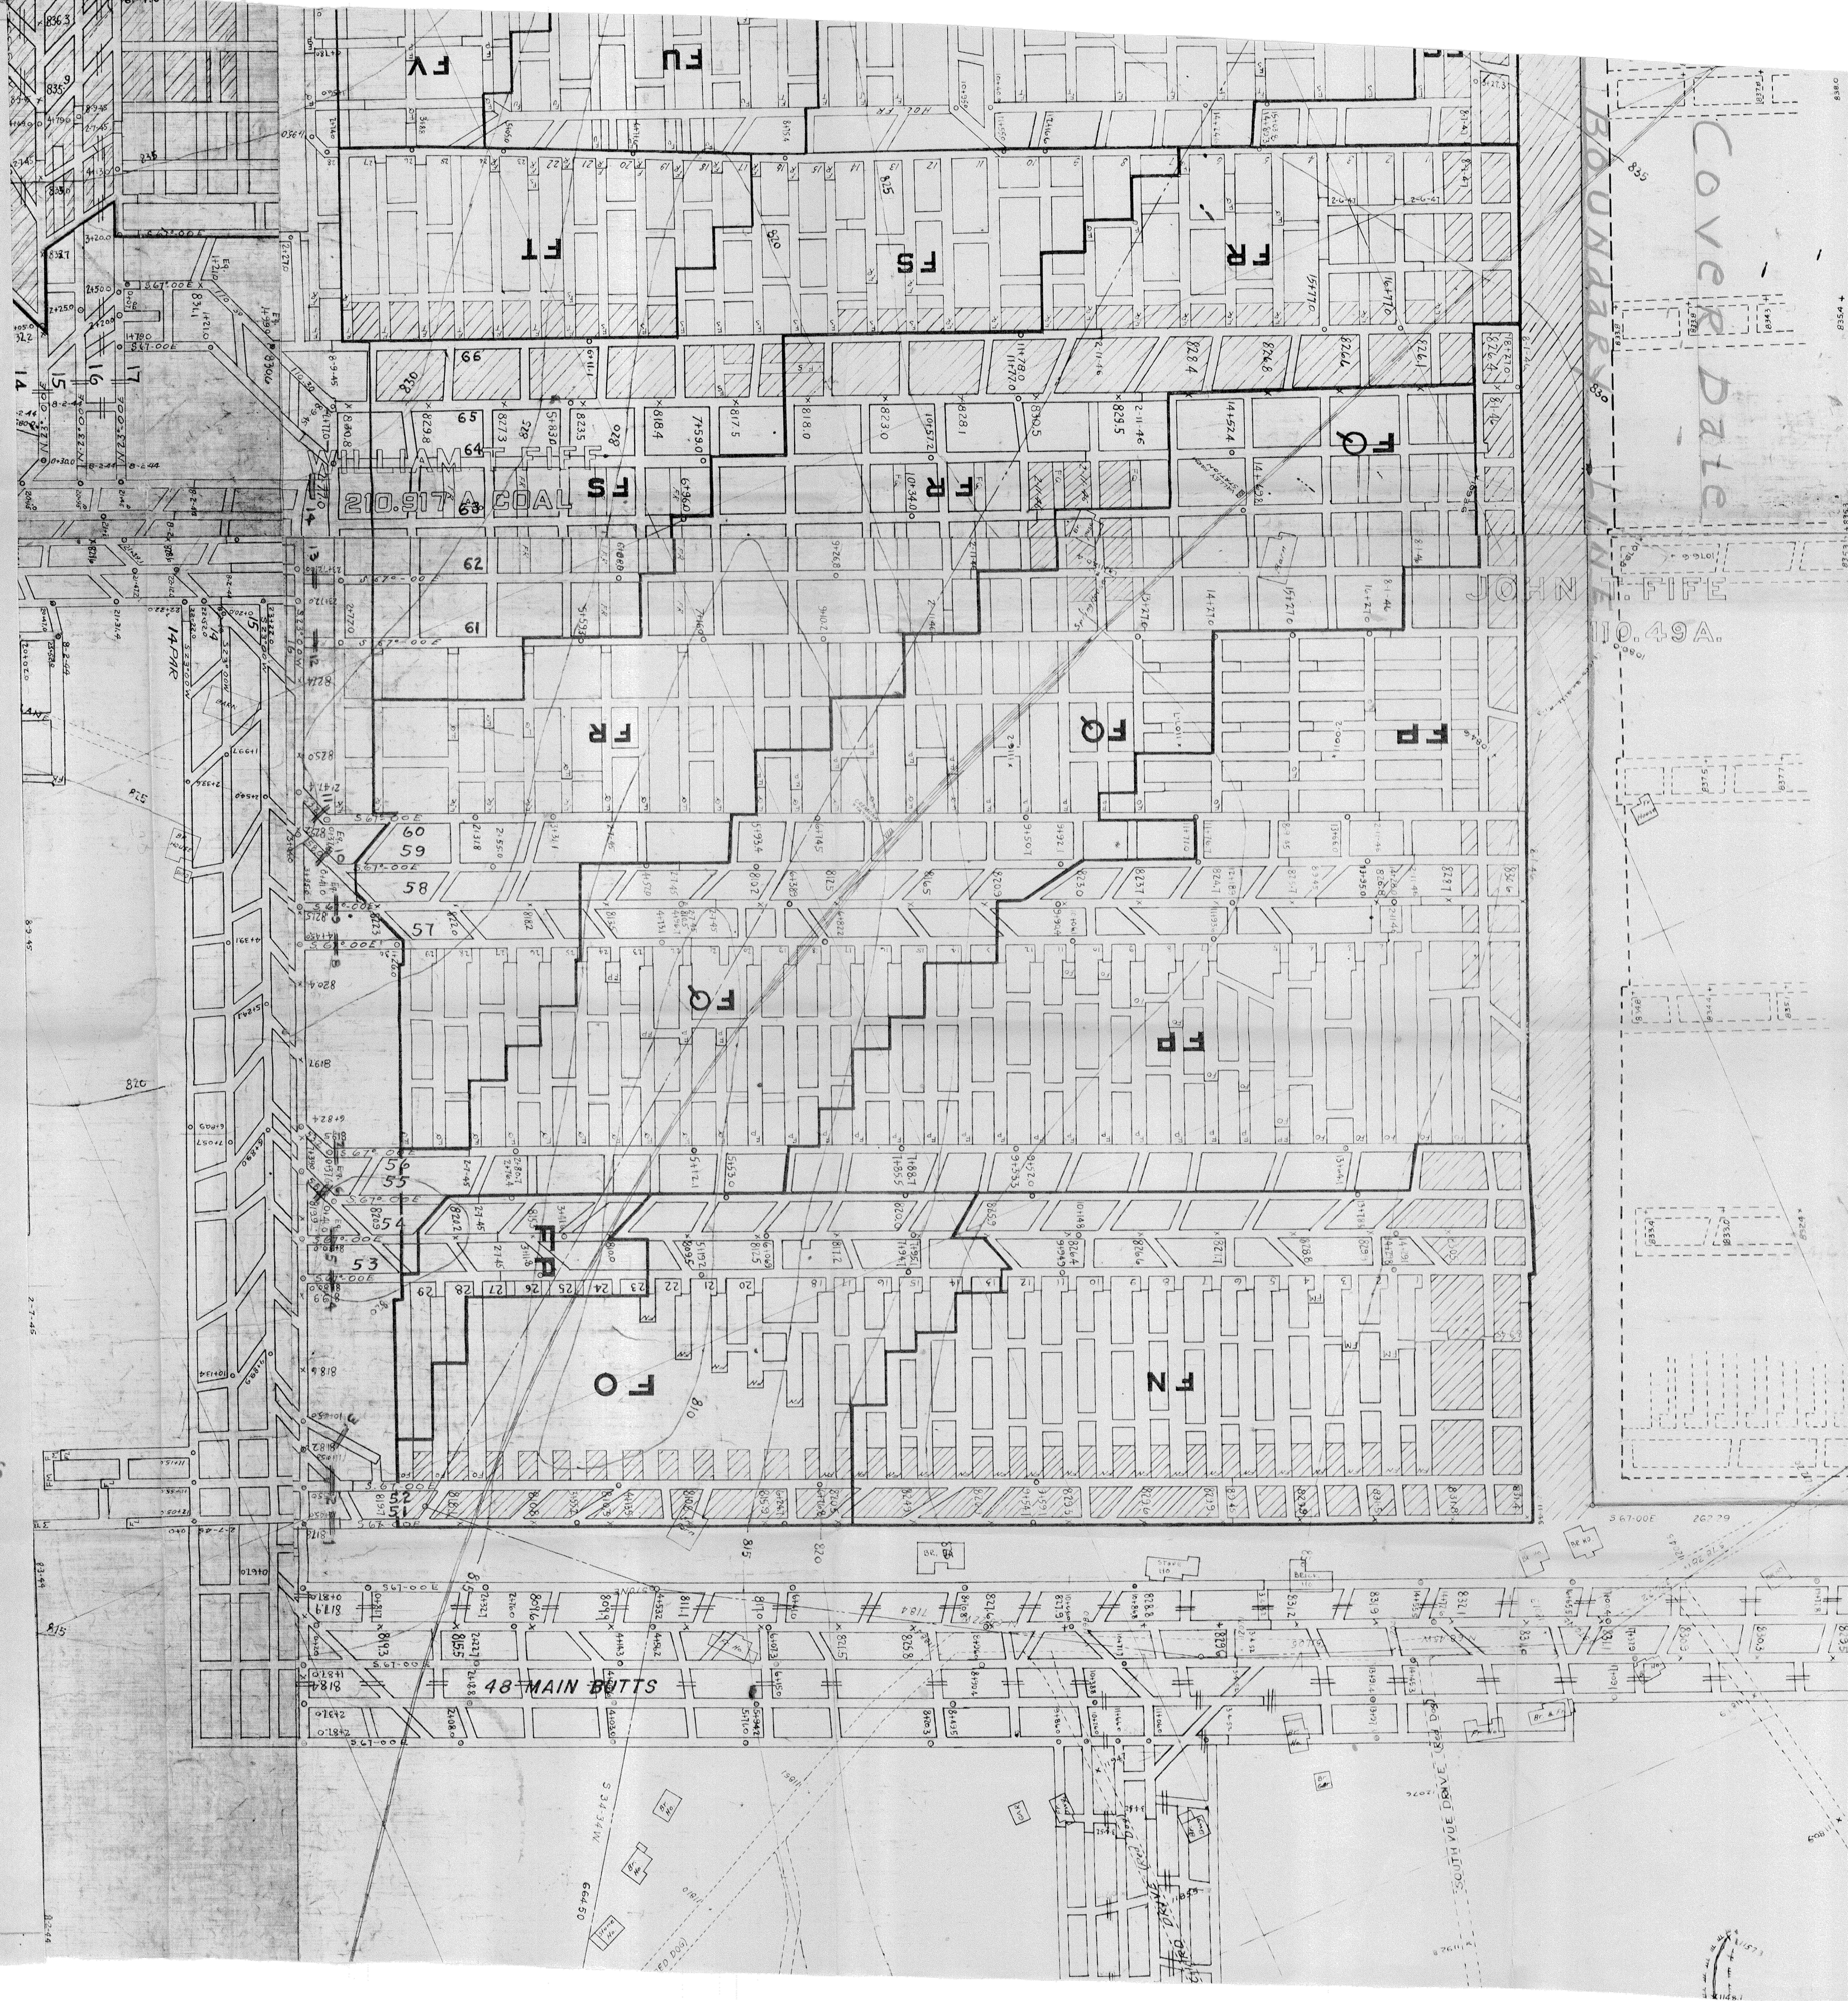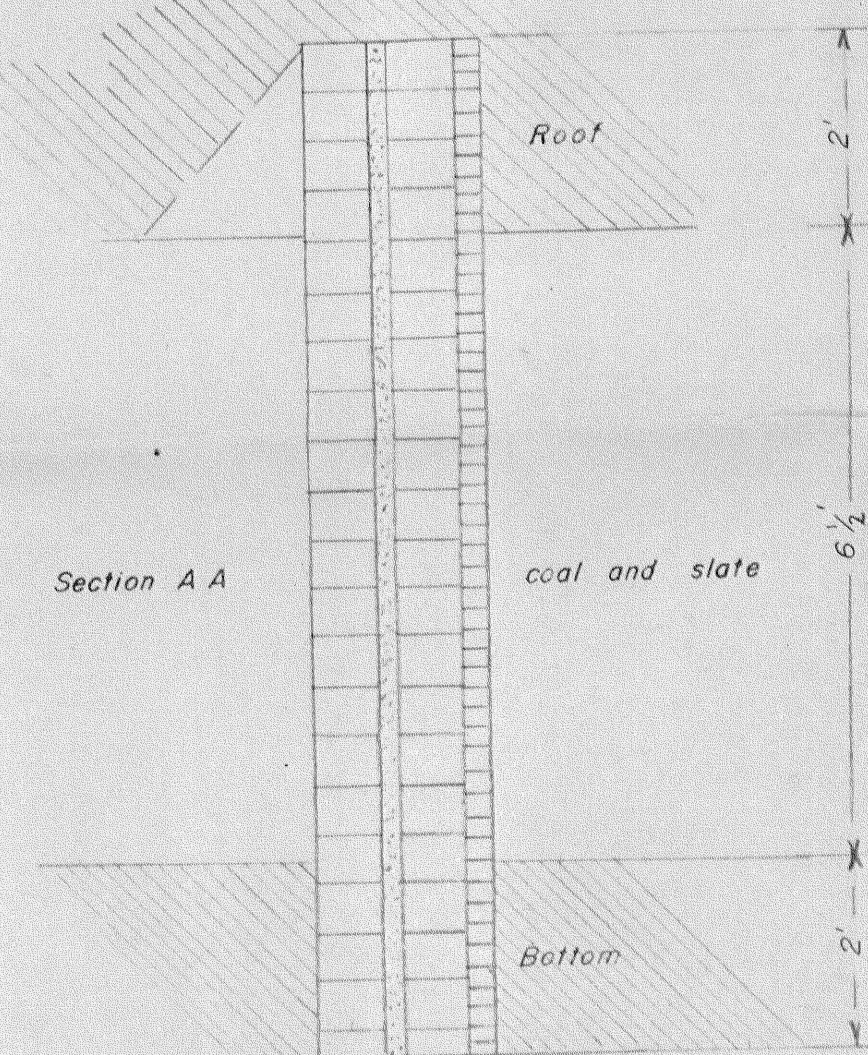

Cover Date
10.49A