


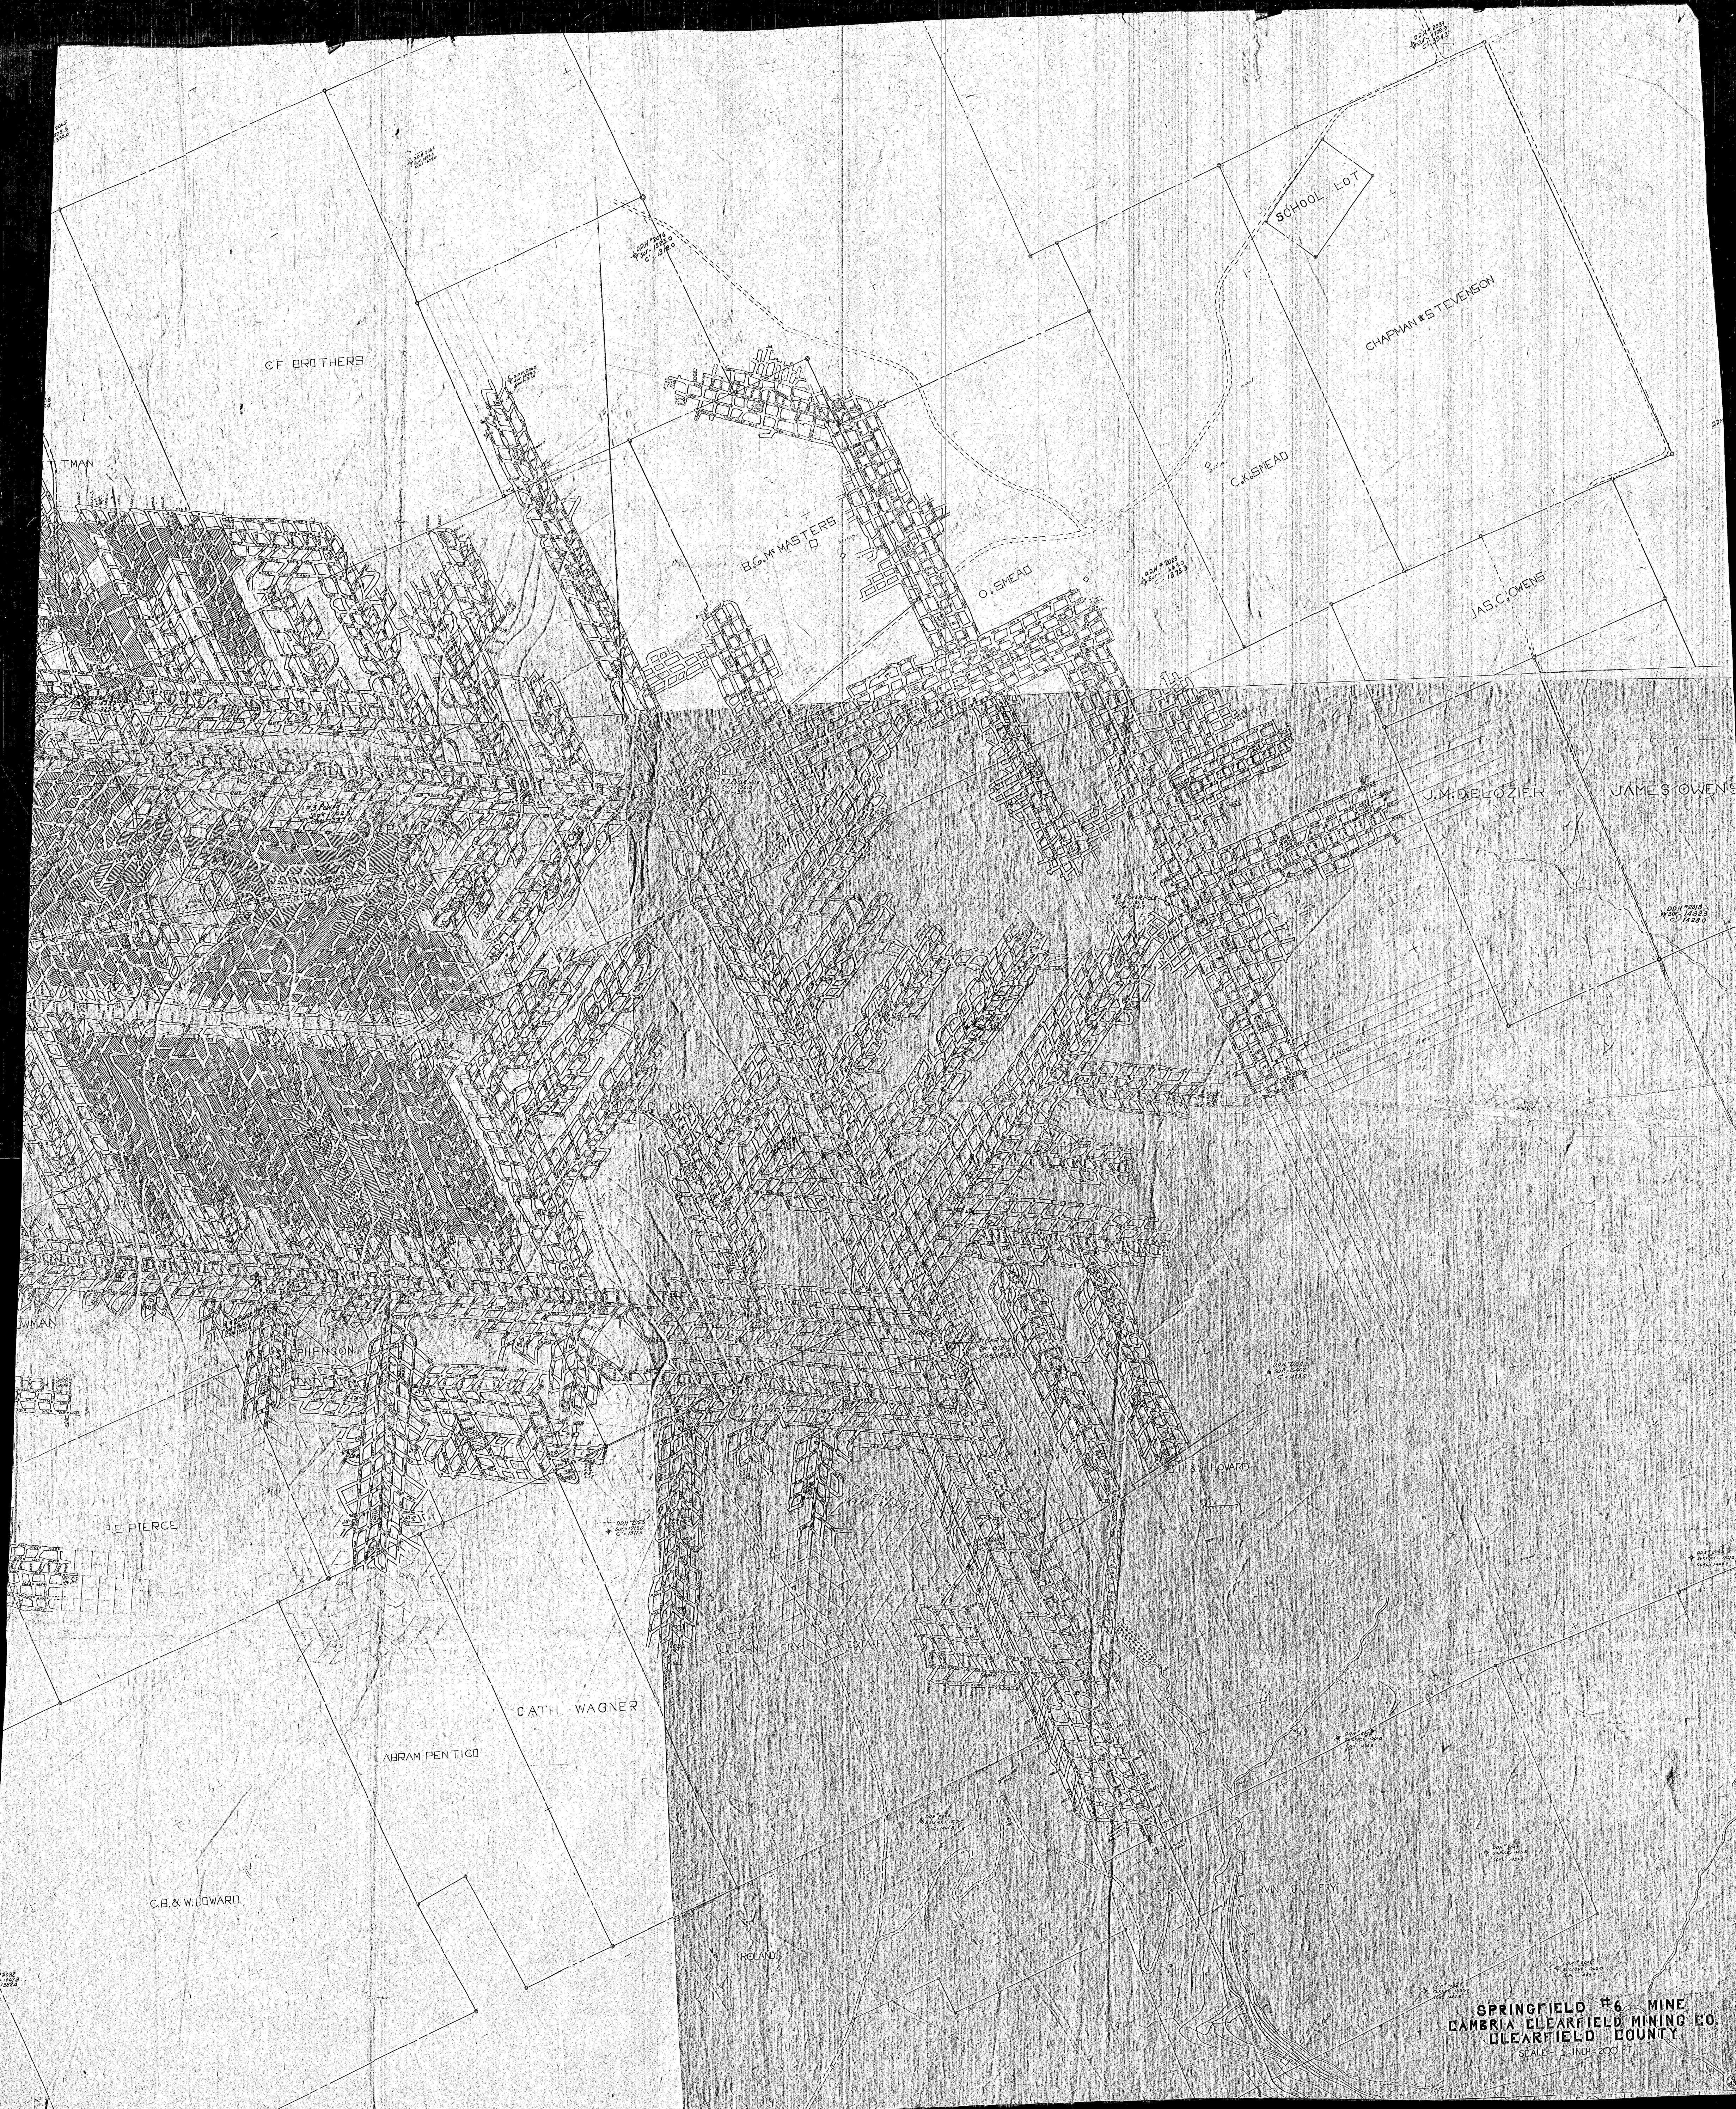

C.F. BROTHERS

SCHOOL LOT

CHAPMAN & STEVENSON

B.G. MASTERS

O. SNEAD

C. SNEAD

JAS. C. OWENS

J.M. DELOZIER

JAMES OWENS

P.E. PIERCE

STEPHENSON

CATH. WAGNER

ABRAM PENTICO

C.B. & W. HOWARD

IRVING & CO.

SPRINGFIELD #6 MINE
CAMBRIA CLEARFIELD MINING CO.
CLEARFIELD COUNTY
SCALE - 1" = 200 FT.