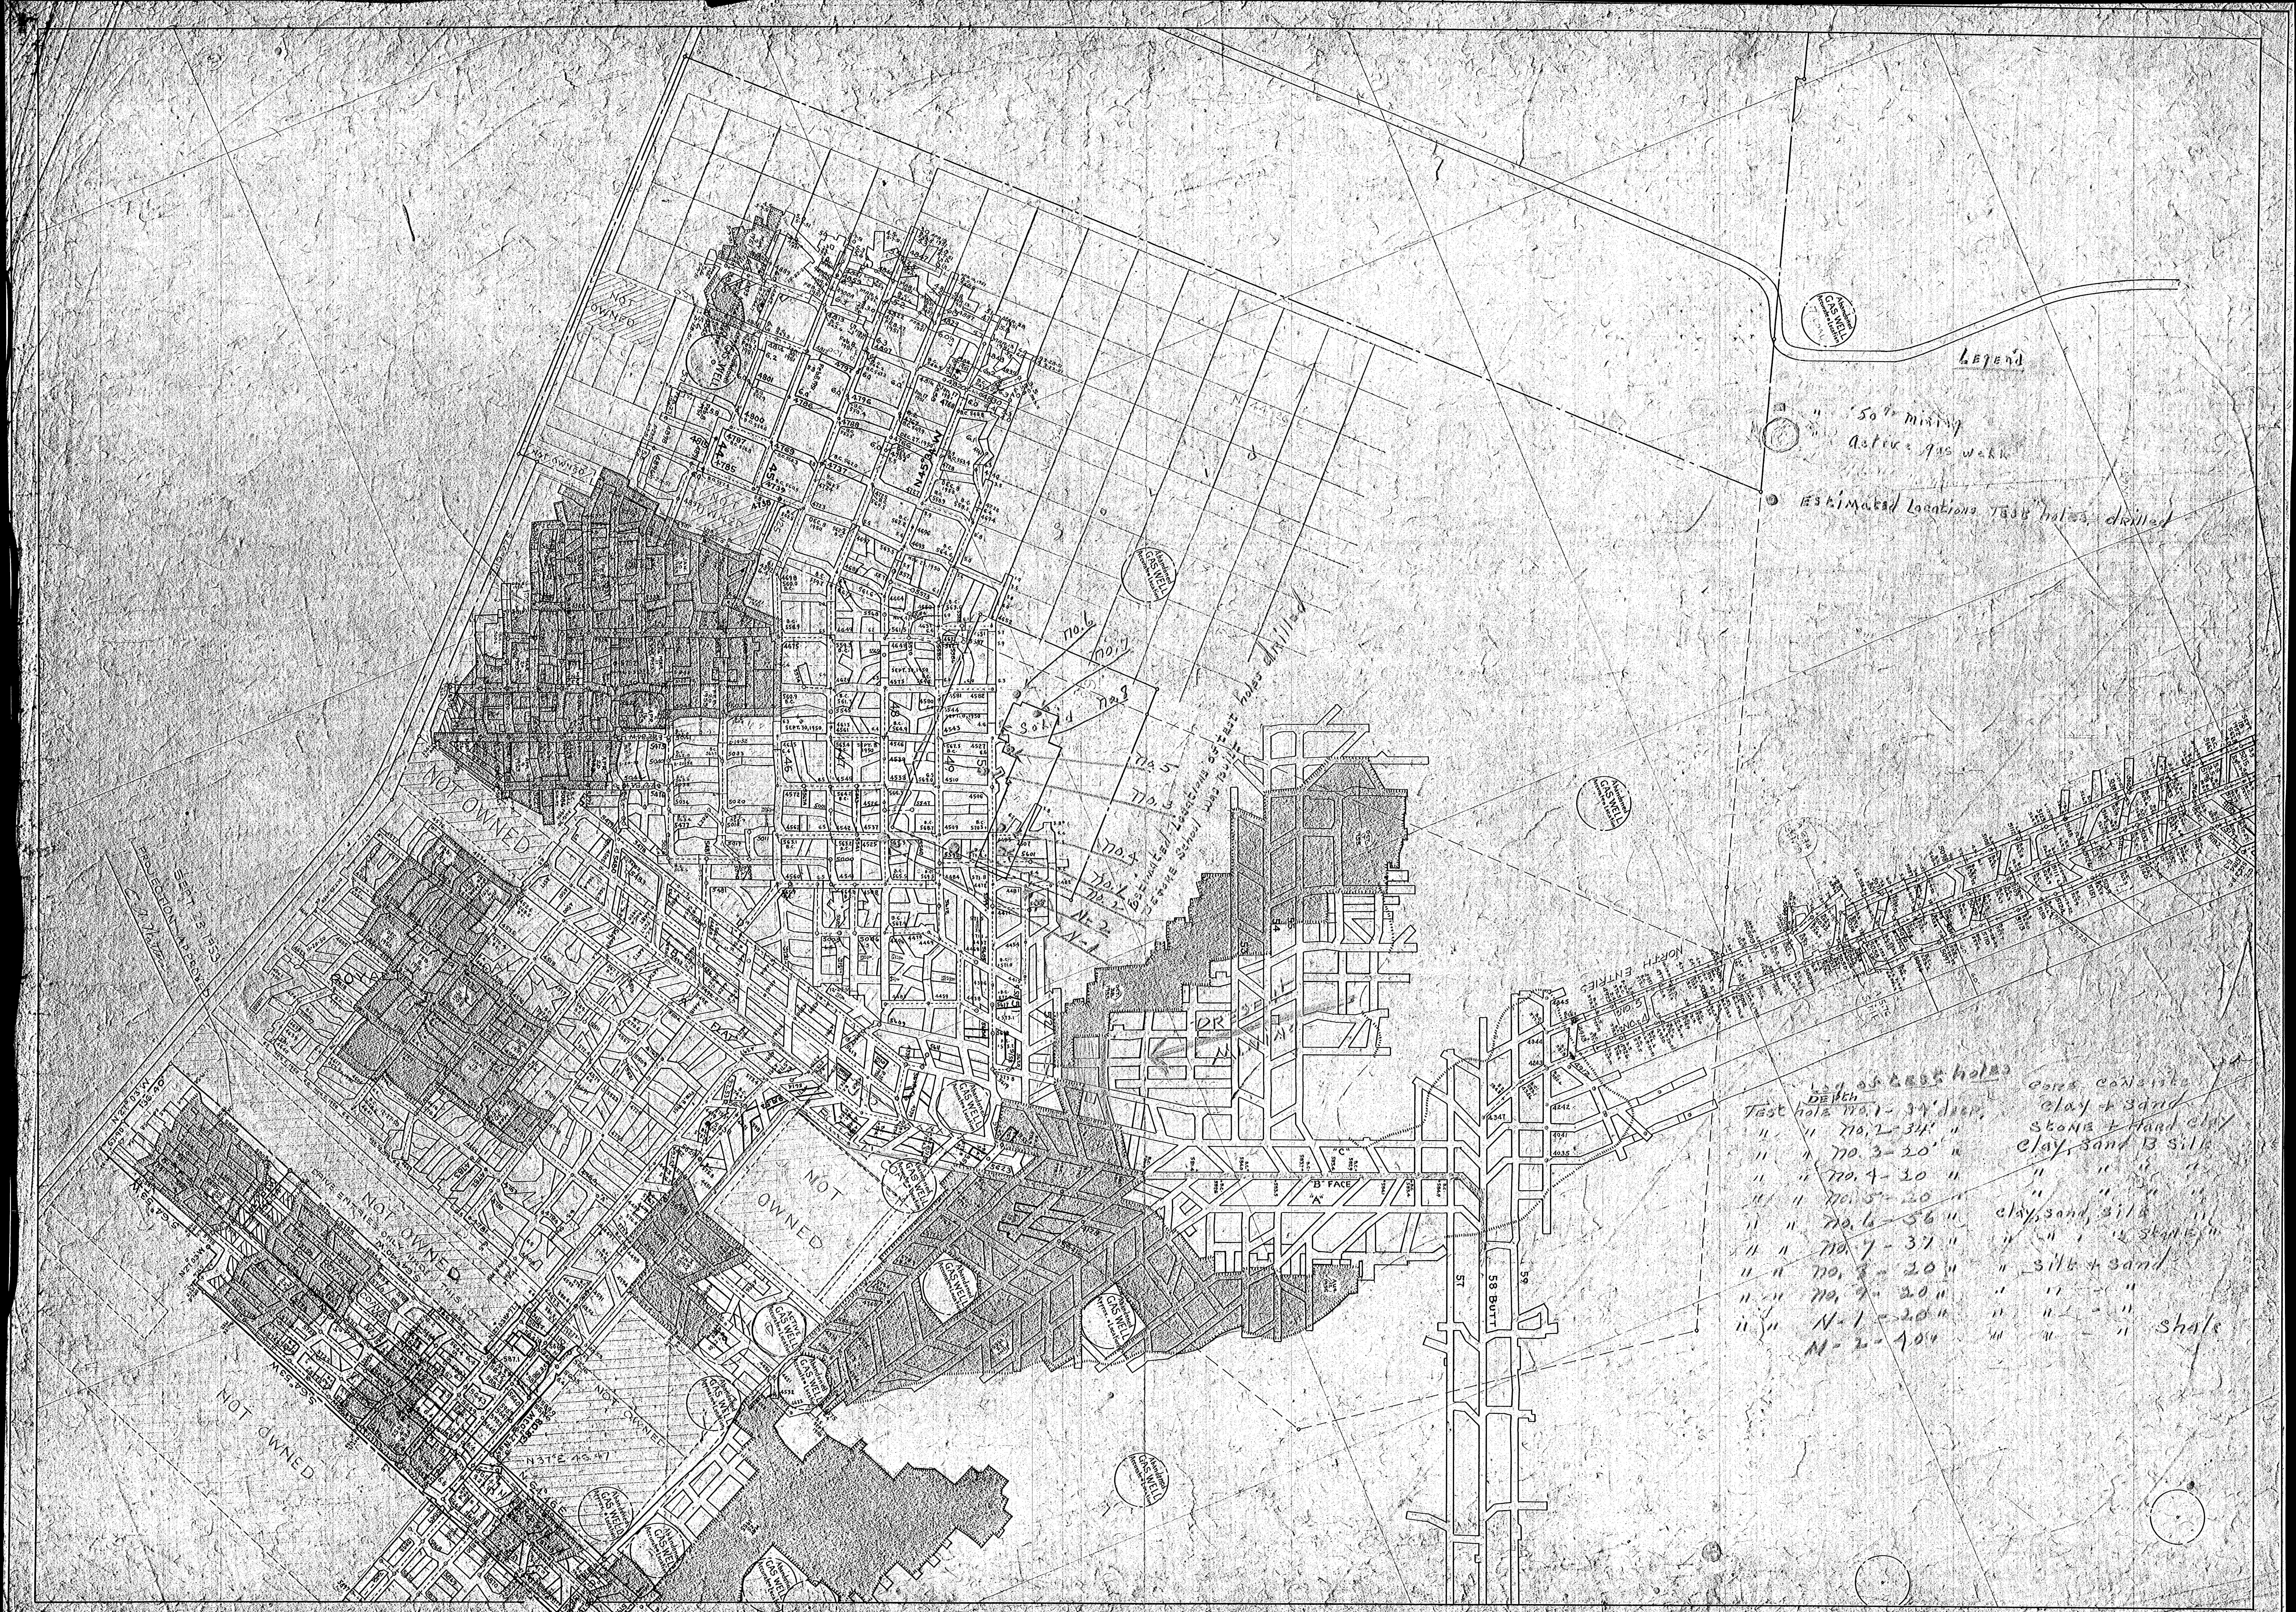

Legend

" 50' mining
Active gas well

Estimated Locations Test holes drilled

Log of test holes

	Depth	Core consist
Test hole	No. 1 - 34' deep	clay + sand
" "	No. 2 - 34' "	Stone + Hard clay
" "	No. 3 - 20' "	clay, sand B silt
" "	No. 4 - 20 "	" " " "
" "	No. 5 - 20 "	" " " "
" "	No. 6 - 56 "	clay, sand, silt "
" "	No. 7 - 37 "	" " " " Stone "
" "	No. 8 - 20 "	" silt + sand
" "	No. 9 - 20 "	" " " "
" "	N-1 - 20 "	" " " "
	N-2 - 40'	" " " Shale

HUBBARD MINE GREENSBURG-CONNELLSVILLE C.&C. Co. 1" = 100'