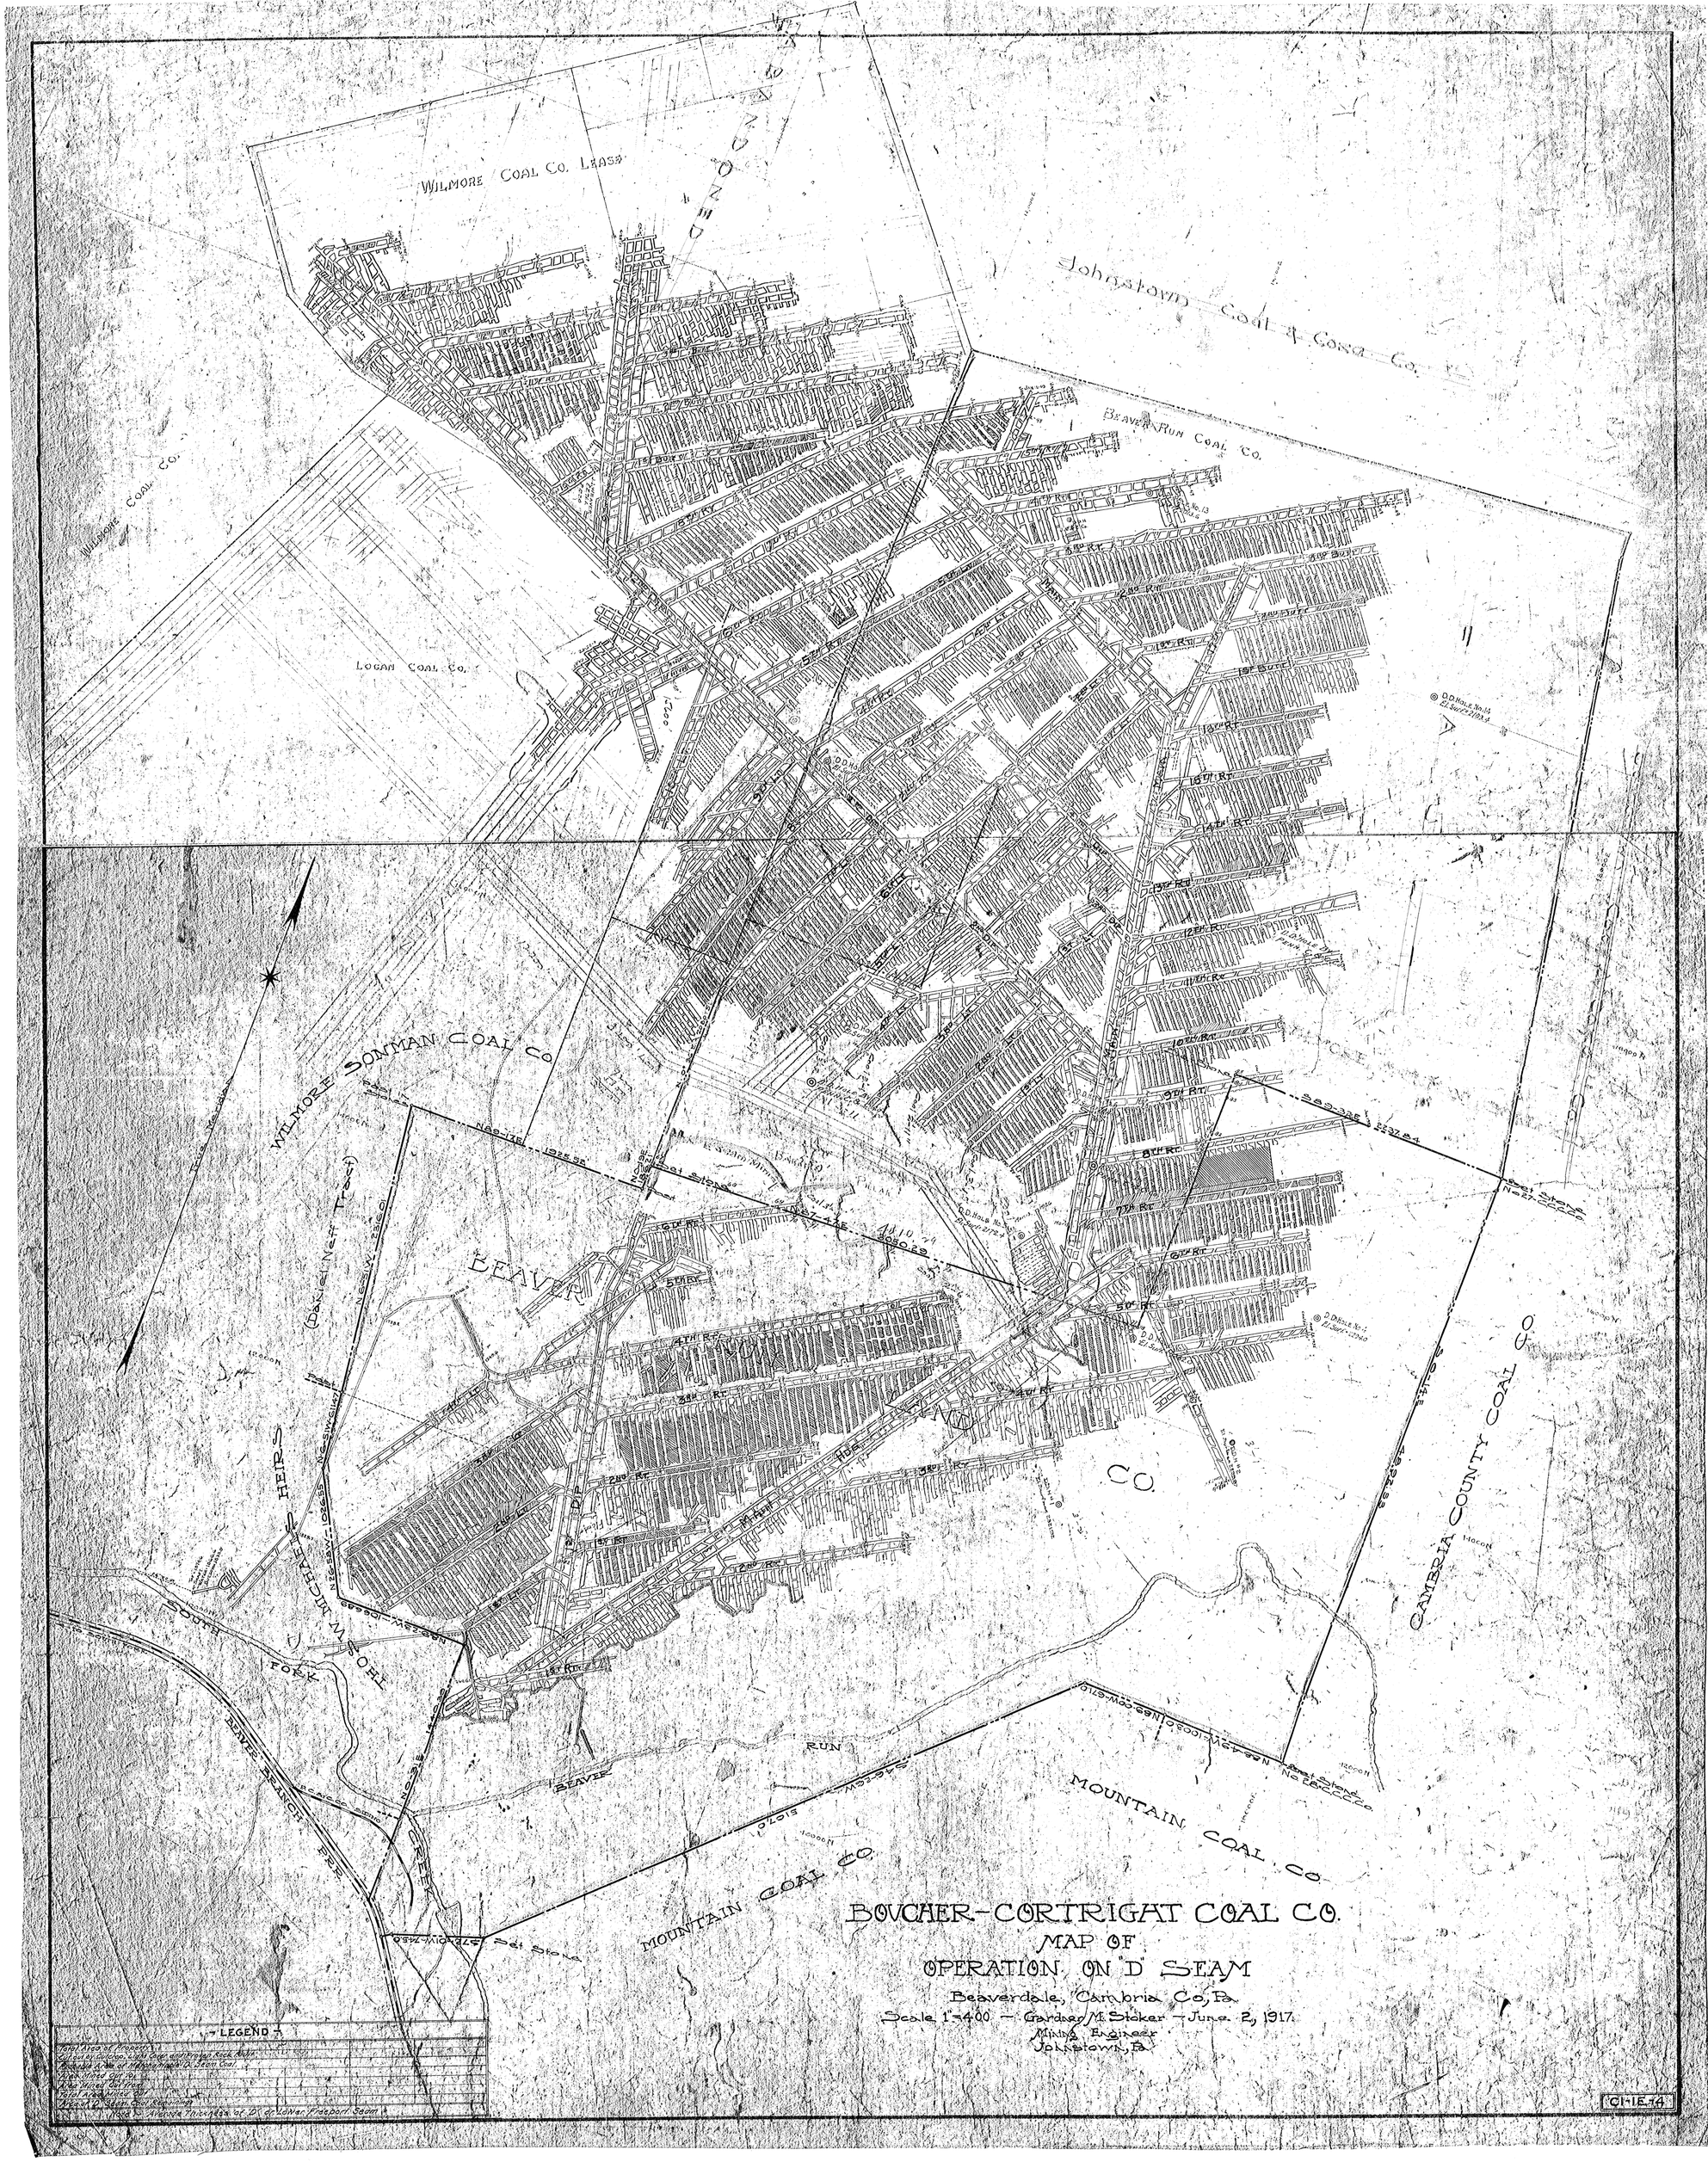
WILMORE COAL CO. LEASE
Johnstown Coal & Coke Co.
BEAVER RUN COAL CO.
LOGAN COAL CO.
WILMORE SONMAN COAL CO.
BEAVER
CO.
CAMBRIA COUNTY COAL CO.
MOUNTAIN COAL CO.
MOUNTAIN COAL CO.
BEAVER RUN
SOUTH FORK
BEAVER BRANCH
LEGEND
BOUCHER-CORTRIGHT COAL CO.
MAP OF
OPERATION ON "D" SEAM
Beaverdale, Cambria Co., Pa.
Scale 1"=400 — Gardner M. Stoker — June 2, 1917.
Mining Engineer
Johnstown, Pa.
C1-1E-4