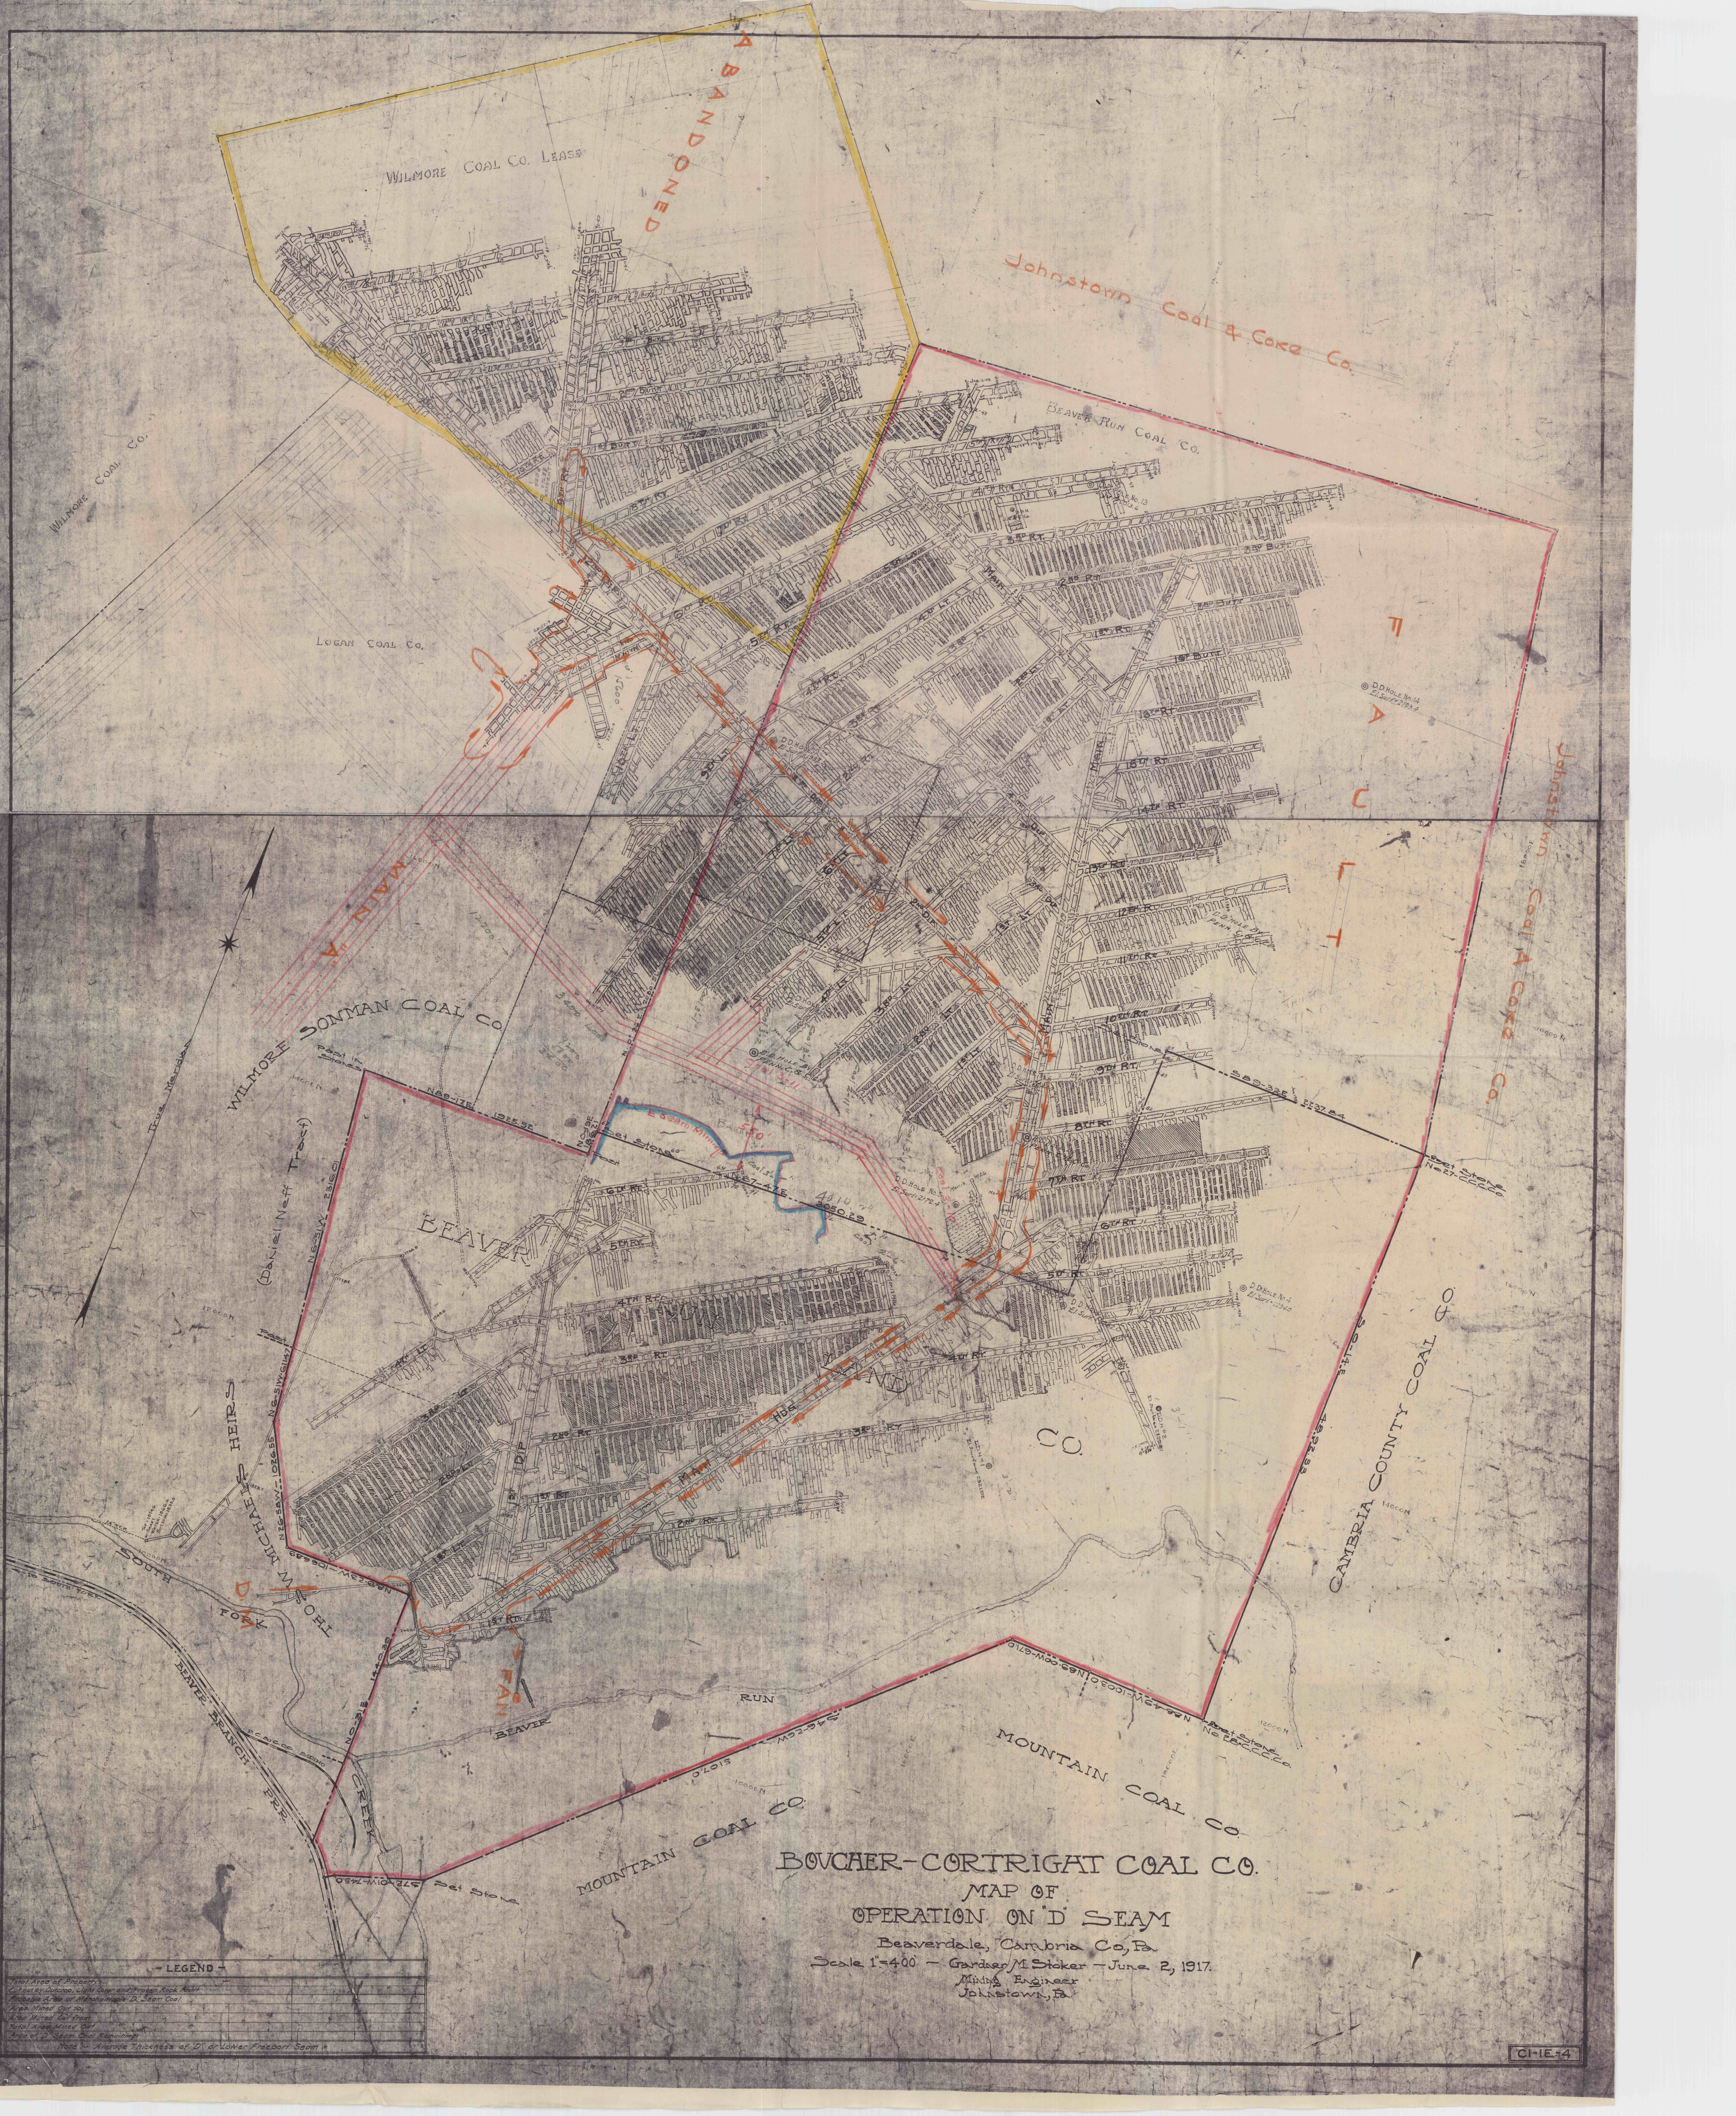

BOUCHER-CORTRIGAT COAL CO.

MAP OF
OPERATION ON "D" SEAM

Beaverdale, Cambria Co., Pa.
Scale 1"=400' – Gardner M. Stoker – June 2, 1917.
Mining Engineer
Johnstown, Pa.

– LEGEND –

Total Area of Property		
Cut out by Outcrop, Light Cover and Proven Rock Fault		
Probable Area of Merchantable "D" Seam Coal		
Area Mined Out to		
Area Mined Out from		
Total Area Mined Out		
Area of "D" Seam Coal Remaining		

Note: – Average Thickness of "D" or Lower Freeport Seam =