


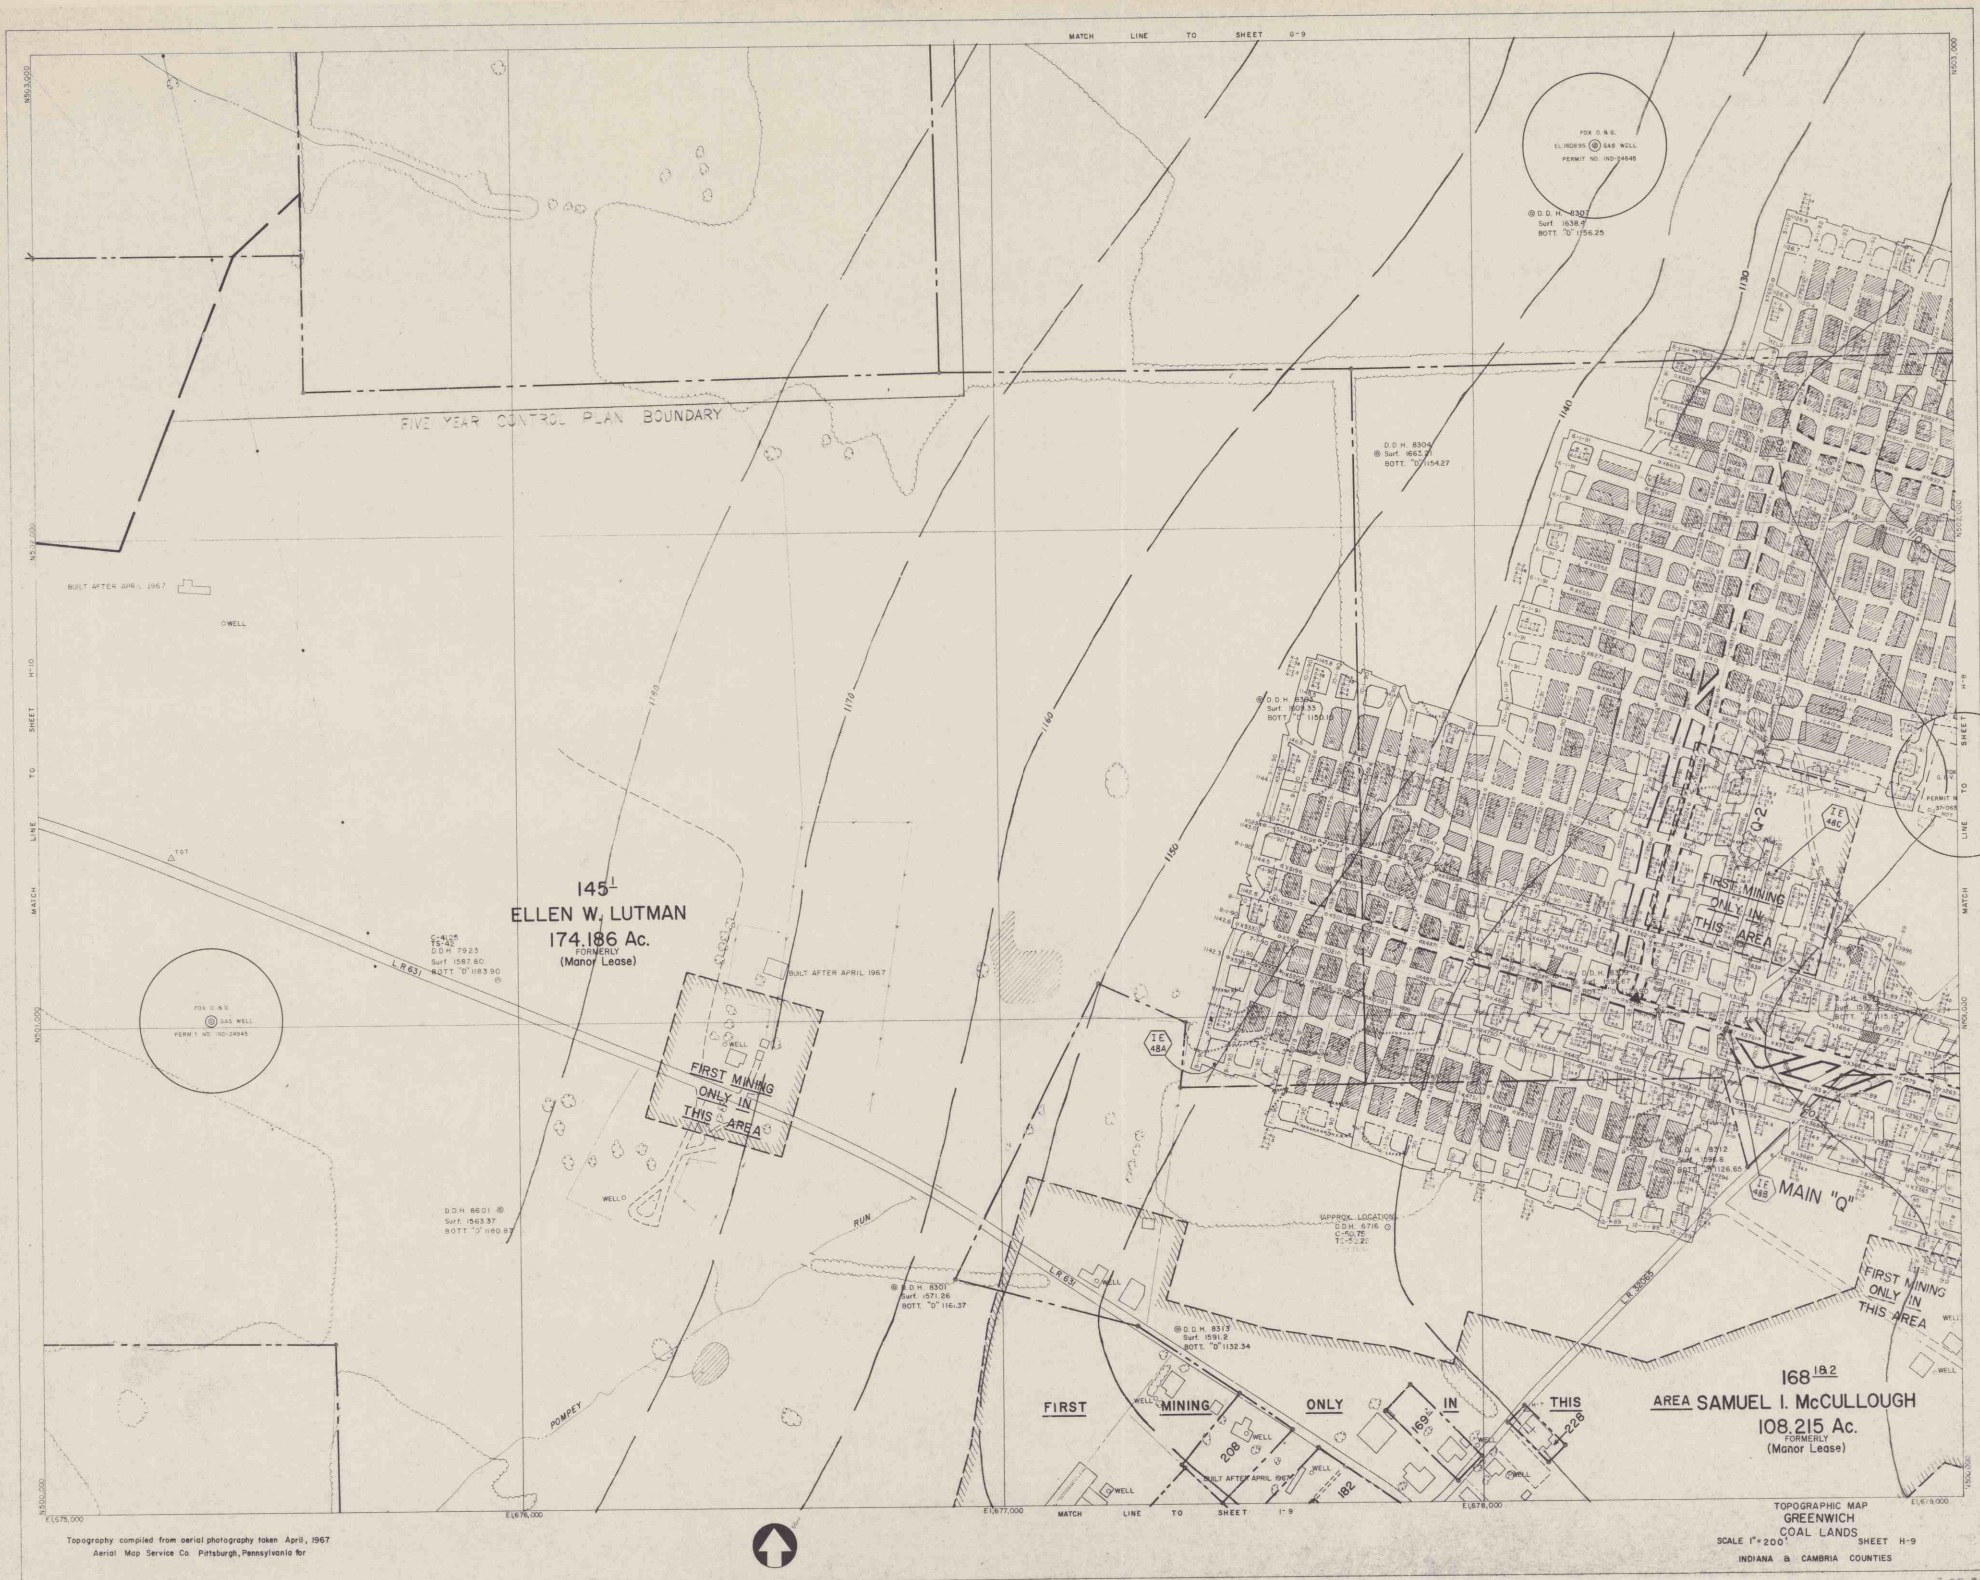

5-28-82