


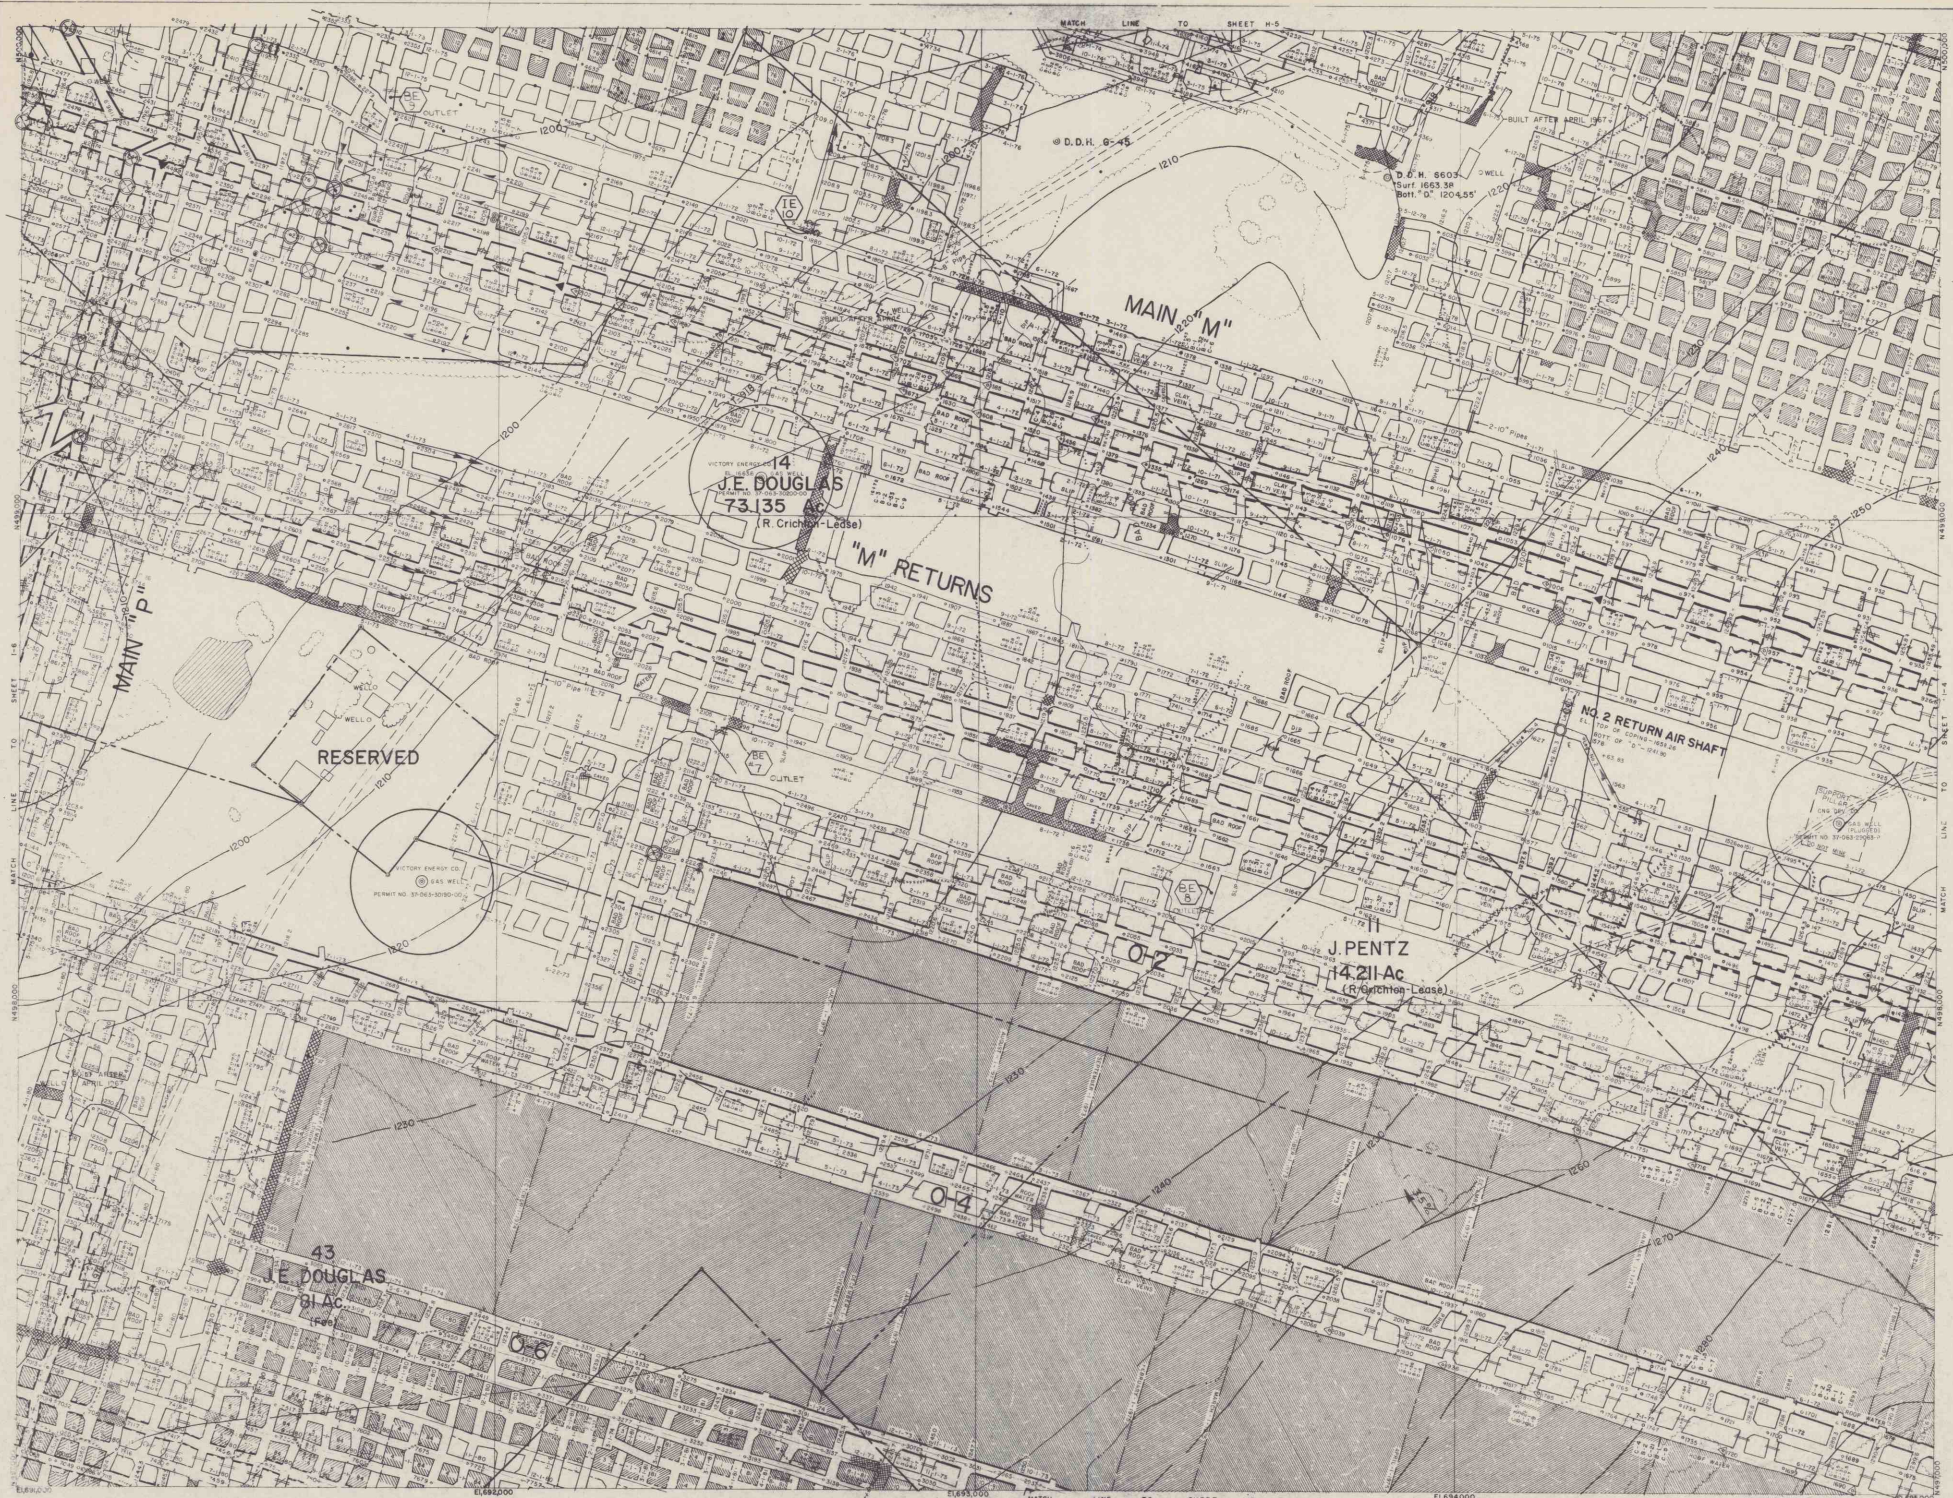

Topography compiled from aerial photography taken April, 1967
Aerial Map Service Co. Pittsburgh, Pennsylvania 151



TOPOGRAPHIC MAP
GREENWICH
COAL LANDS
SCALE 1"=200' SHEET I-5
INDIANA & CAMBRIA COUNTIES

4-28-68