


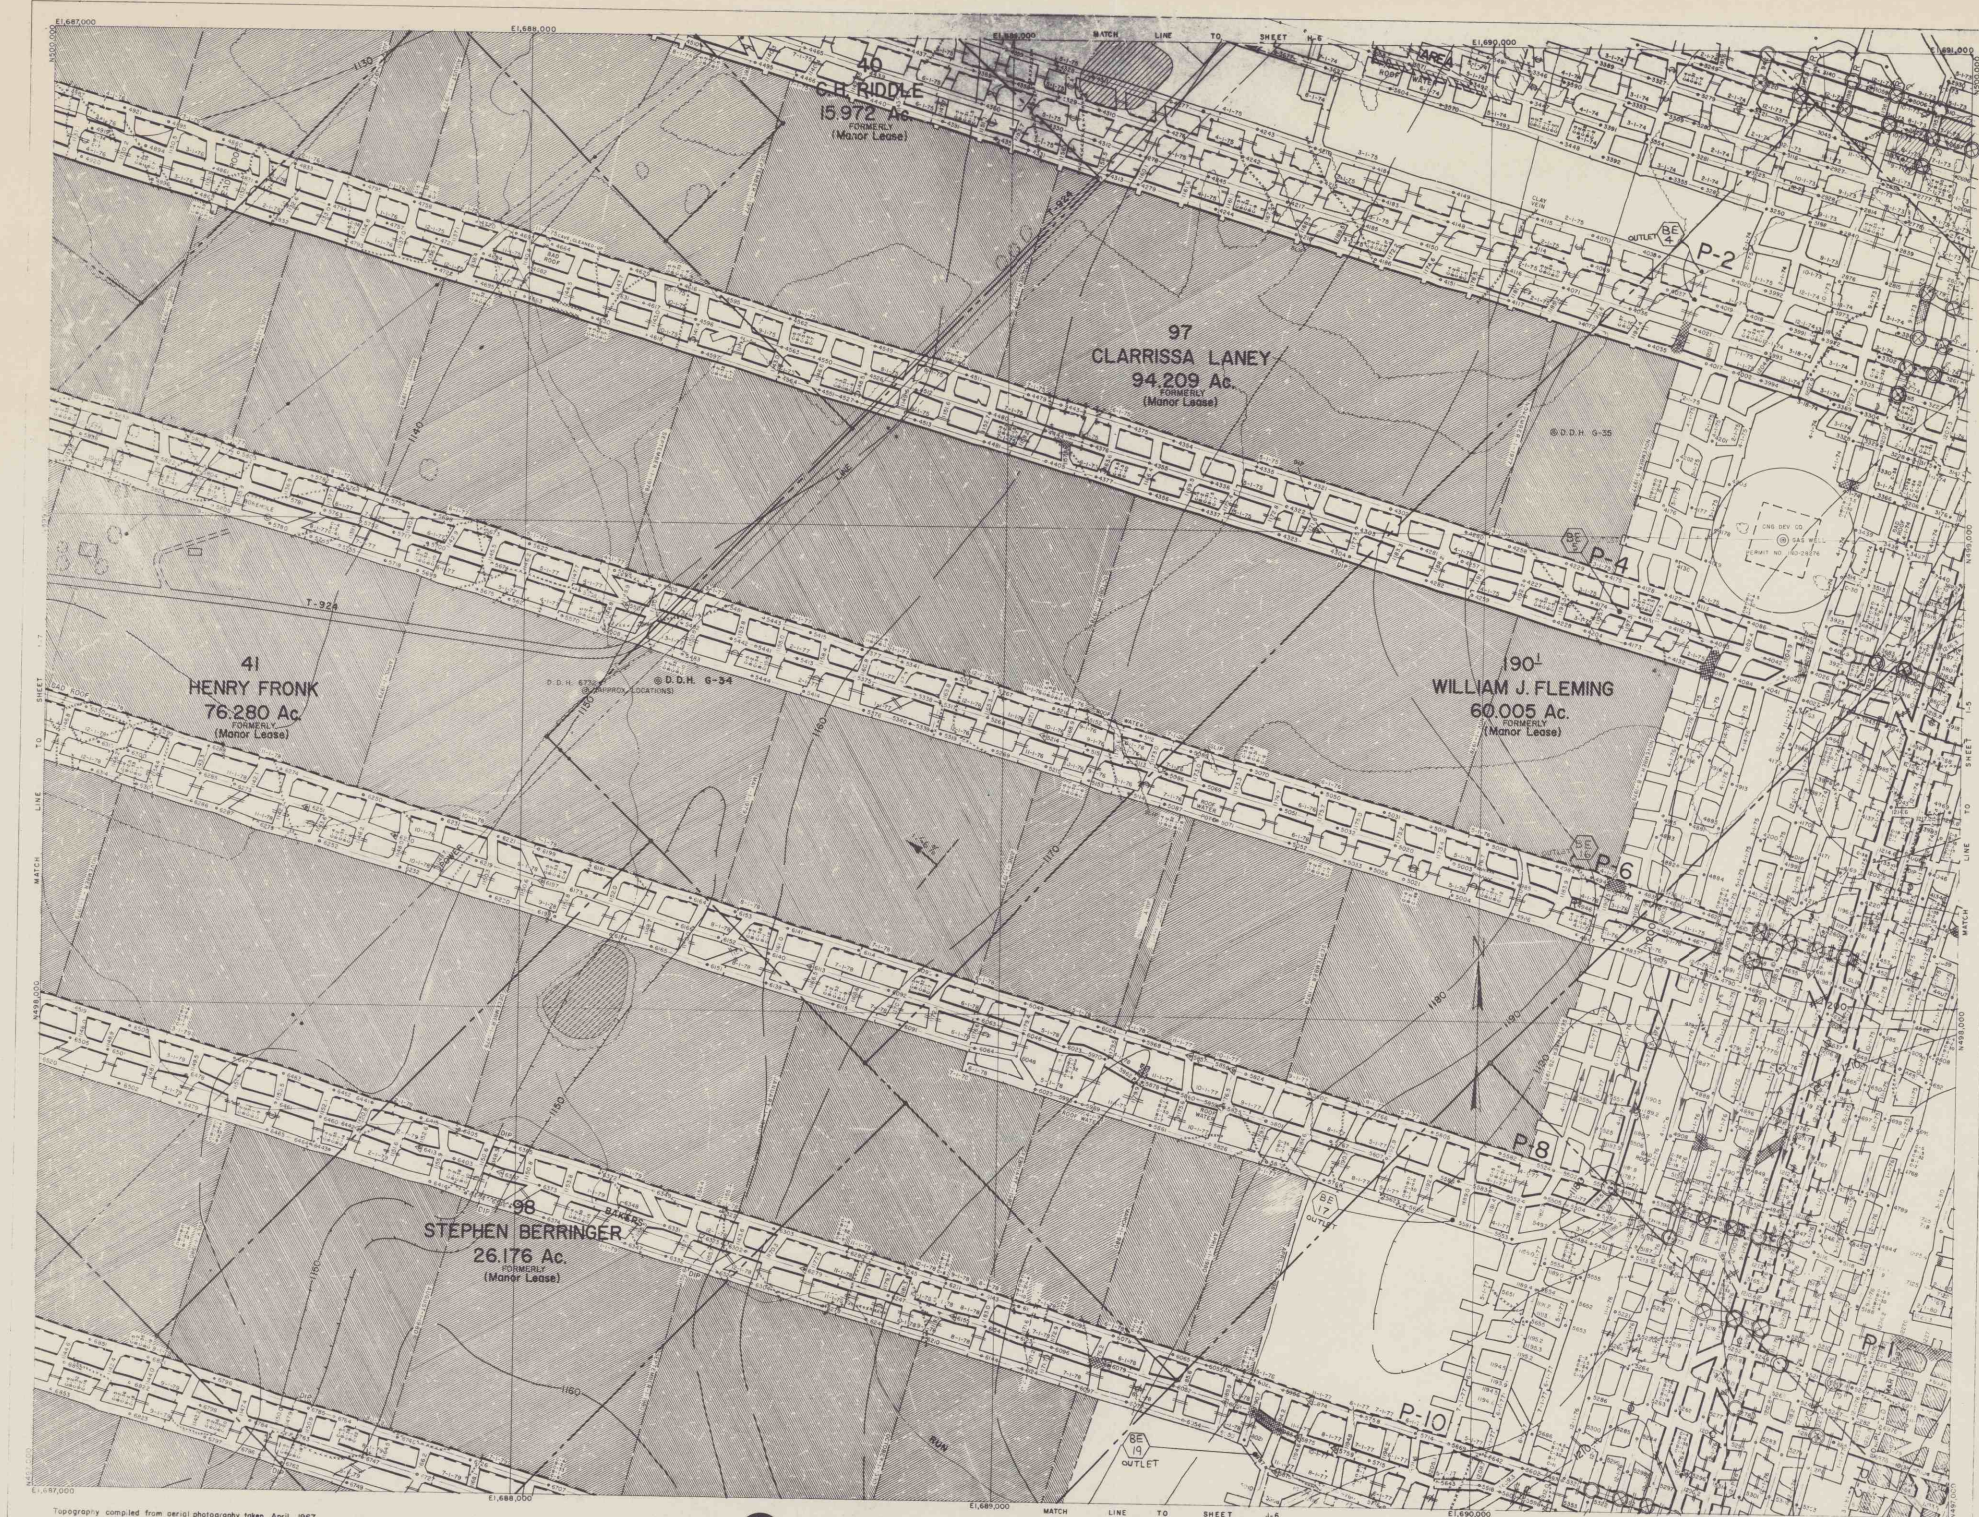

Topography compiled from aerial photography taken April, 1967
Aerial Map Service Co. Pittsburgh, Pennsylvania, Inc.



TOPOGRAPHIC MAP
GREENWICH
GOAL LANDS
SHEET 1-6
INDIANA & CAMBRIA COUNTIES