


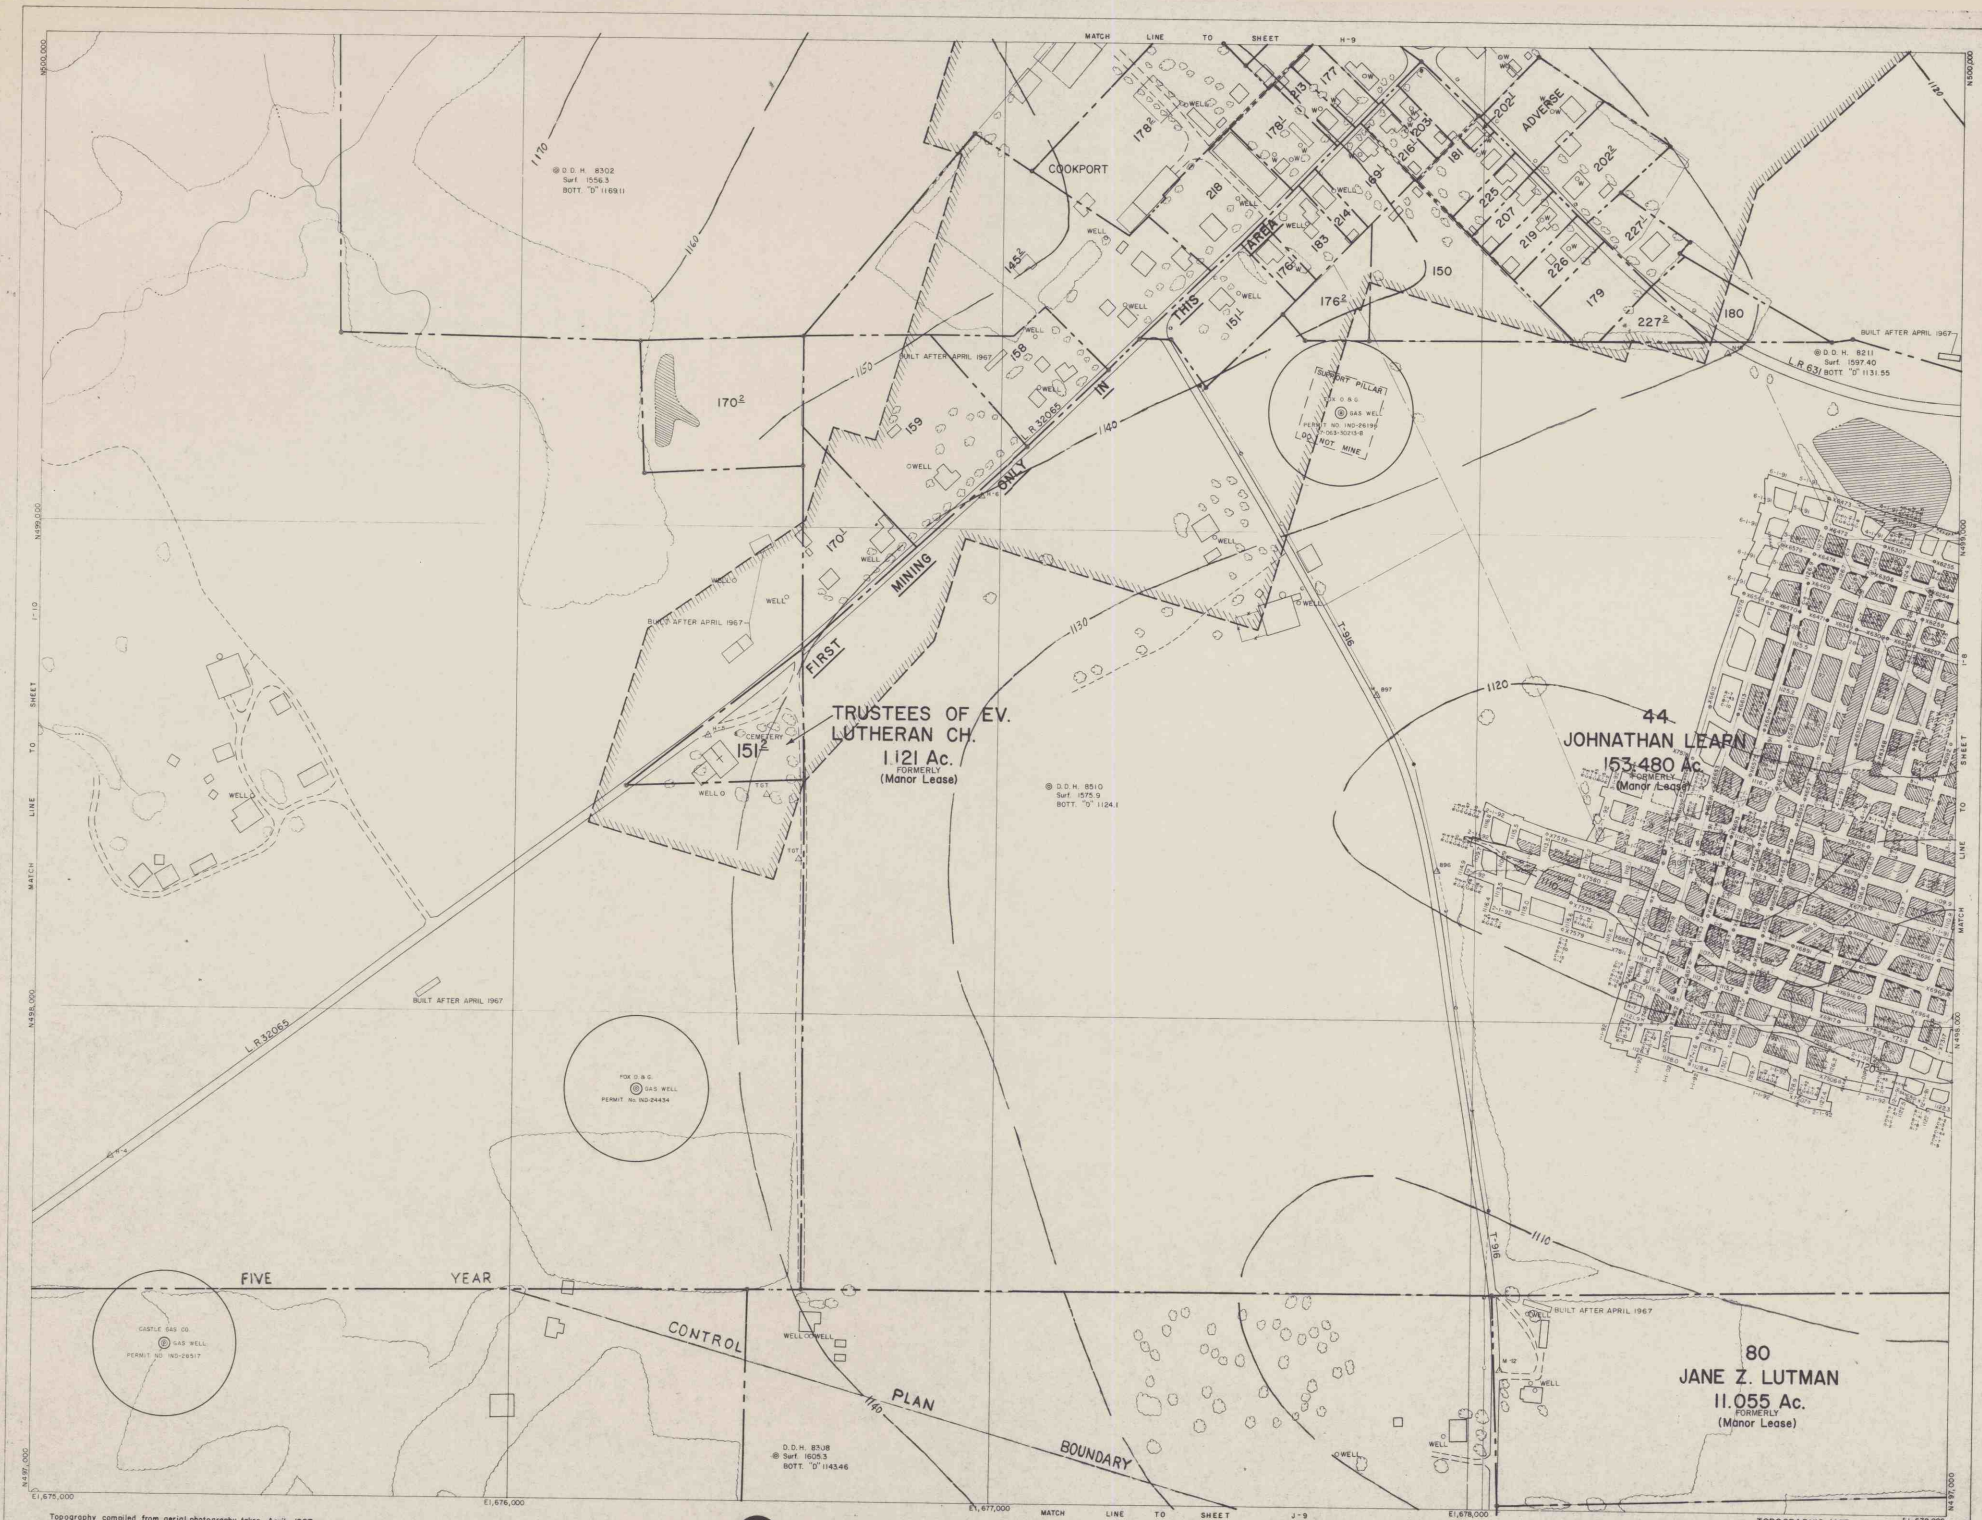

Topography compiled from aerial photography taken April, 1967
Aerial Map Service Co. Pittsburgh, Pennsylvania for

TOPOGRAPHIC MAP
GREENWICH
COAL LANDS
SCALE 1"=200'
SHEET 1-9
INDIANA & CAMBRIA COUNTIES

3-28-72