



FINAL MAP - MINE WORKINGS


GREENWICH COLLIERIES  
DIV. OF PA. MINES CORP.

NO. 2 MINE  
U.S.B.M. NO. 36-02404

GREEN & MONTGOMERY TOWNSHIPS, INDIANA COUNTY

MINE OPENED - FEBRUARY 1969  
CEASED MINING - March 27, 1992  
MINE CLOSED - May 8, 1992

SCALE



Topography compiled from aerial photography taken April, 1967  
Aerial Map Service Co. Pittsburgh, Pennsylvania for



MAIN COMPLEX U.S.B.M. No. 36-05031

GREENWICH COLLIERIES CO.  
MINE NO. 1 U.S.B.M. No. 36-02405-0  
MINE NO. 2 U.S.B.M. No. 36-02404-0  
Location - GREEN TWP. INDIANA CO., PA  
Address - Box 367 EBENSBURG, PA. 15931

TOPOGRAPHIC MAP  
GREENWICH  
COAL LANDS  
SCALE 1"=200' SHEET J-3  
INDIANA & CAMBRIA COUNTIES