


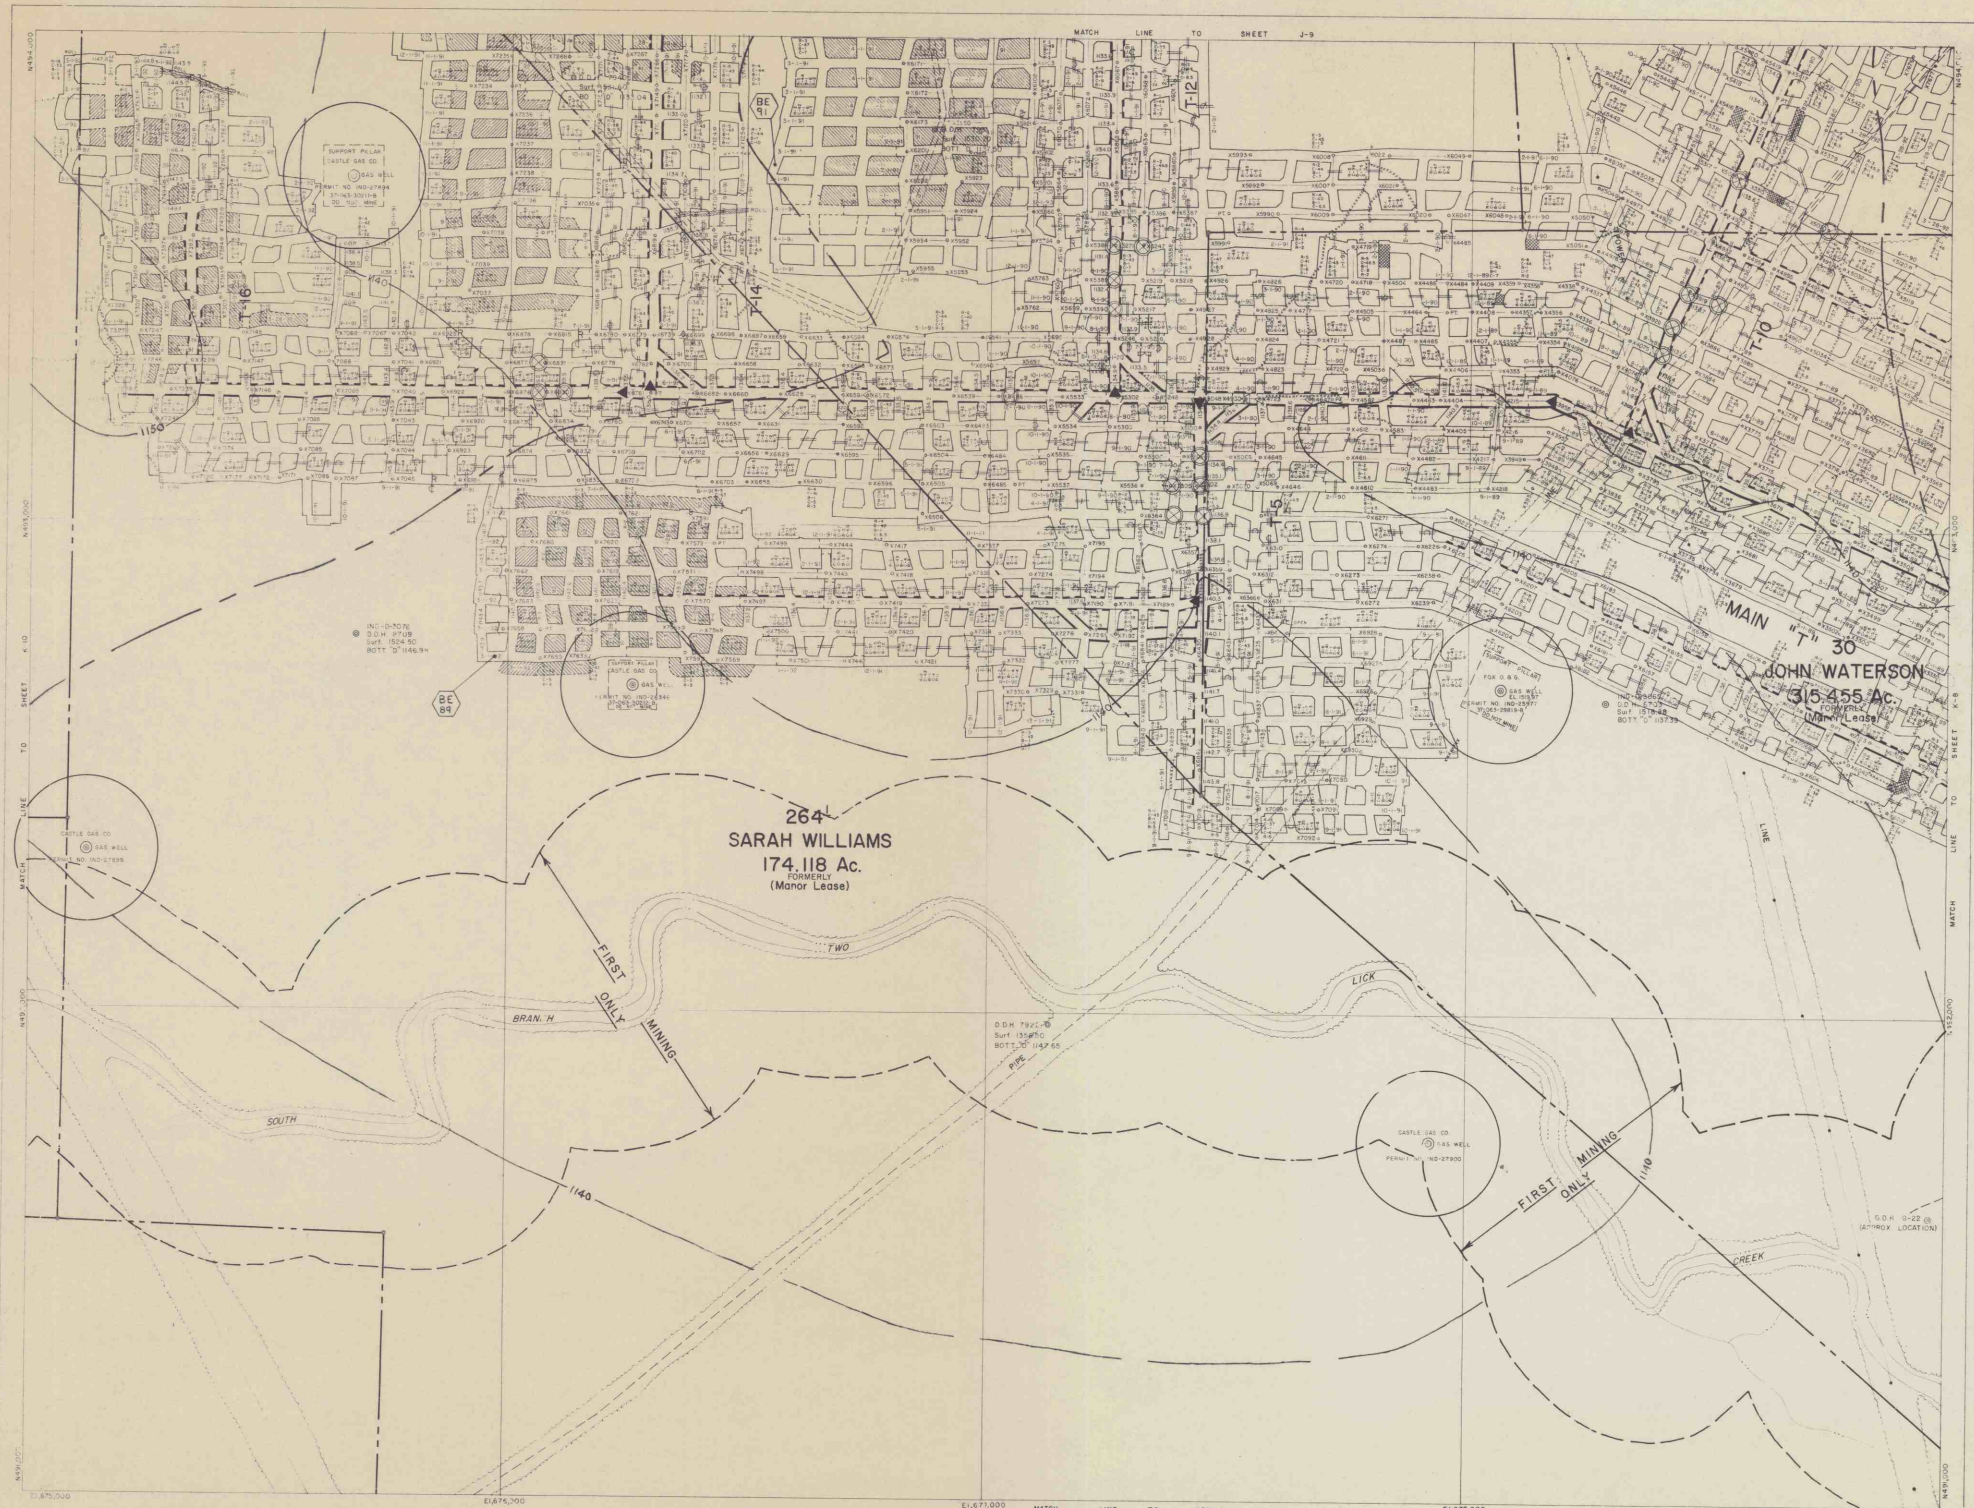

Topography compiled from aerial photography taken April, 1967
Aerial Map Service Co. Pittsburgh, Pennsylvania for



TOPOGRAPHIC MAP
GREENWICH
COAL LANDS
SCALE 1"=200' SHEET K-9
INDIANA & CAMBRIA COUNTIES

J-28-#2