


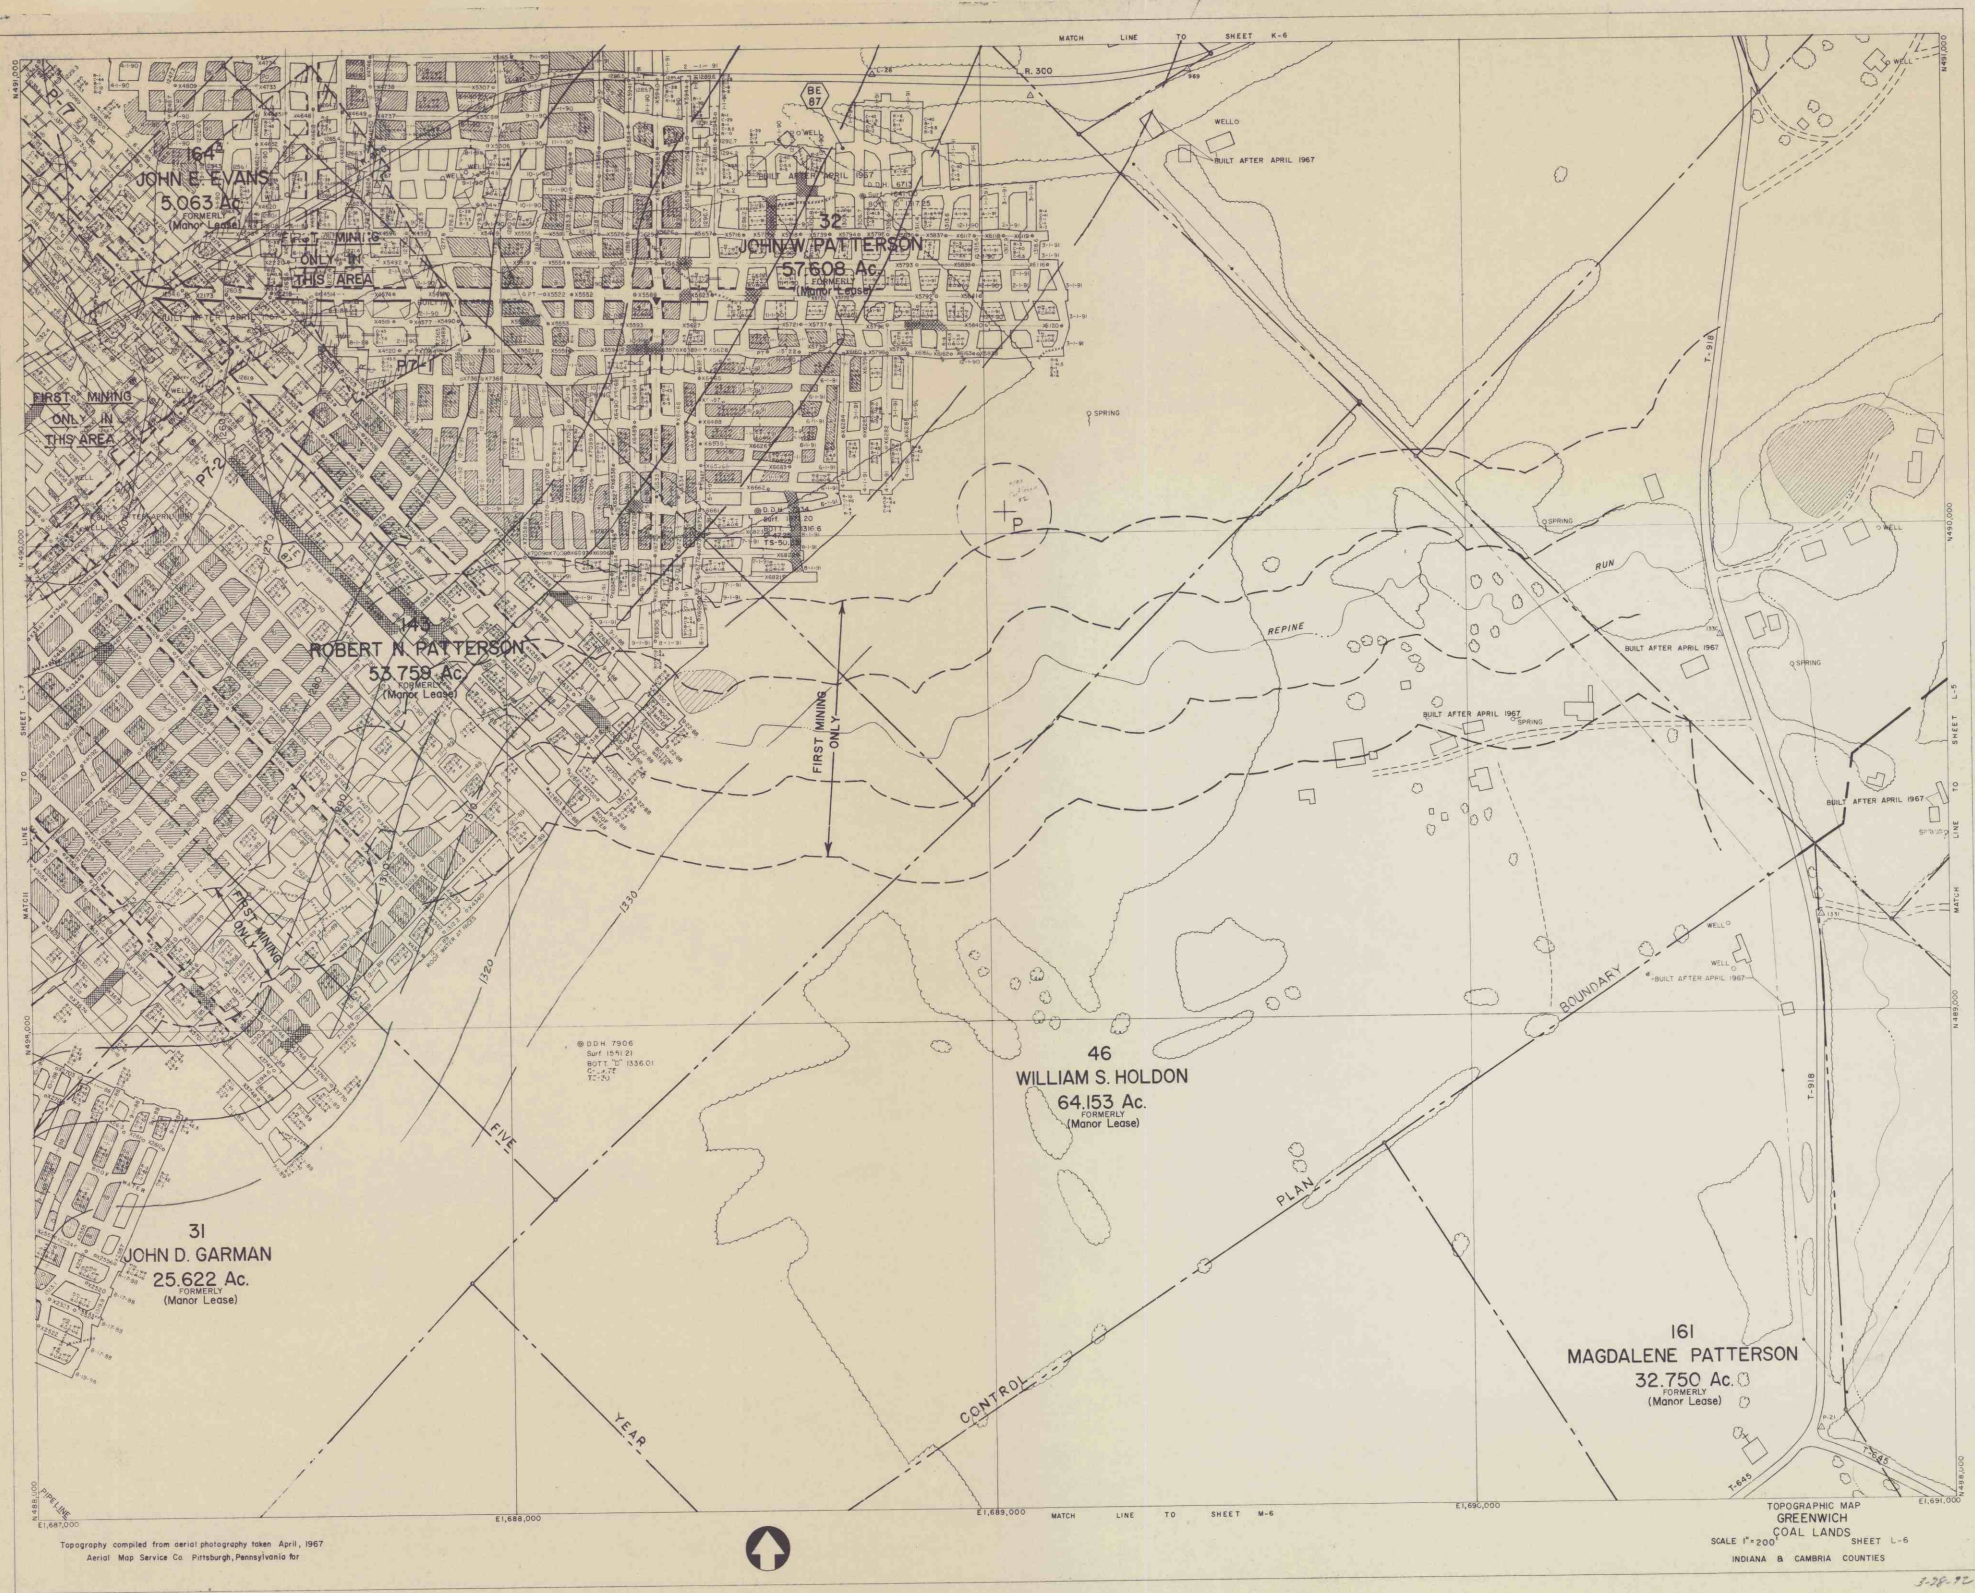

Topography compiled from aerial photography taken April, 1967
Aerial Map Service Co. Pittsburgh, Pennsylvania for

TOPOGRAPHIC MAP
GREENWICH
COAL LANDS
SCALE 1"=200' SHEET L-6
INDIANA & CAMBRIA COUNTIES

5-28-92