


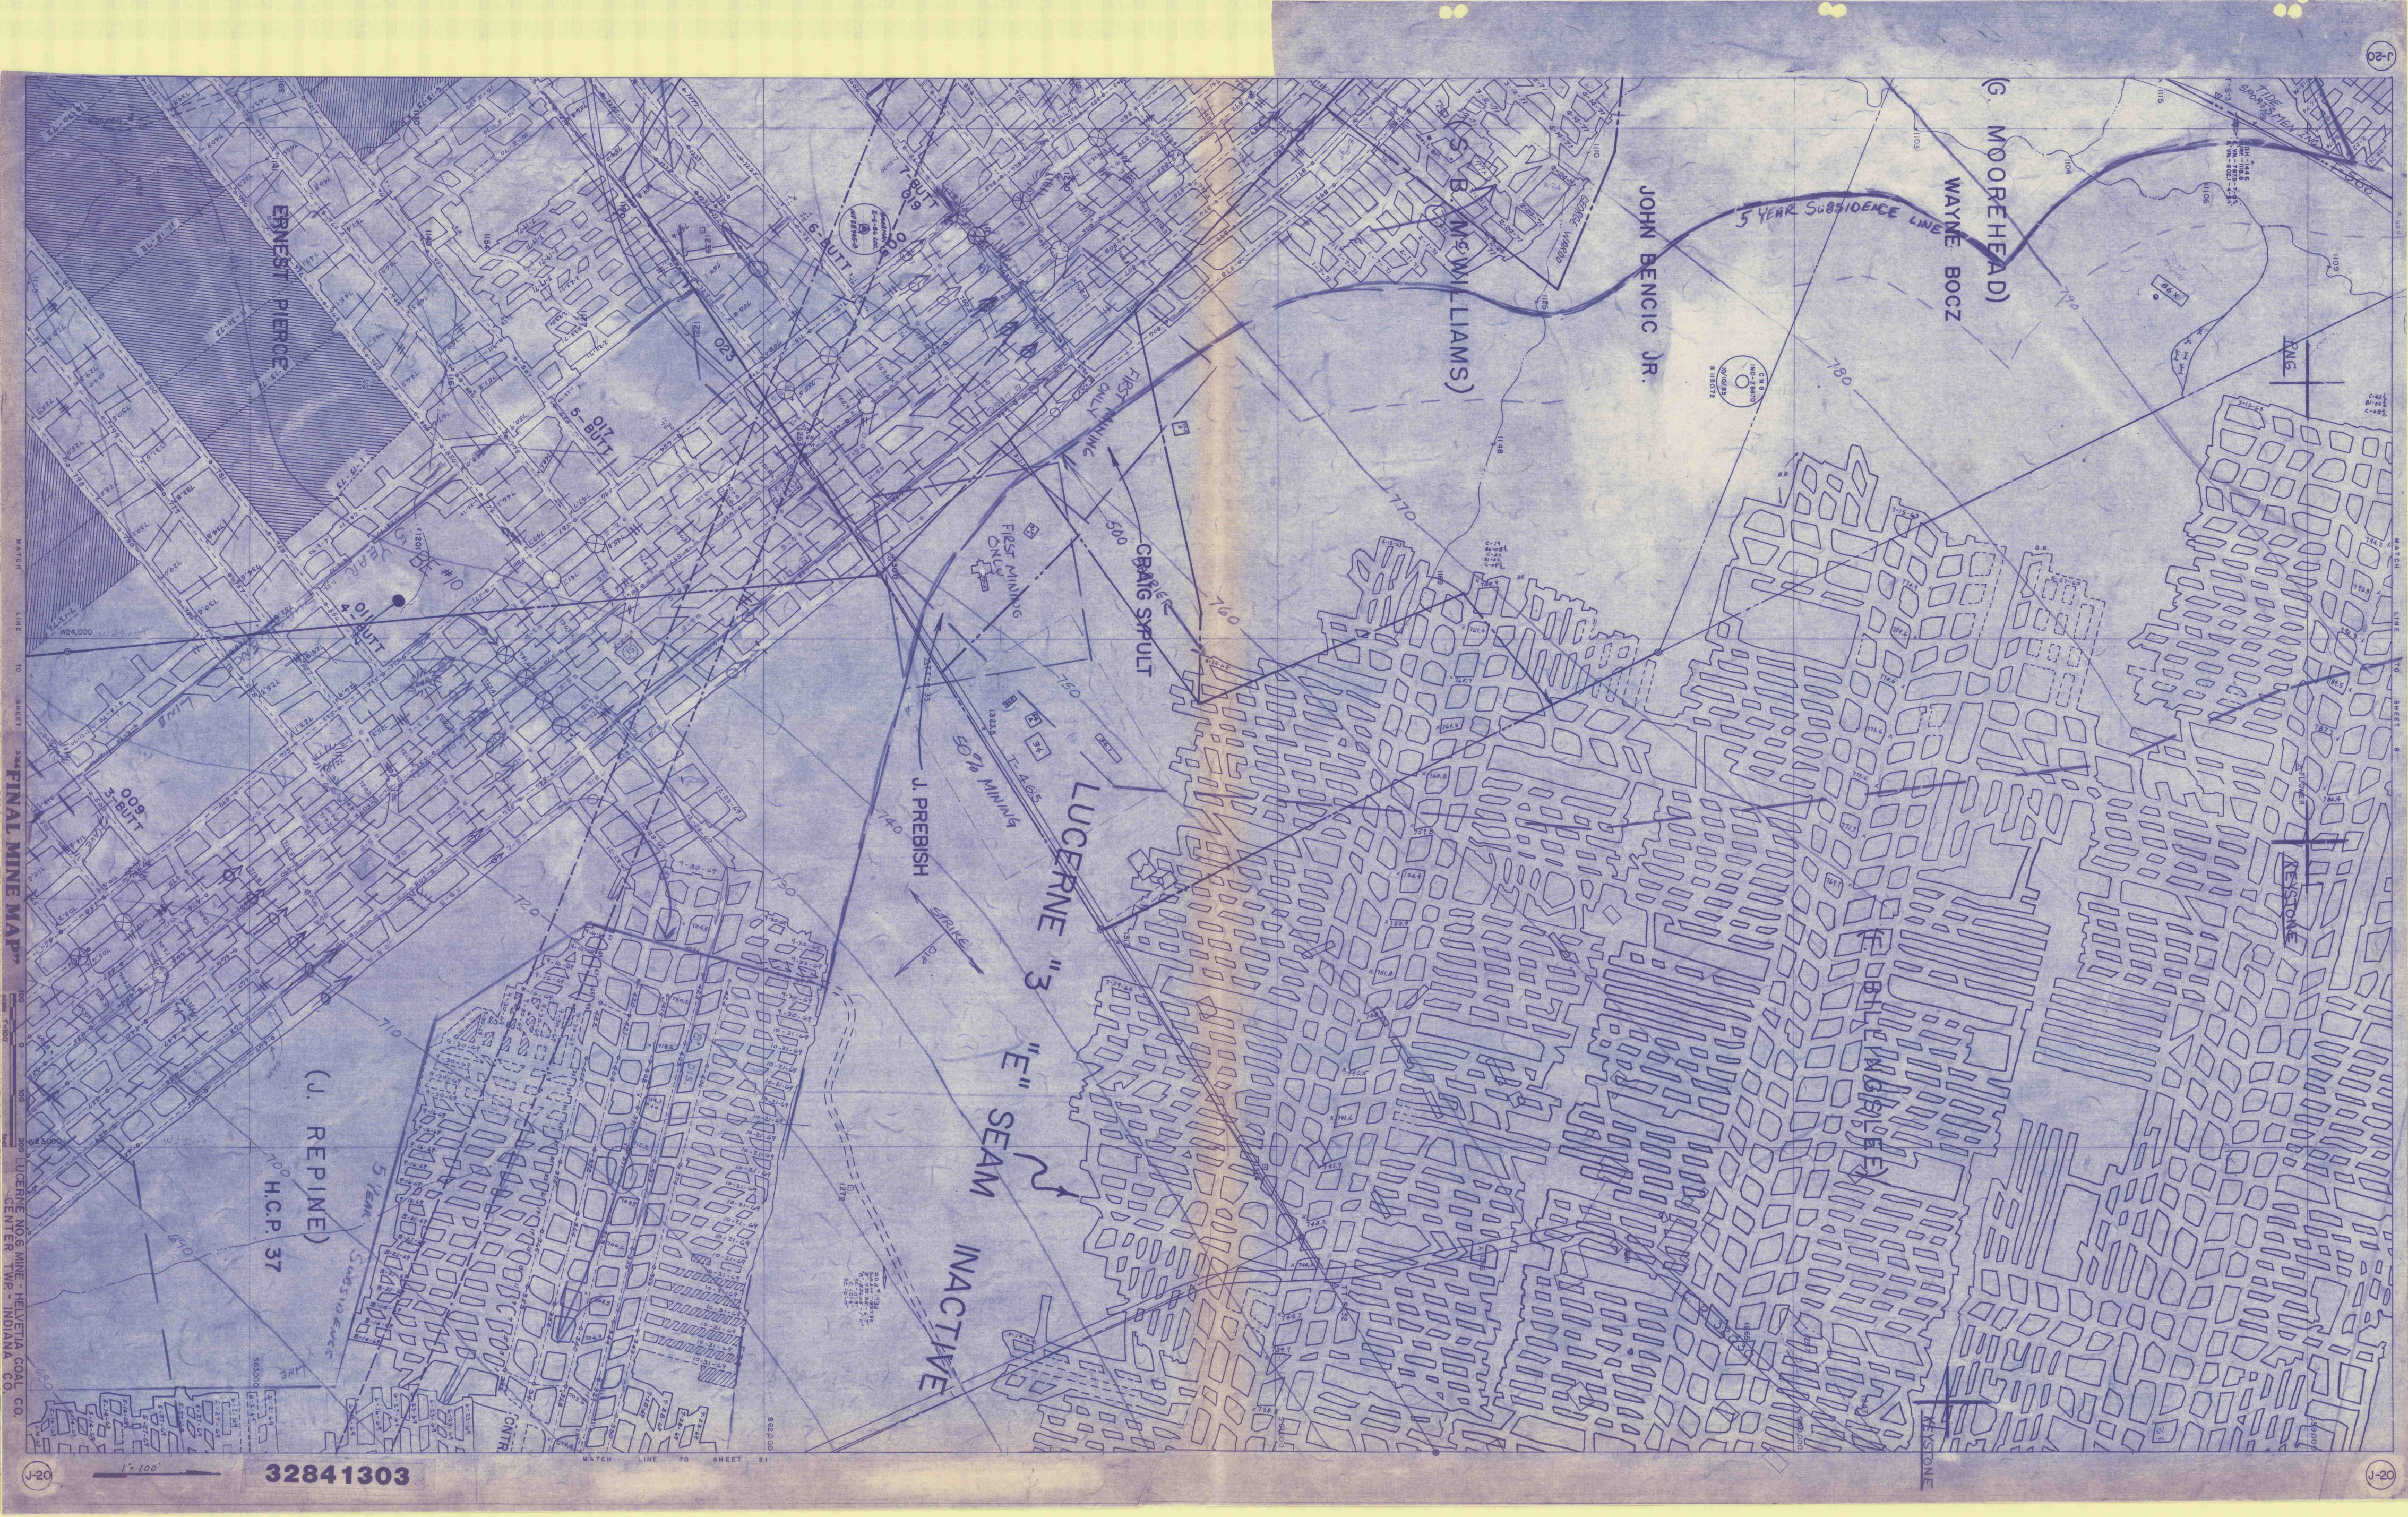

32841303